

B.1 C-07 DRAWINGS AND PHOTOS (6 pages)

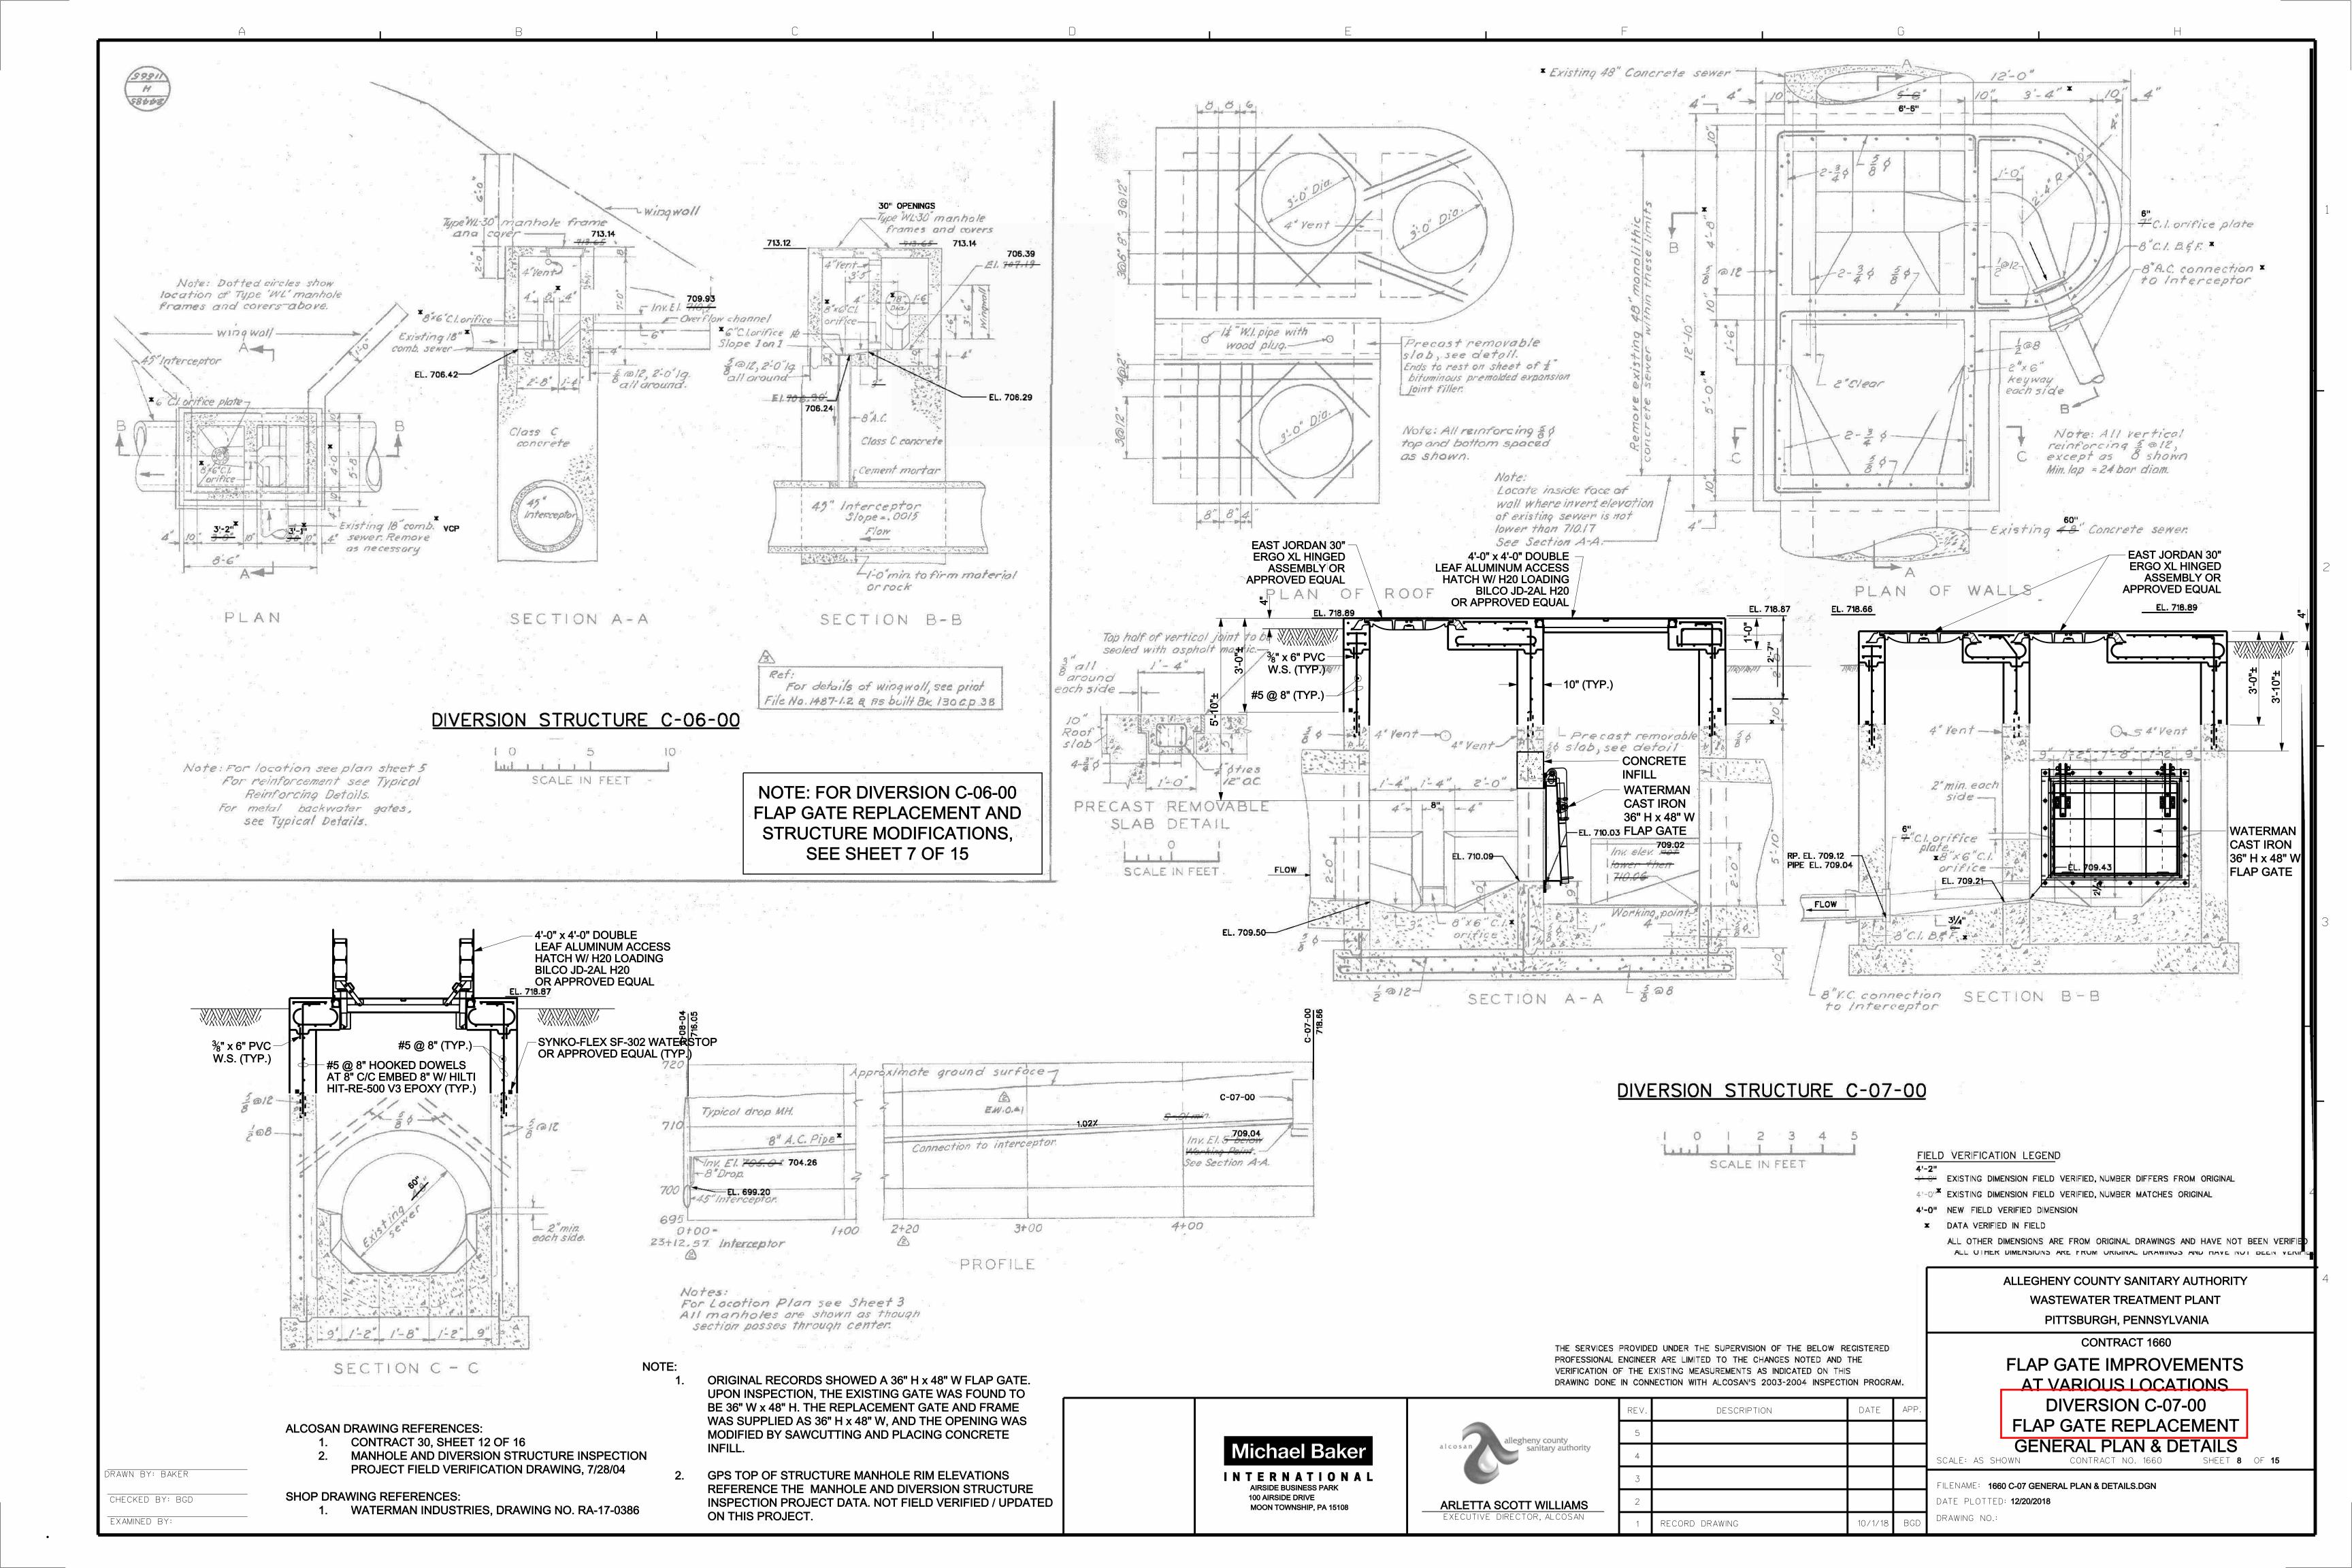


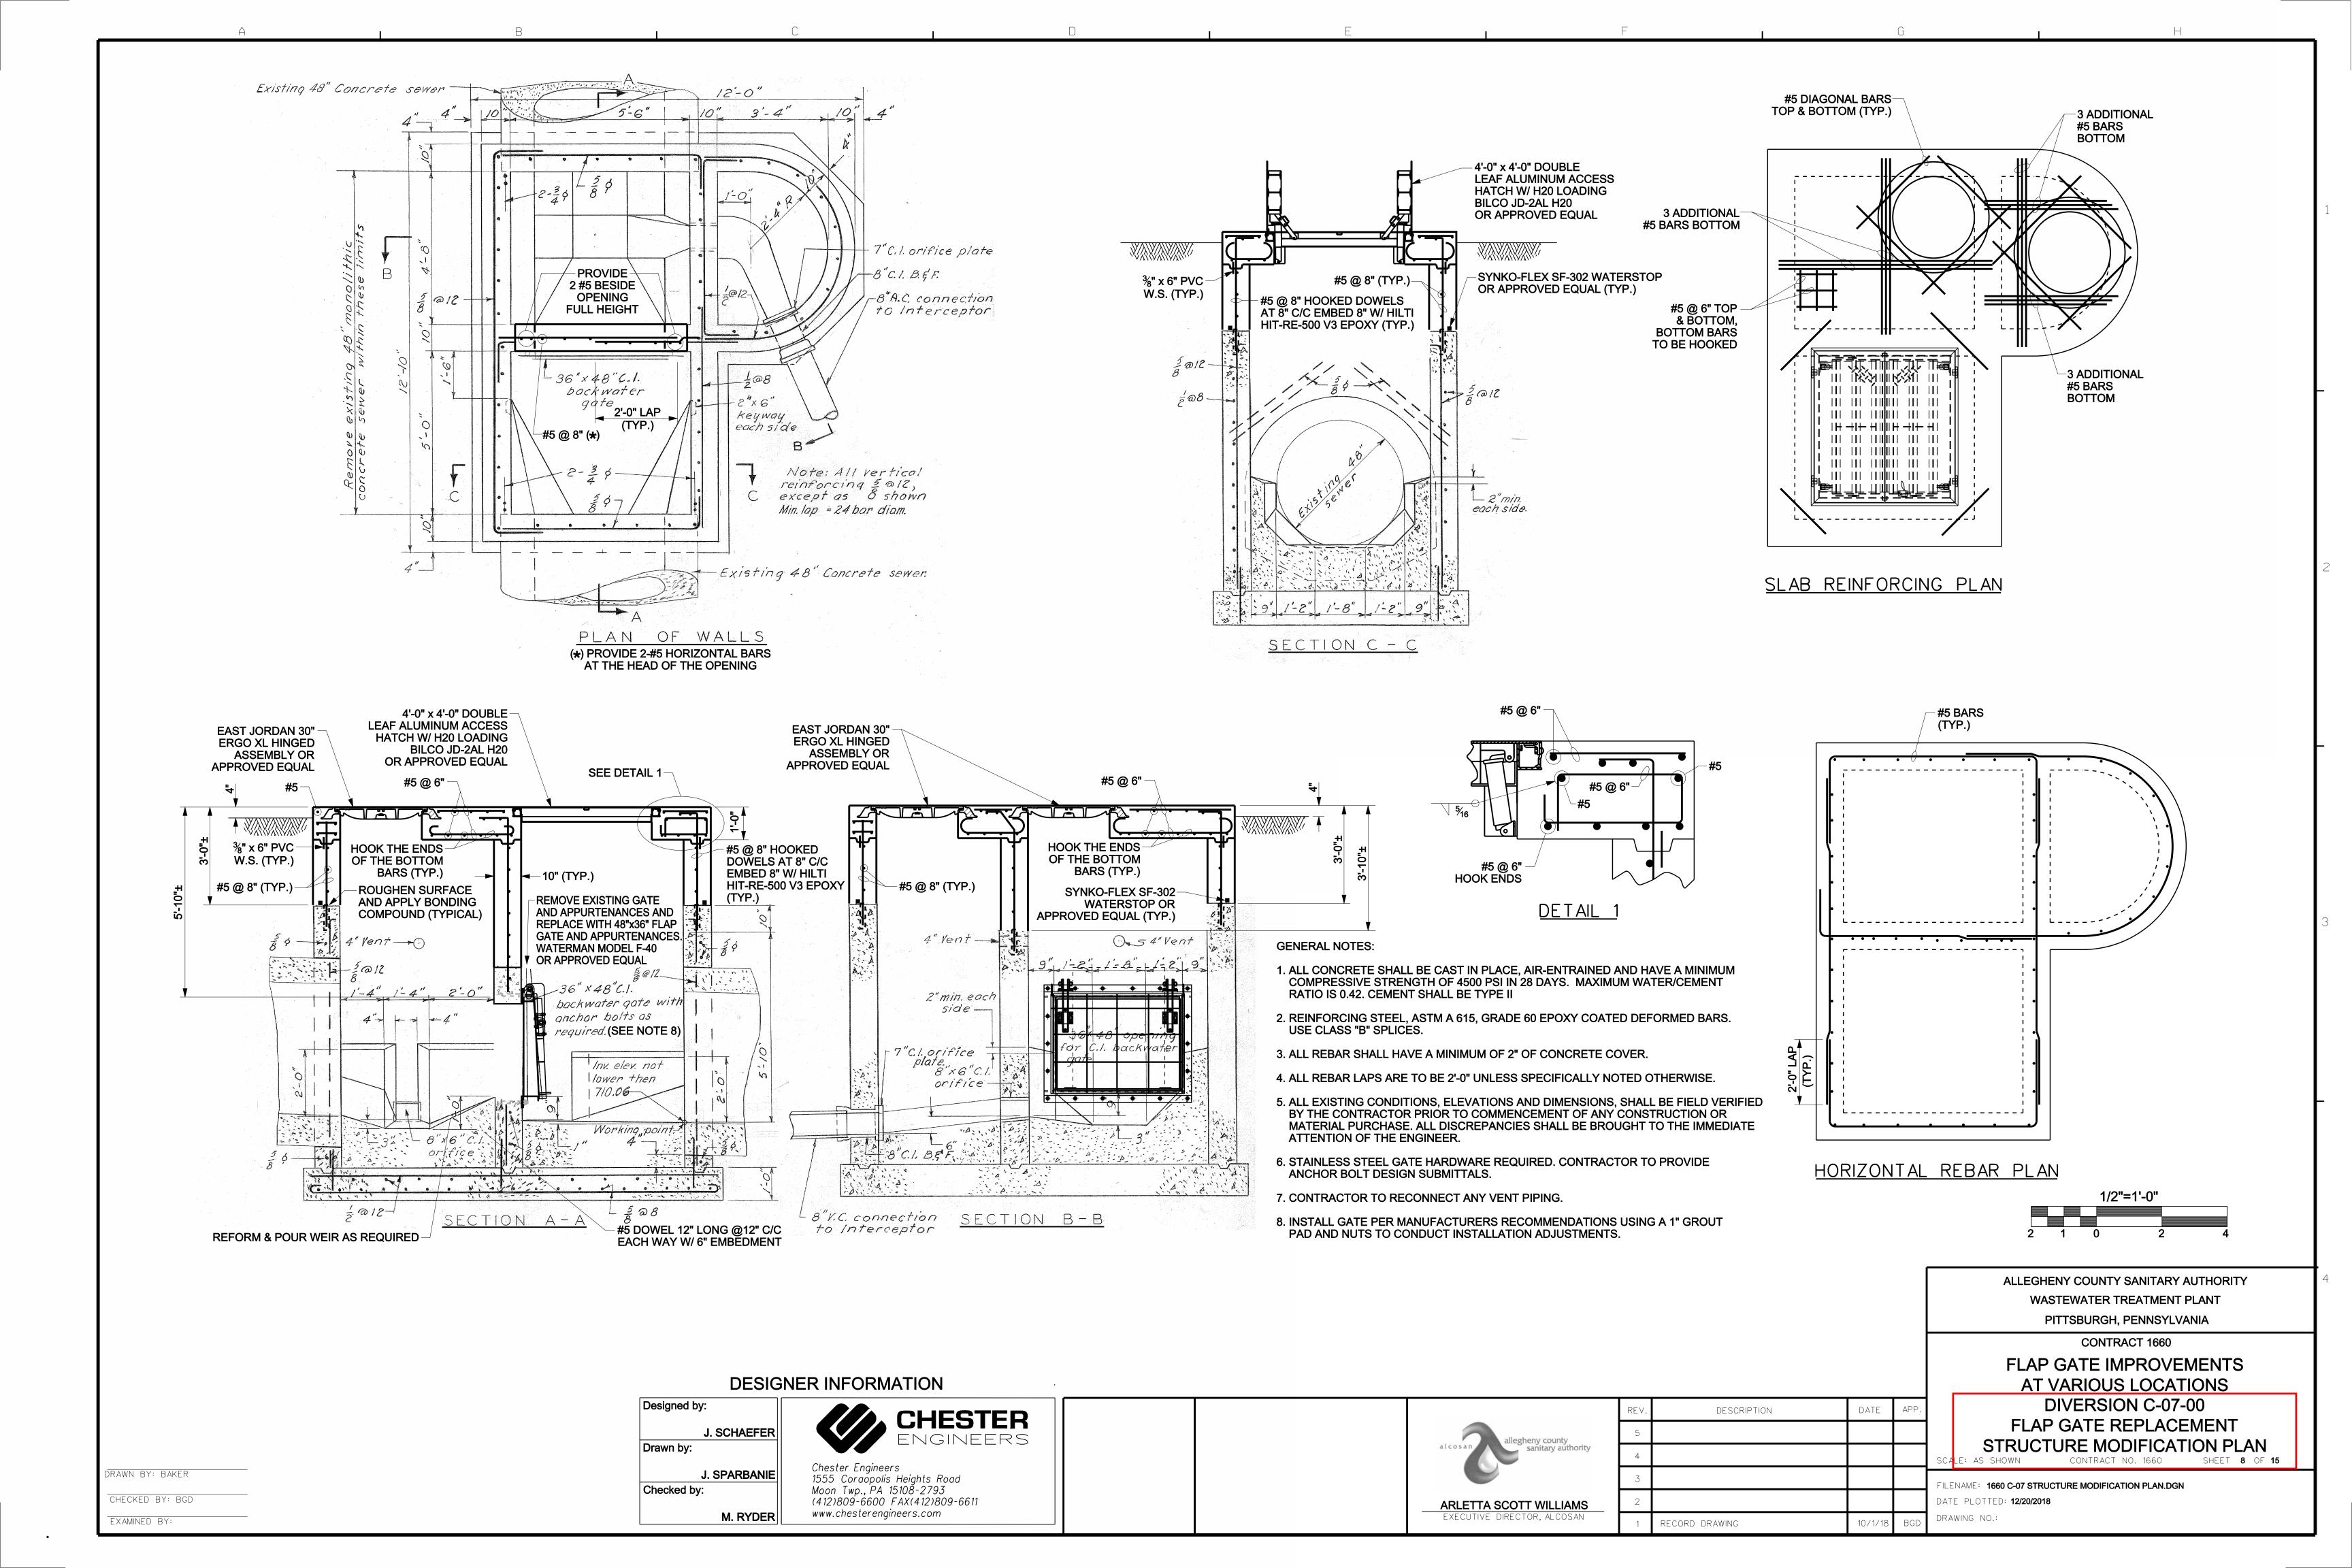

Submittal Information Covering

Cast Iron Flap Valve

Manufacture: Waterm	nan	
Type/Model:	F-40	F-20
Size:	48x36	18x18
Provide or Confirm	48x36 at C-07-00	18x18 at M-53-00
Invert elevation	710.89 +/-	
Top of wall elevation	715.89 +/-	
Seating Head:	7.8'	
Unseating Head:	0.25'	
Wall Thickness:	10"	

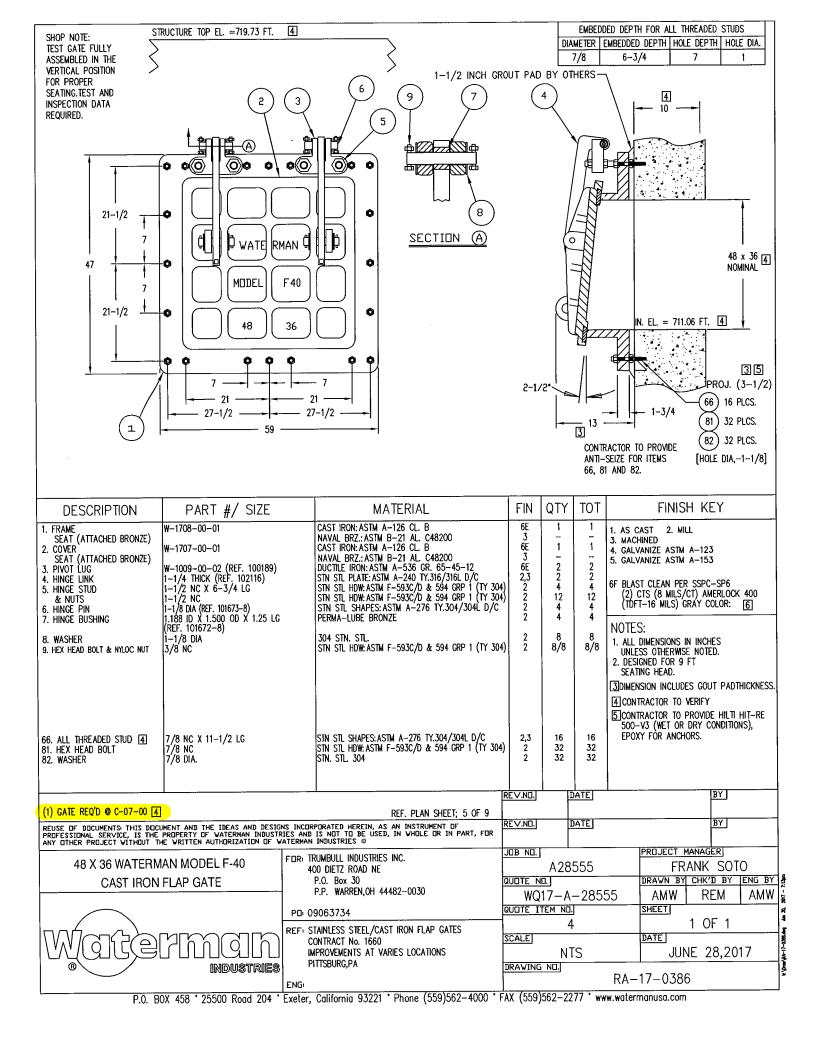





B.2 A-60 DRAWINGS AND PHOTOS (7 pages)

GENERAL STRUCTURAL NOTES:

- 1. ROUGHEN ALL AREAS WHERE NEW CONCRETE IS TO BE APPLIED, AIR BLAST ALL AREAS WITH OIL-FREE COMPRESSED AIR TO PROTECT AGAINST ANY CONTAMINANT DETRIMENTAL TO THE BOND OF THE NEW CONCRETE. APPLY EPOXY BONDING COMPOUND TO THE ROUGHENED AREA. WHILE THE EPOXY BONDING COMPOUND IS STILL TACKY, PLACE 3000PSI CEMENT CONCRETE . DO NOT PLACE CONCRETE IF THE COMPOUND IS NO LONGER TACKY OR IF THE COMPOUND HAS HARDENED. RECOAT ANY COMPOUND THAT IS NO LONGER TACKY. WIRE BRUSH OR SANDBLAST ANY COMPOUND THAT HAS HARDENED AND RECOAT AREA.
- 2. REPAIR ANY CONCRETE DAMAGED DURING THE OPERATIONS TO THE SATISFACTION OF THE REPRESENTATIVE AT NO COST TO THE OWNER.
- 3. PROVIDE MINIMUM 2" CONCRETE COVER OVER REINFORCING BARS.
- 4. PROVIDE HYDROPHYLLIC WATERSTOP AT ALL JOINTS BETWEEN NEW AND EXISTING CONCRETE.
- 5. BUILD-OUTS SHALL HAVE A 7 DAY COMPRESSIVE STRENGTH OF 3,000 PSI. GATES ARE NOT ALLOWED TO BE HUNG/INSTALLED IF THE COMPRESSIVE STRENGTH IS LESS THAN 3,000 PSI.

ALCOSAN DRAWING REFERENCES:


1. CONTRACT 47, SHEETS 30 & 31 DATED 3-31-1954

SHOP DRAWING REFERENCES:

- SUBMITTAL NO. SDS 22 REINFORCING STEEL
- SUBMITTAL NO. SDS 23 BENDING DIAGRAMS SUBMITTAL NO. SDS - 25 CONCRETE BONDING AGENTS
- 4. SUBMITTAL NO. SDS 28 CIP CONCRETE MIX DESIGN
- SUBMITTAL NO. SDS 31 CONCRETE CURING COMPOUND SUBMITTAL NO. SDS - 41 A-60 LOWER GATE
- SUBMITTAL NO. SDS 50 HEAVY DUTY FLAP GATES A-31, A-41, A-68, A-60u & M-45
- 8. SUBMITTAL NO. SDS 55 HEAVY DUTY FLAP GATES

NOTE: SEE TYPICAL HEAVY DUTY GATE DETAIL ON SHEET 3 FOR MOUNTING DETAILS



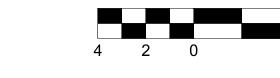

1/4"=1'-0"

60" X 36" HEAVY DUTY

APPROVED EQUAL


RODNEY HUNT FV-AR OR

FLAP GATE, RODNEY HUNT A-612

FLAP GATE

96" X 96 FABRICATED

OR APPROVED EQUAL

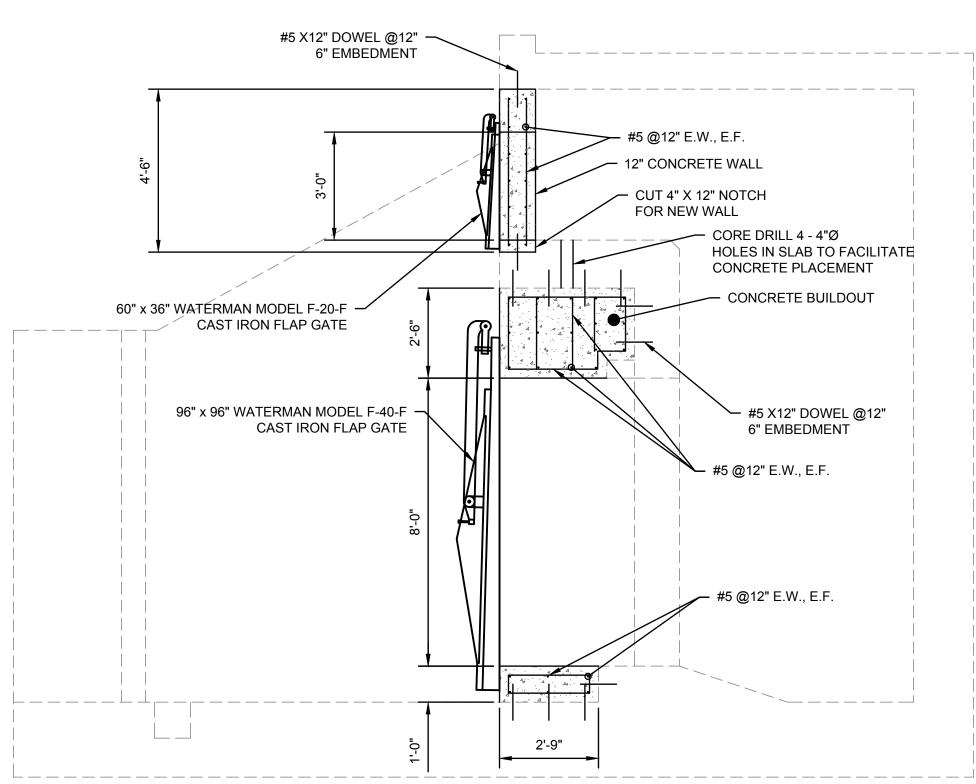


SECTIONAL ELEVATION SCALE: 3/8"=1'-0"

#5 X12" DOWEL @12" 6" EMBEDMENT #5 @12" E.W., E.F. GATE NOT SHOWN FOR CLARITY 5'-0" - CORE DRILL 4 - 4"Ø HOLES IN SLAB TO FACILITATE CONCRETE PLACEMENT (TYP.) - #5 @12" E.W., E.F. #5 X12" DOWEL @12" 6" EMBEDMENT **GATE NOT SHOWN** FOR CLARITY 8'-0" 1'-0"

> **ELEVATION** SCALE: 3/8"=1'-0"

NOTES:

- 1. DIVERSION STRUCTURE BACKGROUND AND INFORMATION SHOWN BASED ON RECORD DRAWINGS - ALCOSAN CONTRACT 47 SHEET 30 OF 50 ALLEGHENY RIVER, OHIO RIVER TO MILLVALE, DIVERSION STRUCTURE ON SPRING GARDEN AVENUE SEWER, PART 1 DATED MARCH 31, 1954 - AND DO NOT NECESSARILY REFLECT EXISTING CONDITIONS. CONTRACTOR SHALL FIELD VERIFY ALL MEASUREMENTS AND REVIEW SITE FOR ANY AND ALL OBSTACLES PRIOR TO ORDERING EQUIPMENT, MATERIAL AND APPURTENANCES.
- 2. DRAWING REFERENCES DISPLAYED ON RECORD DRAWING BACKGROUND IMAGES (SECTION CALLOUTS, DETAIL CALLOUTS, ETC.) ARE NOT APPLICABLE TO THIS PLAN SET. DRAWING REFERENCES FOR THE CURRENT PLAN SET ONLY SHALL BE UTILIZED.
- 3. EXISTING EQUIPMENT, PIPING, FITTINGS, AND APPURTENANCES SHALL BE DEMOLISHED ACCORDING TO PLANS AND SPECIFICATIONS.
- 4. ALL WALL PENETRATIONS RELATED TO DEMOLITION SHALL BE SEALED WATERTIGHT W/ NON-SHRINK GROUT.
- 5. ALL DEMOLISHED MATERIAL BECOMES THE PROPERTY OF THE CONTRACTOR UNLESS OTHERWISE NOTED ON THE DRAWINGS OR IN THE PROJECT MANUAL.
- 6. CONTRACTOR TO PROVIDE FOR ALL DEWATERING MEASURES NECESSARY FOR COMPLETION OF THE WORK. THIS SHALL INCLUDE DRIVING SHEET PILING OR OTHER APPROVED DEWATERING METHODS.
- 7. CONTRACTOR SHALL CLEAN OUT ALL DEBRIS IN FRONT OF AND BEHIND GATE.

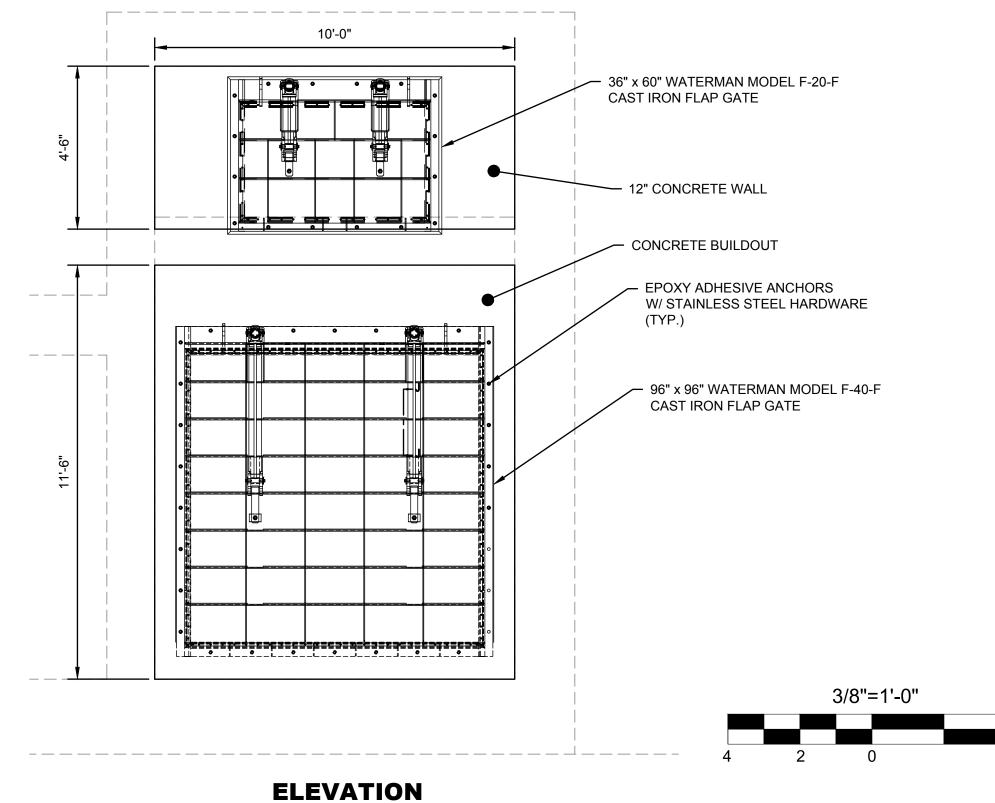


SCALE: 3/8"=1'-0"

RECORD DRAWING

Designed by:	REVISION				
	REV No.	DATE	DESCRIPTION	APPV	
J LESON	Λ				
Drawn by:					
J RAMPELLO					
Checked by:					
C IODDANI					
C JORDAN					

ISSUED FOR BIDS

Prepared By ms consultants inc. engineers * architects * planners

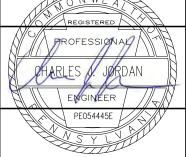



ARLETTA SCOTT WILLIAMS EXECUTIVE DIRECTOR, ALCOSAN

12" CONCRETE WALL

CUT 4" X 12" NOTCH

CONCRETE WALL

BUILDOUT

FOR WALL

3300 PREBLE AVE. PITTSBURGH, PENNSYLVANIA PITTSBURGH, PA 15233 (412) 766 - 4810


ALLEGHENY COUNTY SANITARY AUTHORITY REGIONAL CONVEYANCE SYSTEM 2020 FLAP GATE REPLACEMENT PROJECT AT VARIOUS LOCATIONS


SHEET - 015 DIVERSION STRUCTURE A-60 SECTIONS


Contract: 1724 CAD File Name: MHPS-A-60-005.DWG Date: 01/29/2021 Sheet:

15 of 34



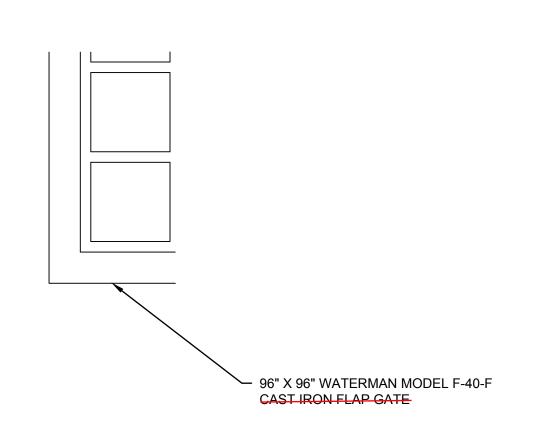

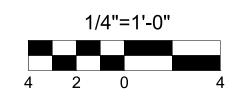

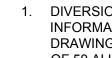

NOTES:

- 60" X 36" WATERMAN MODEL F-20-F

— 96" X 96" WATERMAN MODEL F-40-F

CAST IRON FLAP GATE

CAST IRON FLAP GATE

- CONCRETE BUILDOUT

CONCRETE WALL IN EXISTING OPENING

- 1. DIVERSION STRUCTURE BACKGROUND AND INFORMATION SHOWN BASED ON RECORD DRAWINGS - ALCOSAN CONTRACT 47 SHEET 30 OF 50 ALLEGHENY RIVER, OHIO RIVER TO MILLVALE, DIVERSION STRUCTURE ON SPRING GARDEN AVENUE SEWER, PART 1 DATED MARCH 31, 1954 - AND DO NOT NECESSARILY REFLECT EXISTING CONDITIONS. CONTRACTOR SHALL FIELD VERIFY ALL MEASUREMENTS AND REVIEW SITE FOR ANY AND ALL OBSTACLES PRIOR TO ORDERING EQUIPMENT, MATERIAL AND APPURTENANCES.
- 2. DRAWING REFERENCES DISPLAYED ON RECORD DRAWING BACKGROUND IMAGES (SECTION CALLOUTS, DETAIL CALLOUTS, ETC.) ARE NOT APPLICABLE TO THIS PLAN SET. DRAWING REFERENCES FOR THE CURRENT PLAN SET ONLY SHALL BE UTILIZED.
- 3. EXISTING EQUIPMENT, PIPING, FITTINGS, AND APPURTENANCES SHALL BE DEMOLISHED ACCORDING TO PLANS AND SPECIFICATIONS.
- 4. ALL WALL PENETRATIONS RELATED TO DEMOLITION SHALL BE SEALED WATERTIGHT W/ NON-SHRINK GROUT.
- 5. ALL DEMOLISHED MATERIAL BECOMES THE PROPERTY OF THE CONTRACTOR UNLESS OTHERWISE NOTED ON THE DRAWINGS OR IN THE PROJECT MANUAL.
- 6. CONTRACTOR TO PROVIDE FOR ALL DEWATERING MEASURES NECESSARY FOR COMPLETION OF THE WORK. THIS SHALL INCLUDE DRIVING SHEET PILING OR OTHER APPROVED DEWATERING METHODS.
- 7. CONTRACTOR SHALL CLEAN OUT ALL DEBRIS IN FRONT OF AND BEHIND GATE.

ALCOSAN DRAWING REFERENCES: 1. CONTRACT 47, SHEETS 30 & 31 DATED 3-31-1954

SHOP DRAWING REFERENCES:

- 1. SUBMITTAL NO. SDS 22 REINFORCING STEEL 2. SUBMITTAL NO. SDS - 23 BENDING DIAGRAMS
- 3. SUBMITTAL NO. SDS 25 CONCRETE BONDING AGENTS
- 4. SUBMITTAL NO. SDS 28 CIP CONCRETE MIX DESIGN
- 5. SUBMITTAL NO. SDS 31 CONCRETE CURING COMPOUND 6. SUBMITTAL NO. SDS - 41 A-60 LOWER GATE
- 7. SUBMITTAL NO. SDS 50 HEAVY DUTY FLAP GATES A-31, A-41, A-68, A-60u & M-45
- 8. SUBMITTAL NO. SDS 55 HEAVY DUTY FLAP GATES

1/2"=1'-0"


RECORD DRAWING

REVISION Designed by: REV No. DATE DESCRIPTION APPV J LESON Drawn by: J RAMPELLO Checked by: C JORDAN

ISSUED FOR BIDS

Prepared By ms consultants inc. engineers * architects * planners



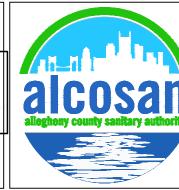

ARLETTA SCOTT WILLIAMS EXECUTIVE DIRECTOR, ALCOSAN

3300 PREBLE AVE. PITTSBURGH, PENNSYLVANIA PITTSBURGH, PA 15233 (412) 766 - 4810

ALLEGHENY COUNTY SANITARY AUTHORITY REGIONAL CONVEYANCE SYSTEM 2020 FLAP GATE REPLACEMENT PROJECT AT VARIOUS LOCATIONS

> **SHEET - 016** DIVERSION STRUCTURE A-60 SECTIONS

1724 CAD File Name: MHPS-A-60-006.DWG Date: 01/29/2021 Sheet:

16 of 34

Contract:

STRUCTURAL CALCULATIONS FOR:

WATERMAN VALVE, LLC

ACCEPTED FOR A-60 LOWER 25500 Road 204

Exeter, CA 93221

Waterman Job # A33686 RB-21 -0496 - 96 x 96 SSF-43-F Flap Gate Allegheny County Sanitary Authority Allegheny, PA

BROOKS-RANSOM ASSOCIATES

STRUCTURAL ENGINEERS CIVIL ENGINEERS WWW.BROOKSRANSOM.COM






7415 NORTH PALM, SUITE 100 FRESNO, CALIFORNIA 93711 OFFICE: (559)449-8444 FAX: (559) 449-8404

> Joв#22115 2021-05-13



Reviewed for conformance with generally accepted engineering practice and

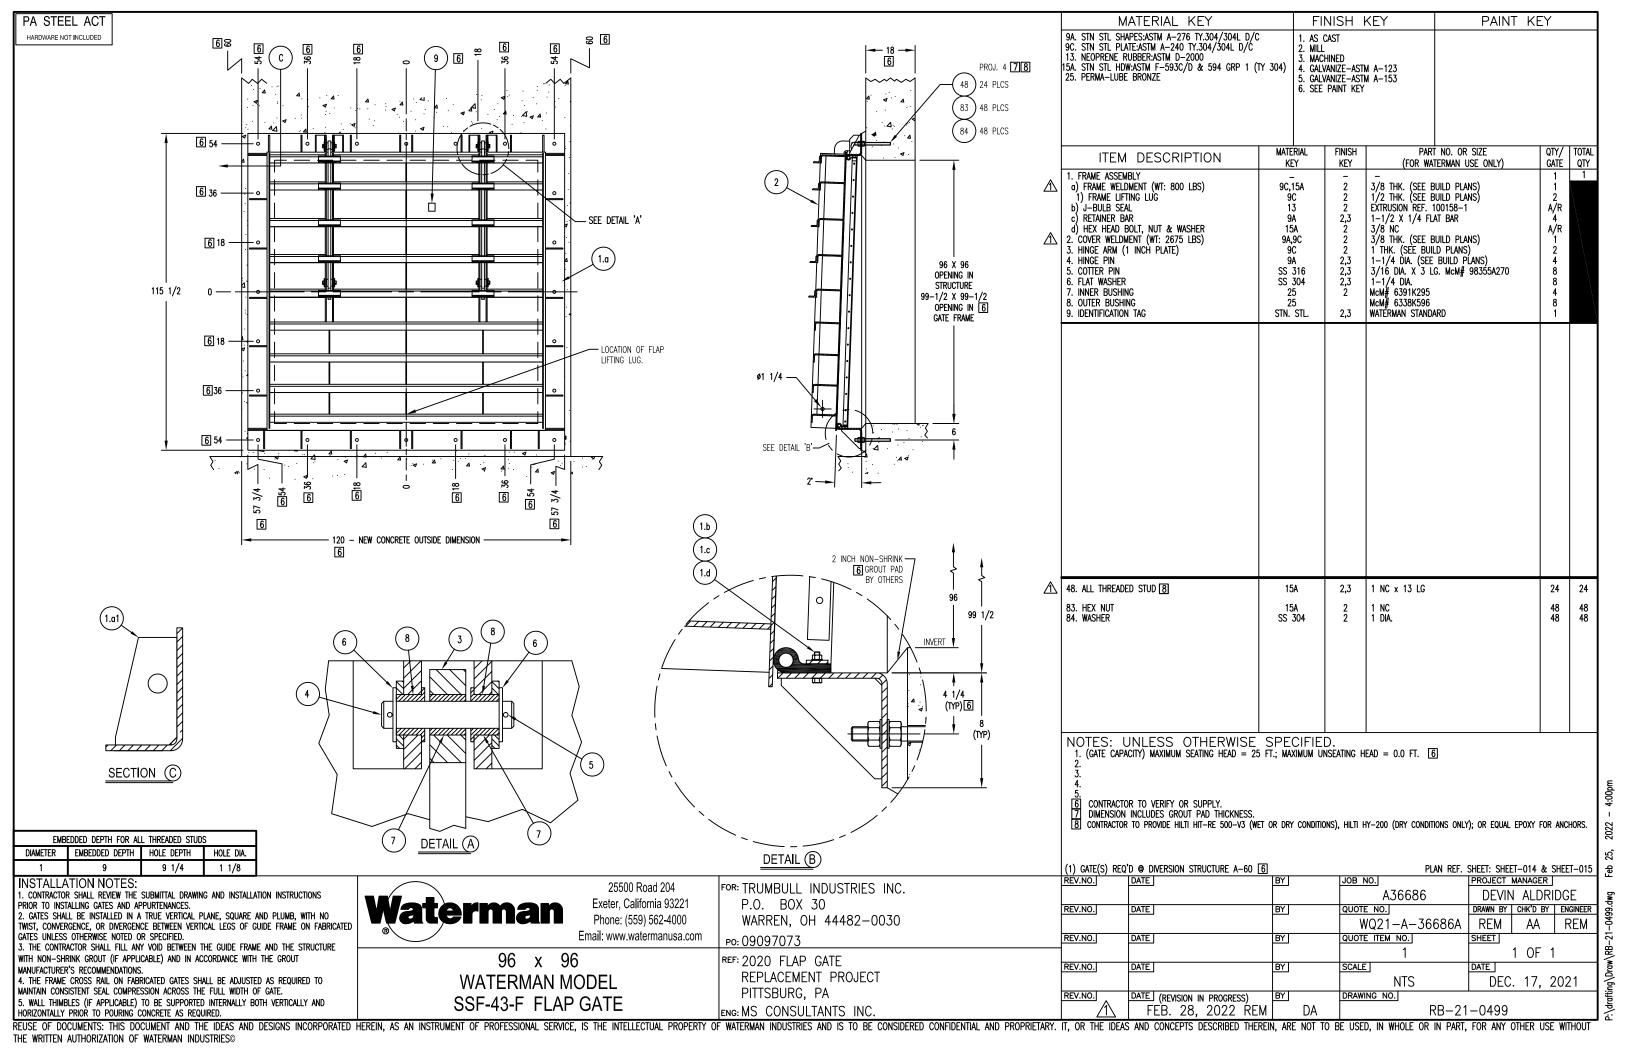

SSF-43 RECTANGULAR DRAINAGE FLAP GATES

FABRICATED STAINLESS STEEL

KEY FEATURES

- Fabricated Stainless Steel
- Automatic Operation
- Standard and Custom Sizes Available
- Seating Heads up to 30 feet
- Type 304, 304L, 316 and 316L Stainless Available
- · Neoprene Seat for Minimum Leakage
- · Flange or Thimble Mounting Available

GENERAL SPECIFICATIONS

(See Website for Latest Detailed Written Specifications)

GENERAL:

The flap gate shall be designed to allow free outflow and prevent backflow for maximum seating heads of up to 30 feet. Gates shall be Waterman model SSF-43 or equal.

CONSTRUCTION:

The frame shall be fabricated stainless steel of flatback design, with seating surface inclined from vertical at a minimum of 2.5-degrees to insure positive closure. For flatback gates mounted to flanges or thimbles, the gate flange shall be machined and drilled to match.

The cover shall be fabricated stainless steel with reinforcing ribs, designed to withstand the seating head specified. A lifting eye shall be provided for manual lifting of the cover.

Seating surfaces for frame and cover shall be neoprene "J seal" with stainless steel retainer.

The gate shall be provided with a double-pivoted hinge linkage so designed to permit complete seating, full opening and with stops or other arrangement to keep the cover from rotating sufficiently to become wedged in the open position. The hinge links shall be bronze brushed stainless steel.

All assembly hardware shall be stainless steel.

MATERIALS AVAILABLE:

Frame and Cover: Stainless Steel per ASTM A-276, ASTM A-240, type 304, type 304L, type 316L **Pivot Luq:** Stainless Steel per ASTM A-276, ASTM A-240, type 304, type 304L, type 316L

Hinge Link: Stainless Steel per ASTM A-276, ASTM A-240, type 304, type 304L, type 316L

Bushings and Washers: Commercial Bronze or Stainless Steel

Assembly Hardware and Pins: Stainless Steel per ASTM A-276, ASTM F-593, type 304, type 316

RECOMMENDED MAXIMUM SEATING HEADS:

8" to 30" size: 30 feet of head 36" to 42" size: 20 feet of head 48" to 60" size: 15 feet of head 66" to 84" size: 10 feet of head



MPI - MCWANE PLANT & INDUSTRIAL



