

December 29, 2025

CONTRACT NO. 1797

OHIO RIVER TUNNEL

Members of the Board

Shannah Tharp-Gilliam, Ph.D. Chair Person

Emily Kinkead Sylvia Wilson Harry Readshaw Darrin Kelly Theresa Kail-Smith Patrick J. Catena

Arletta Scott Williams Executive Director

Douglas A. Jackson, P.E. Director Operations & Maintenance

Michelle M. Buys, P.E. Director Environmental Compliance

Kimberly N. Kennedy, P.E. Director Engineering & Construction

Karen Fantoni, CPA, CGMA Director Finance

Michael Lichte, P.E. Director Regional Conveyance

Julie Motley-Williams Director Administration

Phil Cole
Director
Information Technologies

Erica LaMar Motley Director Scholastic Programs

ADDENDUM No. 11

All Bidders bidding Contract No. 1797 shall read and take note of this Addendum. The Contract Documents for Contract No. 1797 – Ohio River Tunnel are hereby revised and/or clarified as stated below.

Acknowledgement of Contract No. 1797

The Acknowledgement attached to **Addendum No. 11** is to be signed and returned immediately via email to <u>ORT.bids@alcosan.org</u> and acknowledged with Bidder's Proposal.

Michael Lichte P.E.

Director of Regional Conveyance

ACKNOWLEDGEMENT OF

CONTRACT NO. 1797 - OHIO RIVER TUNNEL

** return via email to ORT.bids@alcosan.org **

ADDENDUM No. 11

FIRM NAME:		
SICNATURE:		
SIGNATURE		
TITLE:	 	
DATE.		

December 29, 2025 CONTRACT NO. 1797 OHIO RIVER TUNNEL ADDENDUM No. 11

ATTENTION:

BIDS DUE: 11:00 A.M., prevailing time, on **Thursday, February 26, 2026** DEADLINE FOR QUESTIONS: 5:00 P.M., **Friday, January 16, 2026**

This Addendum No. 011 consists of 82 total pages including the following attachments:

- Attachment A APPENDIX A TECHNCIAL SPECIFICAITONS, Section 01
 45 23, Attachment 2 ATTACHMENT 2 List of Utilities for Inspection and
 Cleaning (7 pages, Revised 12/29/25)
- Attachment B APPENDIX E SUPPLEMENTAL INFORMAITON, Section 10 *Utility Inspection Coverage Exhibits* (9 sheets including Appendix E fly sheet)
- Attachment C CONTRACT DRAWINGS
 - Revised O14-CI-600 (Sheet 519 of 770)
 - Revised O14-ST-605 (Sheet 545 of 770)
 - Revised O14-ST-606 (Sheet 546 of 770)
- Attachment D CONTRACT DRAWINGS
 - Revised AS1-CI-501 (Sheet 500 of 770)
 - Revised AS1-CI-507 (Sheet 506 of 770)
 - Revised O41-CI-202 (Sheet 301 of 770)
 - Revised O41-CI-203 (Sheet 302 of 770)
 - Revised O41-CI-205 (Sheet 304 of 770)
- Attachment E APPENDIX E SUPPLEMENTAL INFORMATION, Section 5.7.3 – Robb Street Sewer, Project Number 76-0212-006-02 (8 sheets including Appendix E fly sheet)
- Attachment F CONTRACT DRAWINGS
 - Revised A58-ST-406 (Sheet 407 of 770)
 - Revised AS1-CI-503 (Sheet 502 of 770)
 - Revised AS1-CI-505 (Sheet 504 of 770)
- Attachment G CONTRACT DRAWINGS
 - Revised O07-ST-701 (Sheet 590 of 770)
- Attachment H CONTRACT DRAWINGS
 - Revised ORT-ST-103 (Sheet 103 of 770)

- Revised ORT-ST-500 (Sheet 152 of 770)
- Attachment I CONTRACT DRAWINGS
 - Revised ORT-ST-200 (Sheet 117 of 770)
 - Revised ORT-ST-300 (Sheet 130 of 770)
 - Revised ORT-ST-400 (Sheet 141 of 770)
 - Revised ORT-ST-600 (Sheet 159 of 770)
 - Revised ORT-ST-700 (Sheet 169 of 770)
 - Revised ORT-ST-800 (Sheet 179 of 770)

ATTENTION BIDDERS

The following additions to and modifications of the Contract Documents will be included in and become part of the Contract for the Allegheny County Sanitary Authority (ALCOSAN) Ohio River Tunnel. Bidders are instructed to take the following into account in rendering any Bid for this work

The Bidder is responsible for verifying that he/she has received and reviewed all of the pages of the Contract Documents as well as all of the pages and attachments of all addenda. The Bidder shall verify all pages with the table of contents in the Contract Documents and the first page of all Addenda. Receipt of this Addendum must be noted on the Bid Form. These items modify the portions of the documents specifically noted; all other provisions of the Contract Documents shall remain in effect.

CONTRACT NO. 1797 OHIO RIVER TUNNEL ADDENDUM NO. 11

A. QUESTIONS & ANSWERS FROM RFI'S SENT TO ORT.bids@alcosan.org

- Clause 1.1.C in specification section 01 90 00 calls for the Contractor to comply with several agreements ALCOSAN has entered into with the affected railroads including obtaining and paying for right-of-entry permits and associated fees for activities planned in the right-of-way that are not specifically covered in the agreements listed in 1.3.A of that same specification section. Per clause 1.3.A in 01 90 00 please confirm the Contractor is responsible for coordinating the necessary protection services with the appropriate railroads while ALCOSAN will pay the railroads directly for said protection services.
- A1 It is the Contractor's responsibility to coordinate with the railroads to obtain permits and approvals, railroad-provided engineering reviews, railroad-provided construction inspections, railroad-provided protection services, to pay for permit fees and insurance, to pay for the costs associated with obtaining permits, and to pay other fees associated with railroads' requirements. Please review specific Bid Items and Allowances.

Railroads' insurance requirements as they are currently known are identified in the Contract Documents, Article 3SC, Exhibit A-3SC. Prepare bids in accordance with the Contract Documents.

Related to this response, see:

Section B, Items 1, 2, and 3 for CHANGES TO CONTRACT DOCUMENTS:

- Article 1 Bidding Documents, Bid Form, Item 121, Specific Allowance #9 –
 Additional Traffic Control and Site Security and Railroad Requirements
- Specification Section 01 22 00 Measurement and Payment, 3.2 Bid Items, Item 121, Specific Allowance #9 - Additional Traffic Control and Site Security and Railroad Requirements
- Specification Section 01 90 00 Railroad Permit Compliance Requirements, 1.3.A, 3.1.A, and 3.1.C.
- Q2 Please provide copies of all railroad agreements referenced in specification section 01 90 00.
- A2 Railroad agreements are pending and will be provided upon receipt from each of the three railroads.

Bidders must inform themselves of railroad requirements unique for each railroad. The Contractor is responsible for timely coordination with railroads to obtain and maintain required insurances, acquire permits, to obtain railroad-provided protection services, and to obtain railroad-provided construction inspections in advance of work. Bidders are advised to request necessary railroad-provided services well in advance of need.

- Q3 Please confirm the Contractor will be granted compensable time extension(s) for any Work delayed by a railroad's failure to provide protection services that the Contractor requested in accordance with the timelines required by the respective railroad agreement.
- A3 Request for consideration of perceived railroad delay will be considered by the Owner on a case by case basis upon Contractor's written documentation of submittals to the railroads, including documentation to show timeliness and completeness of Contractor's submittals, and documentation to demonstrate the impact to the overall project's critical path.

Bidders are advised to request necessary railroad-provided reviews well in advance of need.

Q4 Attachment 2 from Specification 01 45 23, in the section for site O14, lists the cleaning and inspection of a 15" VCP and 30" RCP from MH 007P029 to MH 1D. The Utility Inspection Limit Map provided with Addendum 4 appears to show the 15" passing through MH 007P023 and into MH-N0 and, apparently, the 30" running from MH-N0 to MH1D. Drawing O14-CI-608 appears to show a different routing. The 15" appears to dead-end into the 42" RCP and the 30" appears to run from MH-N0 to a dead-end into the 48" RCP. Several questions arise:

A) What is the correct routing of these two lines?

B)Are either the 15" or the 30" subject to the dry-weather flow volumes of the 42" and/or the 48" sewers?

C)Since all the 30" and the portion of the 15" downstream of MH 007P023 are going to be removed, why don't we simply do the inspection and cleaning from MH 007P029 to 007P023?

- A) Refer to O14-CI-600 for the presumed routing of the sewer line based on field survey and CCTV inspection documentation. This information generally aligns with the Utility Inspection Coverage Exhibits included in Addendum 4, Attachment B.
 - B) Bidders to assume that the existing 15" and the existing 30" sewer lines may be influenced during dry weather.
 - C) Suggestion accepted. Replace Specification Section 01 45 23, Attachment 2 in its entirety with Specification Section 01 45 23, Attachment 2 REVISED 12/23/25. See Item 4 and Attachment A of this Addendum for CHANGES TO CONTRACT DOCUMENTS. Exhibits added to APPENDIX E –

SUPPLEMENTAL INFORMATION in Addendum 4 have been REVISED. See Attachment B of this Addendum.

- Attachment 2 from Specification 01 45 23, in the section for site O14, lists the cleaning and inspection of a 48" Sewer from MH O-14-PS to Outfall O-14. It also lists the cleaning and inspection of a 42" Sewer from MH O-14-PS to Outfall O-14A. Both of these outfalls are shown on Drawing O14-CI-600 as "NOT FOUND". There is no information on Table 2 as to whether or not the outfalls have flap gates and it appears that the flap gates for these lines are at the existing regulator, the site of MH O-14-PS. There are no provisions for a cofferdam at either outfall. Are these lines submerged and, if so, how can they be cleaned and inspected?
- A5 Both noted overflow sewers are submerged. Flap gates exist within the existing O14 regulator, not at the outfall locations. See Section B, Item 4 and Attachment A of this Addendum as the requirement for CCTV of these two existing lines has been modified to sonar inspection.

 Specification 01 45 23, Part 1.1.G. has been added in its entirety. See Section B, Item 5 for CHANGES TO CONTRACT DOCUMENTS.

 Specification 01 22 00 Measurement and Payment, Bid Item 108 Sewer CCTV, Cleaning and Stabilization is REVISED; see Section B, Item 6 for CHANGES TO CONTRACT DOCUMENTS.
- Q6 Attachment 2 from Specification 01 45 23, in the section for site O14, lists the cleaning and inspection of a 54" Sewer from MH O-14-PS to MH ADC007P014A (13 LF). There is no information on dry weather flow volumes for this sewer shown on the Table in Specification 02 73 40. Please provide.
- A6 See Section B, Item 4 and Attachment A of this Addendum as the requirement for inspection and cleaning of the 54" sewer from MH O-14-PS to MH ADC007P014A has been eliminated.
- Q7 Note 17 on Drawing O14-ST-606 states that "THE CONTRACTOR SHALL DISCHARGE ALL CONSTRUCTION WATER ARISING FROM THE 014-DS SITE TO THE EXISTING 014 REGULATOR (VORTEX DROP STRUCTURE) VIA THE PROPOSED 48" RCP WEST PIPE TRANSITION BOX." Additionally, Note II.G on Drawing 014-ST-607 requires that, prior to SOE installations, the Contractor must have completed "PREPARATION OF BYPASS PUMPING SYSTEM BETWEEN EXISTING MANHOLE NUMBER MN-01 ON THE 42" RCP AND NEWLY INSTALLED FLOW TRANSITION BOX TO THE 014 REGULATOR." This Transition Box, as identified by Suggested Construction Sequence #9 on Drawings 014-ST-604 and 014-ST-608, is located inside the Secant Pile SOE for the new Regulator. As there is significant discharge construction water associated with secant pile construction and other construction activities that are shown to occur before Suggested Construction Sequence #9, making this sequencing and requirements appear to be in direct conflict. Is there not an alternate route for discharging construction water to the existing Regulator?

A7 Refer to Section 31 23 19 - Control of Groundwater and Construction Water, Part 1.8.A (Table) for the designations, and Sheet O14-CI-600, for the plan locations, of the proposed discharge points (ALCOSAN-O14W/O14E) into the existing O-14 Regulator.

Note 17 on Sheet O14-ST-606 has been revised to: THE CONTRACTOR SHALL DISCHARGE ALL CONSTRUCTION WATER ARISING FROM THE O14-DS SITE TO THE EXISTING O14 REGULATOR (VORTEX DROP STRUCTURE) VIA THE PROPOSED 48-INCH RCP WEST PIPE TRANSITION BOX.

Note II.G on Drawing O14-ST-607 refers to "PREPARATION" work for the bypass pumping during DRY WEATHER conditions for the period of the fluming pipe installation. Contractor may wish to sequence work so that the discharging of construction water and future bypass pumping of the 42-inch RCP sewer do not overlap during that period of time.

See Section B, Item 7 (Specification) and Item 8 (Revisions to O14-CI-600, O14-ST-605, and O14-ST-606), and Attachment C of this Addendum for CHANGES TO CONTRACT DOCUMENTS.

- Q8 O14 Regulator Bypass Pumping The suggested construction sequence for the bypass pumping at the O14 regulator appears to direct the flow from an existing 15" and 48" sewer pipes into manhole No. MH-N1. This bypass pumping will combine with the 42" flow already running through manhole No. MH-N1 and will eventually run through the flume pipe when the regulator is being constructed. Please confirm this is the intent of the bypass pumping scheme and if not provide clarification.
- A8 The design intent is to bypass pump the flow in the 15" sewer into MH-N1 until the transition box to the existing regulator is completed (or partially completed), as noted in suggested Sequence Step 9 on Sheet O14-ST-608.

Bypass pumping of the flow in the 48" RCP sewer is only required during the period of its final removal during dry weather conditions only. Refer to Answer to A9 of this Addendum for further clarification. The location for this bypass pumping shall be at a suggested upstream site to be provided in the next Addendum.

Q9 O14 Regulator Bypass Pumping - The suggested construction sequence for the bypass pumping at the O14 regulator appears to direct the flow from an existing 15" and 48" sewer pipes into manhole No. MH-N1. This bypass pumping will combine with the 42" flow already running through manhole No. MH-N1 and will eventually run through the flume pipe when the regulator is being constructed. Please confirm the proposed 42" flume pipe is sized to accommodate all of these flows.

A9 The 42" fluming pipe size is an "in-kind" temporary replacement for the existing 42" RCP, providing same capacity as existing. Flows to be bypassed into the 42" RCP will be needed at different times during construction.

Flow through the existing 48" RCP shall be maintained or replaced with a fluming pipe until its removal near the end of construction at this site as indicated on the Contract Documents.

- Q10 Table 2 from Specification 01 45 23, in the section for site O41, lists the cleaning and inspection of a 54" RCP sewer from MH 007F078 to Outfall 007KO40. Does Outfall 007KO40 have a flap gate which would allow for dewatering of the 54" sewer? If not, how is this sewer to be cleaned and inspected?
- A10 There is no existing flap gate at Outfall 007KO40; Specification 01 45 23, Attachment 2 has been REVISED to allow for Sonar Inspection of the existing 54" sewer between MH 007F074 and Outfall 007KO40. Remaining portions of the existing 54" sewer shall be See Attachment A.
- O27 High Voltage Power Line Outages Specification Section 01 14 19 Use of Sites, Section 3.1 states that de-energization of the existing high voltage lines at Site O27 MAY be possible during short periods of the ORT Project construction. The specifications also state to assume that the lines cannot be de-energized during seasonal high loads and consumption (which may vary). The Plans and Specifications also indicate that the existing high voltage power lines at Site O27 will impact the work at the site including the IPP River Wall. Since the installation of the river wall is critical to the advancement of the work at Site O27 and all work at the site is on the critical path, please provide the durations and outage windows that the lines can be de-energized. This information is critical to the contractors price proposal and the evaluation of whether or not the project can be completed on time.
- Duquesne Light Company (DLC) has confirmed that the 23 kV lines were constructed for and provide power only to the Owner. As such, maximum flexibility for the de-energization of the 23 kV power line will be coordinated by the Contractor in real time with the Owner and DLC. A minimum of 15 business days is needed from time of receipt of Contractor's written request for deenergization of these power lines and the de-energization of the power line. Specification 01 14 19, Part 3.1.B.2. has been revised. See Section B, Items 9 and 10 for CHANGES TO THE CONTRACT DOCUMENTS.
- Q12 Please clarify the standard against which a differing site condition will be judged when conditions/locations are not baselined in the GBR, to avoid gaps in relief for atypical subsurface conditions.
- A12 Page 1 of the GBR contains the following: "... If a condition is encountered that is not addressed in the GBR, the parties may look to other Contract Documents, including the GDR and Specifications, for assistance." Addendum 001, Section

- B, Item 11 states "...Other indications of site conditions and anticipated quantities or work are contained in other Contract Documents". If the subsurface condition is not indicated in the contract documents, and agreement cannot be reached with the Owner, the Contractor may submit a request to the DRB for adjudication.
- Q13 Please delete the phrase ", subject to the controlling provisions of the Contract, including the GBR's own terms" from the definition of the GBR as reliance on the GBR should be unqualified.
- A13 This change has already been made. Please refer to Addendum No. 002, B. CHANGES TO CONTRACT DOCUMENTS, Item, 13. This answer replaces Addendum 9 Q39/A39.
- Q14 The documents do not address delayed NTP as a relief event. Please add language deeming delayed NTP a suspension or change that entitles Contractor to equitable adjustments of price and time.
- A14 The following will be added to the Contract Documents: If the Notice to Proceed exceeds 180 calendar days from the bid submission date, the Contractor may submit a request under the provisions in General Contract Conditions Article 3.32. for escalation of bid costs, but not time. See Section B, Item 17 CHANGES TO CONTRACT DOCUMENTS for revisions.
- Q15 There is no right afforded Contractor to terminate if Owner-directed suspensions persist or NTP is materially delayed. Please add a right for Contractor to terminate if suspensions exceed 180 days in the aggregate or if NTP is delayed beyond a reasonably defined period.
- A15 The following will be added to the Contract Documents: If the Notice to Proceed exceeds 360 calendar days from the bid submission date, the Contractor may elect to terminate. A 60-calendar day notice of intent to terminate must be provided by the Contractor. See Section B, Item 18 CHANGES TO CONTRACT DOCUMENTS for revisions.
- The final paragraph of Section 3.30 of the General Conditions shifts risk by requiring Contractor to, at its sole expense, relocate, replace, or repair any materials or Work which becomes an obstruction or is damaged in any way due, in the Owner's sole opinion, to the Contractor's failure to properly store and/or protect the materials and/or Work during a suspension. Please delete the phrases ", at its sole expense and without any increase in the Contract Sum," and ", in the Owner's sole opinion," from the second sentence in Section 3.30. Further, please modify the provision such that reasonable demobilization/protection/replacement/repair/storage costs are compensable as part of the equitable adjustment provided Contractor is not at fault for the indefinite suspension.

- A16 It is the Contractor's sole responsibility to protect all materials and work on the sites during a suspension of work, and the Contractor will remain liable for failing to do so in a manner that results in damage to the materials or work. Section 3.30 TEMPORARY SUSPENSION OF THE WORK of the General Condition allows for the Contractor to claim for all "out-of-pocket" costs, this would include the items mentioned in your question.
- Q17 Exhibit B (Cost Reduction Incentive), if applicable, seemingly addresses value engineering. The following language appears therein (emphasis added): "The Contractor's forty percent (40%) share of the net savings shall constitute full compensation to the Contractor for the cost reduction proposal and the performance of the Work". Please clarify the intent of the underlined language as it seems potentially overbroad.
- A17 The Owner cannot know in advance what cost reductions the Contractor will propose during value engineering, or the mechanism for remuneration, and as such any proposed cost reductions will be reviewed individually on a case by case basis. Should the Contractor and Owner fail to agree on any individual value engineering proposal for any reason, the Contractor is free to withdraw the value engineering proposal.
- Relief for force majeure events appears conditioned on Owner "acknowledging and accepting it," and the list of qualifying events is closed/limited. Please (i) delete "as acknowledged and accepted by the Owner" from Section 3.34(A)(4) of the General Conditions, (ii) add "any other cause beyond Contractor's reasonable control" to the list in Section 3.34(A), and (iii) delete the phrase "that is not sought by Contractor in accordance with the Contract Documents" from Section 3.34(A)(10).
- Please see ARTICLE 2, ATTACHMENT B3, ESCROW AGREEMENT, Section E, H, Force Majeure. Where it clearly states that "Such acts shall include but not be limited to......". The section you are quoting does not refer to Force Majeure events but to events that do not rise to that standard. As such, the Owner must accept that the events stated in 3.34 A. 4. have a delay on the critical path of the latest Owner accepted Contract Schedule. No changes will be made to the Contract Documents.

Bidder item (ii), no changes will be made to the Contract Documents.

Bidder item (iii) the phrase "that is not sought by Contractor in accordance with the Contract Documents." will be deleted. See Section B, Item 19 – CHANGES TO CONTRACT DOCUMENTS for revisions.

Q19 Please confirm, and include language in the contract to that effect, that Contractor will remain entitled to schedule relief in the event of concurrent delay.

- The Contractor is not entitled to schedule relief for concurrent delays. However, the Contractor may claim schedule relief in the event of concurrent delays under Article 3, Section 3.32 PROPOSED CHANGE ORDERS, CHANGE ORDERS, AND CHANGE DIRECTIVES and Section 3.34 DELAYS AND EXTENSION OF TIME.
- Q20 Please add express language to the contract making it clear that Contractor is not bound by any performance metrics when it comes to the operation of the tunnel but rather is building to Owner-provided plans and specs.
- A20 If the tunnel and regulator structures are constructed to the precise Owner provided plans and specs, the Contractor is not bound by any performance metrics. However, if the tunnel and regulator structures are not constructed to the precise Owner provided plans and specs then performance requirements may be considered in the determination of Contractor obligation.
- Q21 Owners Protective Liability Section 3 Insurance, Provision 6 Owner's Protective Liability Can you please clarify what is meant by Owner's Protective Liability? Are you referring to General Liability or Professional Liability with this requirement?
- A21 In the Supplemental Contract conditions, Article 3SC, Section 3.9 regarding insurance was deleted in its entirety and replaced with Exhibit A 3SC Insurance which requires no Owner's Protective Liability.
- Q22 Property Insurance Section 3 Insurance, Provision 6 Property Insurance –

Requirement that states Contractor will include owner soft costs. Specifically, fees associated with Engineers and Architects and Loss of Use or Time Delay.

To include this coverage within the Builder's Risk Property Insurance, the Owner will need to provide Contractor with an itemization of these costs and the quantified values of insurance that you will be requiring. This will need to include the substantiation of the value you declare, so that we are able to present this to our underwriters to determine the cost for these extension of coverage.

- A22 For Article 3SC EXHIBIT A-3SC, INSURANCE, Property Insurance, the Contractor should assume a maximum liability for "fees and charges of engineers and architects" and "coverage for loss of use or time delay", of \$5 million total.
- Q23 On site A58/AS1 on drawing AS1-CI-505 in the plan a 96" x 96" Timber Flap Gate is called out at being in place on the existing outfall. Is this timber flap gate operable and in good condition such that it can be used to prevent river water from flowing back into the 102" brick combined sewer?

- A23 Inspection and repair requirements of the flap gate at A58 outfall have been ADDED to Section 01 22 00 (BID ITEM 39). Notes for this effort have been ADDED to Contract Drawings A58-ST-406, AS1-CI-503, and AS1-CI-505. See Section B Items 11 and 12, and Attachment F for Changes to Contract Documents.
- Specification 02 73 40 3.2.A calls for a dry weather flow management system of sufficient capacity to continuously convey 1.5 times the average daily maximum dry weather flows provided in the table below. The table provides two listings at Site 007: one for the 45" Chartiers Creek Interceptor (CCI) and one for the 24" McKees Rocks sewer. Specification Section 02 73 40 3.2.N provides requirements for bypassing the 24" sewer in subsection .2. However, subsection .1 addresses the CCI and is silent as to any bypassing requirements. In fact, it directs the Contractor to plan any construction on top of the CCI during dry weather periods.

Per Detail C7 on Sheet 664, this 45" pipe will need to be demolished down to about spring-line to install line C-04-CS. Are Bidders to assume that this 45" line runs at half-full or less during dry weather periods?

A24 With regard to (Sheet 664) Sheet ORT-MD-017 Detail C-7 for C-04-CS and C-04-MH2 construction, the Bidder is to assume that the 45" line runs half-full or less during dry weather periods for the installation of C-04-CS.

For clarification purposes, Section 02 73 40 Part 3.5.N (not 3.2.N as quoted in the RFI) addresses flow management operations at the O07 Site. In addition, Details of C-04-MH1/C-04-CS, and C-04-MH2 are shown on Sheet O07-CI-705 and Sheet ORT-MD-017 (Detail C-7), respectively. Note 12 on Sheet O07-ST-701 has been revised to include reference ORT-MD-017.

See Section B Item 13 and Attachment G for Changes to Contract Drawing.

- For the cutoff of the secants three feet below grade in areas where near surface structures terminate at grade (such as the regulator at site A48) you would be pouring these structures up against the secant walls. When the cutoff of the secants is done, any exposed face of the walls of these structures will not have uniform walls and will take the shape of the piles. Is this acceptable or what remedies would Alcosan prefer in these instances?
- A25 The exposed permanent NSF wall will be embedded in backfill during the final site grading. If determined necessary during SOE removal process, this shall be addressed on a case by case basis as a field change.
- Q26 The cast-in-place concrete specification is calling for mockups in section 1.4C. Are mockups required for each site, or can they be done at one site and applied across the project?

- A26 Section 03 30 00 Part 1.4.C has been deleted. See Section B Item 14 for changes to Contract Documents.
- Q27 Does the concrete for the near surface facilities require integral waterproofing?
- Yes. Refer to Section 03 30 00 Part 2.3.L. Also refer to Addendum 006, Q44/A44 and Q46/A46 for the same requirement for shaft and tunnel concrete.
- Q28 O06A Work Hours for Adit Construction Specification section 01 32 13, Paragraph 1.3.D.5 indicates that the Contractor is exempt from the listed working hours when constructing the O06A adit if we are performing probing, grouting, drilling, maintenance and other underground non-blast-related work for adit construction.

In order to meet the project completion dates, our project schedule indicates that we will need to perform blast related activities during work hours outside the Regular Work Hours at site 006A of 7:00AM to 7:00PM Monday through Friday, excluding Legal Holidays.

Please revise the specifications to allow contractors to blast for the O06A adit from 9:00AM to 5:00PM on Saturdays and remove muck from the O06A shaft from 7:00AM to 8:00PM on Saturdays.

A28 No change to Contract Documents.

The Bidder is reminded of Section 01 32 13 Part 1.3.C regarding obtaining written permission of the Owner and approval of the Municipality for work hours not authorized in the Contract Documents. Also noting that additional time is being added to the Contract per this Addendum Q49/A49 and Section B, Item 20.

- Q29 O27 IPP Wall Constructability At the 027 site, the IPP wall shows and details an interlocking pipe pile that extends into rock. The current design is not constructable for two reasons:
 - 1. In order to advance the pipe into bedrock, this will require the pipe to be drilled through the bedrock. Assuming we drill in advance of the pipe, there are drilling systems that allow us to advance the casing, but would not allow the interlocking system to be drilled into rock.
 - 2. If we were to try and oversize the drilling to incorporate the interlocking mechanism in the borehole, this would create an overlapping pilot hole in bedrock. Once the first interlocking pipe is installed, the interlocking mechanism would be in the way of drilling the 2nd pipe pile in.

Based on the above, can the design team provide specific design parameters for the contractor to assume when looking at alternative wall systems? Please confirm that alternative wall systems are permitted.

- A29 Ample case histories have used commercially available core bit / ring bit technologies for socketing interlocked pipe piles into rock. Bid the IPP walls as shown on Contract Documents.
- Q30 Secant Pile Dimensions Is there any significance to the secant pile diameters shown on the drawings as it relates to existing facilities/utilities? The exact sizes shown on the drawings do not match industry standard tooling as they are typically in metric sizes. Assuming the contractor can modify the pile sizes and maintain an equivalent design as shown (ie. equivalent section modulus per LFT of wall), can the contractor modify the pile diameters and spacing to match their tooling capabilities (ie. means and methods)?
- A30 Yes, as long as the revised dimensions provide, at a minimum, equivalent structural capacity, rigidity, joint watertightness, functionality, and mitigation of ground settlement and groundwater drawdowns to the designs shown on the Contract Documents. Contractor must prepare and submit calculations.
- We request an extension of the question deadline to two weeks prior to the bid date to allow us time to submit after the holiday season.
- A31 See Addendum 10.
- Is there any significance to the secant pile diameters shown on the drawings as it relates to existing facilities/utilities? The exact sizes shown on the drawings do not match industry standard tooling as they are typically in metric sizes. Assuming the contractor can modify the pile sizes and maintain an equivalent design as shown (ie. equivalent section modulus per LFT of wall), can the contractor modify the pile diameters and spacing to match their tooling capabilities (ie. means and methods)?
- Yes, as long as the revised dimensions provide, at a minimum, equivalent structural capacity, rigidity, joint watertightness, functionality, and mitigation of ground settlement and groundwater drawdowns to the designs shown on the Contract Documents. Contractor must prepare and submit calculations.
- Q33 At the 027 site, the IPP wall shows and details an interlocking pipe pile that extends into rock. The current design is not constructable for two reasons:

 a. In order to advance the pipe into bedrock, this will require the pipe to be drilled through the bedrock. Assuming we drill in advance of the pipe, there are drilling systems that allow us to advance the casing, but would not allow the interlocking system to be drilled into rock.
 - b. If we were to try and oversize the drilling to incorporate the interlocking mechanism in the borehole, this would create an overlapping pilot hole in bedrock. Once the first interlocking pipe is installed, the interlocking mechanism would be in the way of drilling the 2nd pipe pile in.

Based on the above, can the design team provide specific design parameters for the

- contractor to assume when looking at alternative wall systems? Please confirm that alternative wall systems are permitted.
- A33 Ample case histories have used commercially available core bit / ring bit technologies for socketing interlocked pipe piles into rock. Bid the IPP walls as shown on Contract Documents.
- Will ALCOSAN consider establishing an allowance item to cover the cost of ground modification under the existing sewers, where such work is specified, to reduce uncertainty that will lead to potentially unnecessary costs being included in the Contractor's bid?
- A34 Refer to BID ITEM 116 SPECIFIC ALLOWANCE #4 GROUT MATERIALS USED FOR NEAR SURFACE STRUCTURES. For actual ground treatment operations, include all effort in the BID ITEM pertaining to each NSF structure at the sites (e.g., BID ITEM 56 for A48 site regulator) based on the Provisions of Section 01 22 00 Part 3.1.I Ground Improvement.
- Q35 *CCT Final Lining Dimensions Can the CCT final lining dimension size be increased to match our equipment?*
- A35 No, the CCT final lining dimensions will not be changed during the bid phase.

 Any proposed changes following award can be made under Article 3, Exhibit B,

 Cost Reduction Incentive.
- Q36 Drawing ORT-ST-100 Table 1. When using the values in this table the clear distance between the 'A' Line at Grade and the 'B' Line shown in Section 2 is 2'-0" for:
 - SMRT-014-DS
 - ORT-27-DS
 - ORT-O41-DS
 - CCT-007-AS
 - ORT-AS1

When using the values in this table the clear distance between the 'A' Line at Grade and the 'B' Line shown in Section 2 is 1'-10" for:

- ORT-A48-DS
- ORT-A58-DS
- CCT-O06A-DS

Question: Is the 1'-10" value correct?

A36 The 1'-10" value is correct.

Refer to the SOE drawings of the respective shafts for detailed dimensions related to the space between the 'A' Line and the 'B' Line. Also Refer to Addendum 8 Answer A15 for clarification on vertical tolerances regarding the 'A' Line and 'B' Line.

Q37 Drawing ORT-ST-103, Note #9 (Shaft O27) and ORT-ST-500, Note #7 (Shaft AS1) Both of these notes state "CONTRACTOR SHALL PROVIDE THE NECESSARY
REINFORCEMENT OR CENTRALIZERS TO SUPPORT AND MAINTAIN THE TOE
GROUTING PVC PIPES AND INCLINOMETER CASINGS IN PLACE WHILE
POURING CONCRETE IN SECONDARY PANELS."

Question #1: Where on the Drawings are the locations of the Toe Grouting PVC pipes in the Secondary Panels shown?

Question #2: Are there any Toe Grouting PVC pipes required for the Primary Panels? Question #3: Where on the Drawings are the locations of the Inclinometer Casings in the Secondary Panels shown?

Question #4: Are there Inclinometer Casings required in the Primary Panels? Question #5: Where in the Specifications are the requirements for Toe Grouting beneath the Slurry Wall Secondary Panels detailed / listed?

Question #6 – To aid in assembly, handling and placement can the contractor use Sch. 40 steel pipe in lieu PVC for the toe

A37 Answer to Questions #1 and #2: Note 9 on ORT-ST-103 and Note 7 on ORT-ST-500 have been removed. Also refer to Addendum 009 Q15/A15 for additional information.

ORT-ST-103 and ORT-ST-500 have been revised. See Section B Item 15 and Attachment H for Changes to Contract Documents.

Answers to Questions #3 and #4: Approximate inclinometer locations in or around shaft SOEs (and NSF SOEs) are shown on the GI series of Contract Drawings per site. The final locations of the inclinometers and their support in the panels shall be developed by the Contractor and as approved by the Owner during the shop drawing development process as stated in Section 31 09 13 Part 1.1.B and 1.6.B.

Answer to Question # 5: Refer to Addendum 009, Q15/A15 for additional information.

Answer to Question #6: If the Contractor elects to conduct toe grouting, the type of grouting pipe is Contractor's choice.

- Q38 See the following Drawings:
 - Drawing ORT-ST-200, Note #8, (O41 Drop Shaft)
 - Drawing ORT-ST-300, Note #8, (A48 Drop Shaft)
 - Drawing ORT-ST-400, Note #8, (A58 Drop Shaft)
 - Drawing ORT-ST-600, Note #8, (O14 Drop Shaft)
 - Drawing ORT-ST-700, Note #8, (O07 Drop Shaft)
 - Drawing ORT-ST-800, Note #8, (O06A Drop Shaft)

These notes state "CONTRACTOR SHALL PROVIDE THE NECESSARY REINFORCEMENT OR CENTRALIZERS TO SUPPORT AND MAINTAIN THE TOE GROUTING PVC PIPES AND INCLINOMETER CASINGS IN PLACE WHILE POURING CONCRETE IN SECONDARY PILES."

Question #1: Where in the Specifications are the requirements for Toe Grouting beneath the Secondary Secant Piles detailed / listed?

Question #2 – The note in the Secondary Pile Detail points to one pipe. However, two pipes are shown in the detail. How many 3" PVC tubes are to be included in the secondary piles covered by this note?

Question #3 – To aid in assembly, handling and placement can the contractor use 3" Sch. 40 steel pipe in lieu 3" PVC tube shown in the Secondary Pile Detail?

- Answer to Questions #1 and #2: Note 8 on these drawings have been removed. As stated in Section 31 57 00 (Secant Pile Wall) Part 1.6.D.8, the Contractor shall submit "Procedures and mix designs for grouting of the toe of the secant piles to seal the secant pile wall/ground interface, where applicable." Refer to Addendum 009, Q15/A15 for additional information. See Section B Item 16 and Attachment I for Changes to Contract Documents.

 Answer to Question #3: If the Contractor elects to conduct toe grouting, the type of grouting pipe is Contractor's choice.
- Q39 Drawing ORT-ST-201, Section B shows a "Soft Eye for Regulator Connection". However, Drawing ORT-ST-200 shows all of the Secant Piles as being unreinforced.

Question: Please clarify how there can be a "soft eye" required if the piles are unreinforced.

- A39 The call out of "soft eye" was meant to highlight the location of structural connection from adjacent structure, whether the SOE is reinforced or unreinforced. Since the shaft SOE shown on the Contract Drawings is unreinforced, no special structural reinforcements within the SOE are applicable. In case the Contractor elects to use reinforcements for its own convenience (e.g., reinforced slurry wall), then special consideration shall be given to this zone of "soft eye".

 No changes to Contract Documents.
- Q40 Drawing ORT-ST-301, Section B shows a "Soft Eye for 72" ID Pipe Connection from A48-RG". However, Drawing ORT-ST-300 shows all of the Secant Piles as being unreinforced.

Question: Please clarify how there can be a "soft eye" required if the piles are unreinforced.

- A40 See response this Addendum A39
- Q41 Drawing ORT-ST-401, Section B shows a "Soft Eye for A58-RG1 Connection and Soft Eye for A58-RG2 Connection". However, Drawing ORT-ST-400 shows all of the Secant Piles as being unreinforced.

Question: Please clarify how there can be a "soft eyes" required if the piles are unreinforced.

- A41 See response this Addendum to A39.
- Q42 Drawing ORT-ST-601, Section B shows a "Soft Eye for O14 SC Connection". However, Drawing ORT-ST-600 shows all of the Secant Piles as being unreinforced.

Question: Please clarify how there can be a "soft eye" required if the piles are unreinforced.

- A42 See response this Addendum to A39.
- Q43 Drawing ORT-ST-701, Section B shows a "Soft Eye for O07 Tunnel Relief Outfall Connection". However, Drawing ORT-ST-700 shows all of the Secant Piles as being unreinforced.

Question: Please clarify how there can be a "soft eye" required if the piles are unreinforced.

- A43 See response this Addendum to A39.
- Q44 Drawing ORT-ST-801, Section A shows a "Soft Eye for CCT-006A-RG Connection". However, Drawing ORT-ST-800 shows all of the Secant Piles as being unreinforced.

Question: Please clarify how there can be a "soft eye" required if the piles are unreinforced.

- A44 See response this Addendum to A39.
- Q45 Reference Drawing O14-CI-610 Site Restoration Plan, Keynote D Keynote is labelled as "On-Site Aggregate Pavement", but reference Detail C-20 in
 drawing ORT-MD-019 labels it as "On-Site Aggregate Surface".
 Please confirm that this keynote should be titled "On-Site Aggregate Surface".
- A45 There is no Keynote D labeled "On-Site Aggregate Pavement" on O14-CI-610.
- Q46 Addendum 7 answer 25 waives permit fees for connection to Alcosan structures. Are charges for discharge waived? Should contractor assume no charges for discharge will be required outside of the Borough of McKees Rock?
- A46 ALCOSAN and Pittsburgh Water will not charge fees for discharging construction water into ALCOSAN structures as shown in the Contract Documents.

McKees Rocks has confirmed that they do not currently have established fees for the discharge of construction water into McKees Rocks sewers.

- Since it is virtually impossible to accurately predict how much water the ORT Project will discharge and the actual costs, a large contingency cost must be included in the proposal. The rates for water discharge from ground excavation are unclear for the 3 infrastructure owners along the project alignment. Will Alcosan please assume responsibility for all ground dewatering discharge fees on the project?
- A47 For purpose of the Bid, the Bidders should assume that they will not be charged discharge fees.
- Q48 Is Contractor required to pay discharge fees solely based on water usage?
- A48 No.
- Q49 Contract Duration The current contract duration is insufficient based on the following:
 - •Given the magnitude of the project coupled with stipulated work hour constraints at each site, an extraordinary and unrealistic amount of resources will be required to work 6 days a week for the duration of the project in order to attempt to meet the current completion date•The limited availability of specialized tunneling workforce given multiple concurrent work activities equates to potential workforce shortages
 - •The application of contractor assumed weather related non-working days (based on historical local weather statistics) to the project schedule exacerbates the schedule challenges
 - •The suggested work sequence in the Contract Documents at the O27 site advises against concurrent work activities prior to IPP Riverwall completion. Concurrent work activities during IPP Installation would be required in order to attempt to meet the current completion date. However, varying from the suggested sequence in the Contract Documents puts an unreasonable amount of risk on the Contractor.

Please add an additional 365 days to all project milestones.

- A49 An additional six months (183 calendar days) will be added to all project milestones. See Section B, Item 20 for CHANGES TO CONTRACT DOCUMENTS.
- Q50 Bid Date Let Extension There are a significant amount of questions that remain unanswered less than a week before the question cut off date. These unanswered questions are critical to the preparation of the bid and the assessment of contractor risk, including but not limited to questions associated with O14 Bypass Work, O27 Riverwall Powerlines, O27 IPP Riverwall, and TBM Work. Given the outstanding unanswered questions and the time required to incorporate question responses into the bid, please extend the bid date an additional 1 Month to now be due on February 26, 2026.
- A50 Please see Addendum 10.

- Unit Price over 15% Addendum-8, answer to question number 51 rejected the time extension by quantity change of the unit prices over 15%. We understand the bid unit price is in effect throughout the entire Contract duration per section 01 22 00-1.2, B but we need time extension so that we can avoid to carry huge contingency. Please consider.
- As stated in the original request "The actual quantity of a unit-priced item exceeding the contractual estimated quantity by 15% or more." does not automatically entitle the Contractor to an extension of time. However, should the Contractor reasonably believe that it is entitled to an extension of time for such an event it may notify the Owner under Article 3, Section 3.34 DELAYS AND EXTENSIONS OF TIME. No changes will be made to the Contract Documents.
- Q52 Liability Limit of Performance and Payment Bond Addendum-8, answer to question number 58 does not accept to rewrite "Surety's total liability under this bond is limited to the penal sum" but Addendum 6 limited the contractor's total liability to 100% of the Contract Value. Thus, the liability of performance bond and payment bond is limited to 100% of the Contract Value. Please confirm.
- A52 This question appears to ask for a legal conclusion and is best directed to your legal counsel.

The Contractor's total liability is being revised to 50% of the Contract Value. This was previously set at 100% in Addendum #6. See Section B, Item 21 CHANGES TO CONTRACT DOCUMENTS.

- Q53 Proposal Page Limit Schedule D Is there a page limit on the "Method Statement" portion of the Bidder Qualification Statement?
- A53 No, there is no page limit.
- Q54 DBE Certification Agency Question 72 in Addendum No. 08 was asked to add additional DBE/MBE certifying agencies because the PAUCP is not accepting new applications at this time. Please reconsider the response and add additional DBE/MBE certifying agencies which will serve to expand the pool of qualified subcontractors and suppliers.
- Although PAUCP has paused accepting new certification applications, there is no change to certification status for existing MBEs, WBEs and DBEs currently certified through PAUCP for participation on non-USDOT work. The Owner will continue to accept DBE, MBE, and WBE certifications from any UCP (interstate or PAUCP), as well as third-party certifiers recognized by the Commonwealth of Pennsylvania, including NMSDC, WBENC, and DGS/BDISBO-recognized entities, for purposes of meeting the contract's participation goals. The Owner does not accept self-certifications.

B. CHANGES TO CONTRACT DOCUMENTS

NOTE: for items with Bid Items changes, a revised Bid Form will be issued in a future Addendum.

1. Article 1 – Bidding Documents, Bid Form, Item 121, Specific Allowance #9 – Additional Traffic Control and Site Security and Railroad Requirements

Item	Description	Unit Price	Total Item Price
121	Specific Allowance #9 – Additional Traffic	Allowance	\$2,300,000.00
	Control and Site Security and Railroad		
	Requirements		

- 2. APPENDIX A TECHNICAL SPECIFICATIONS Section 01 22 00 Measurement and Payment, 3.2 Bid Items, Item 121, Specific Allowance #9 Additional Traffic Control and Site Security and Railroad Requirements
 - a. REVISE BID ITEM 121 (CHANGES ARE NOTED IN RED):

BID ITEM 121. SPECIFIC ALLOWANCE #9 – Additional Traffic Control and Site Security and Railroad Requirements

- 1. This Allowance Item is for Traffic Control and Site Security beyond that identified in the Contract Documents, beyond that identified in other Traffic Control and Site Security BID ITEMs, or beyond that which could have been reasonably expected based on Familiarization of the site and specific Contract Requirements.
- 2. This Allowance Item shall also include costs associated with railroad coordination, review, and training, railroad-required permits and agreements, and railroad-required flaggers and/or railroad-required construction inspectors.
- 3. APPENDIX A TECHNICAL SPECIFICATIONS Section 01 90 00 Railroad Permit Compliance Requirements, 1.3.A, 3.1.A, and 3.1.C.
 - a. REVISE 1.3.A (CHANGES ARE NOTED IN RED):
 - A. The Owner has obtained the railroad permits and agreements for construction the Owner's long-term encroachments or occupancies of the ORT Project in the railroads' rights of way. Comply with the railroads' permits and agreements between each railroad and the Owner.
 - 1. Facility Encroachment Agreement Between CSX Transportation, Inc. and ALCOSAN (Agreement No. CSX 970958 for the Chartiers Creek Tunnel Crossing). Contractor requirements and associated payments include, but are not limited to, notifications, insurance requirements, authorizations for

- proposed field changes, as-built drawings, and coordination for protection services such as railroad-required flaggers or inspectors.
- 2. Facility Encroachment Agreement Between CSX Transportation, Inc. and ALCOSAN (Agreement No. CSX 970960 for the Saw Mill Run Tunnel Crossing). Contractor requirements and associated payments include, but are not limited to, notifications, insurance requirements, authorizations for proposed field changes, as-built drawings, and coordination for protection services such as railroad-required flaggers or inspectors.
- 3. License Agreement Between Norfolk Southern Railway Company and ALCOSAN (Activity Number: 1321691) for three Ohio River Tunnel Crossings and the A48 Adit Crossing. Contractor requirements and associated payments include, but are not limited to, application for entry, notifications, insurance requirements, authorizations for proposed field changes, as-built drawings, and coordination for protection services such as railroad-required flaggers or construction monitoring.
- 4. Occupancy License Agreement (Permit No. POHC240928684) Between The Pittsburgh & Ohio Central Railroad Company (c/o Genesee & Wyoming Railroad Services, Inc.) and ALCOSAN for the Chartiers Creek Tunnel Adit Crossing. Contractor requirements include, but are not limited to, contractor right of entry fee, contractor right of entry license agreement, submittals, notifications, insurance requirements, and as-built drawings.
- 5. Construction and Maintenance Agreement (RR Project #: 23POHC01R) between The Pittsburgh & Ohio Central Railroad Company and ALCOSAN for the Chartiers Creek Tunnel Adit Crossing. Contractor requirements and associated payments include, but are not limited to, construction schedule, notifications, coordination for protection services such as flaggers or inspectors, submittals, roadway worker protection training policy, and contractor safety rules.
- b. REVISE 3.1.A (CHANGES ARE NOTED IN RED):
 - A. Comply with permits, agreements, and approvals obtained by the Owner related to the Work.
- c. REVISE 3.1.C in its entirety (CHANGES ARE NOTED IN RED):
 - C. The Owner will pay the permit and agreement fees for the permits and agreements that the Owner has obtained. The Contractor will pay permit and agreement fees for their construction related activities and permitting.
- 4. APPENDIX A TECHNICAL SPECIFICATIONS, Section 01 45 23, Attachment 2:

- a. DELETE ATTACHMENT 2 List of Utilities for Inspection and Cleaning (7 pages, Revised 09/25/25) and ADD ATTACHMENT 2 List of Utilities for Inspection and Cleaning (8 pages, Revised 12/23/25), which is Attachment A to this Addendum.
- 5. APPENDIX A TECHNICAL SPECIFICAITONS, Section 01 45 23, Part 1.1. ADD Part 1.1.G. in its entirety as follows:
 - a. ADD 1.1.G. in its entirety (CHANGES ARE NOTED IN RED):
 - G. Existing sewers that require sonar inspection are identified in Attachment 2 to this Section.
- APPENDIX A TECHNCIAL SPECIFICAITONS, Section 01 22 00, Bid Item 108 Sewer CCTV, Cleaning and Stabilization is REVISED as follows (CHANGES ARE NOTED IN RED):
 - a. ADD ", and Sewer Sonar Inspection" the BID ITEM 108 heading and ADD the following text to first sentence of BID ITEM 108, 1.a.:

BID ITEM 108. Sewer CCTV, Cleaning and Stabilization, and Sewer Sonar Inspection

- 1. This BID ITEM shall constitute full compensation for furnishing all labor, equipment, and materials necessary to perform:
 - a. Sewer CCTV Inspections, Sewer Sonar Inspections, Cleaning and Stabilization, as required in the Specification Section 01 45 23 Pre-Construction and Post-Construction Inspections, and elsewhere in the Contract Documents.
- b. ADD BID ITEM 108, 2.j. in its entirety as follows:
 - j. Sonar inspection of the sewers to document pre-construction and post-construction conditions.
- 7. APPENDIX A TECHNCIAL SPECIFICAITONS, Section 31 23 19 Control of Groundwater and Construction Water, PART 1 General, 1.8.A is REVISED.
 - a. REVISE the following in Section 31 23 19, Part 1.8.A (Table) as follows (CHANGES ARE NOTED IN RED):

Construction Site	Existing Regulator or MH Number	Discharge Maximum MGD
ORT-AS1	A-58 Regulator	
ORT-A58	A-58 Regulator	3
ORT-A48	PWSA MH008F058	3
SMRT- O41	O-40 Regulator	1
SMRT-O14	MH O-14-PS on O-14W/O-14E Regulator	2

ORT-O27	O-27 Regulator	3
CCT-O07	C-03A Manhole	1
CCTO06A	MRB-0288/0289 Manhole	1.5

- 8. APPENDIX B CONTRACT DRAWINGS.
 - a. DELETE 014-CI-600 (Sheet 519 of 770) and ADD revised 014-CI-600 (Sheet 519 of 770), which is Attachment C of this Addendum.
 - b. DELETE 014-ST-605 (Sheet 545 of 770) and ADD revised 014-ST-605 (Sheet 545 of 770), which is Attachment C of this Addendum.
 - c. DELETE 014-ST-606 (Sheet 546 of 770) and ADD revised O14-ST-606 (Sheet 546 of 770), which is Attachment C of this Addendum.
- 9. APPENDIX A TECHNCIAL SPECIFICAITONS, Section 01 14 19 Use of Sites, PART 3 EXECUTION, 3.1 SITE USE AT ORT O27, B.2. to be DELETED and REPLACED in its entirety.
 - a. DELETE Section 01 14 19, Part 3.B.2 in its entirety and REPLACE Section 01 14 19, Part 3.B.2 in its entirety (CHANGES ARE NOTED IN RED):
 - 2. Assume that DLCO cannot de energize these lines between May 15 and September 15 each year due to seasonal power loads and power consumption. These dates may fluctuate due to operational conditions. Maximum flexibility for the de-energization of the 23 kV power line will be coordinated by the Contractor in real time with the Owner and DLC. A minimum of 15 business days is needed from time of receipt of Contractor's written request for de-energization and the de-energization of the power line.
- 10. APPENDIX A TECHNCIAL SPECIFICAITONS, Section 01 31 13 Project Coordination, PART 3 EXECUTION, 3.7 DUQUESNE LIGHT COMPANY (DLCO), C. has been REVISED.
 - a. REVISE Section 01 31 13, Part 3.7.C as follows (CHANGES ARE NOTED IN RED):
 - C. Coordinate de-energization of overhead transmission lines at O27 and O07 if required during construction. Coordinate de-energization of overhead power lines with the following DLCO points of contact:

Anthony Nolla, PMP DLCO - Sr. Project Manager 412.228.8829 tnolla@duqlight.com

Ms. Collen Karczewski

DLCO - Owner's Representative/POC (412) 935-3701 ckarczewski@duqlight.com

- 11. APPENDIX A TECHNCIAL SPECIFICAITONS, Section 01 22 00 Measurement and Payment, BID ITEM 39 –New Sewer to Existing A58 Regulator for Water Disposal is REVISED.
 - a. ADD Bid Item 39, Part 2 in its entirety as follows; REVISE current Part 2 to be Part "3"; and ADD Part 4 in its entirety as follows (CHANGES ARE NOTED IN RED):

BID ITEM 39. New Sewer to Existing A58 Regulator for Water Disposal

- 1. This item shall include compensation for the new Sewer to existing A58 Regulator for Water Discharge, including but not limited to:
 - a. <u>Provisions of all items in Part 3.1.R Installation of Pipe in Open</u> Trench of this Section.
 - b. Provisions of furnishing and installation of waterproof/sealed and lockable manhole frames, covers, access hatches, as well as manhole rungs and ladder-ups.
 - c. <u>All other work required to provide the New Sewer to Existing A58</u> Regulator for Water Discharge.
- 2. <u>Upon completion of existing A58 regulator inspection, including flap gate inspection, Contractor to submit repair plan and estimate to the Owner for approval prior to repairs.</u>
- 3. Measurement and payment for this BID ITEM will be made in accordance with the requirements for Unit Price Items based on linear foot of installed sewer at invert.
- 4. <u>Upon receipt of Owner approval, Contractor will implement approved repairs to existing A58 regulator and flap gates. Measurement and payment for repairs associated with approved work will be made from BID ITEM 123.</u>

12. APPENDIX B – CONTRACT DRAWINGS.

- a. DELETE A58-ST-406 (Sheet 407 of 770) and ADD revised A58-ST-406 (Sheet 407 of 770), which is Attachment F of this Addendum.
- b. DELETE AS1-CI-503 (Sheet 502 of 770) and ADD revised AS1-CI-503 (Sheet 502 of 770), which is Attachment F of this Addendum.
- c. DELETE AS1-CI-505 (Sheet 504 of 770) and ADD revised AS1-CI-505 (Sheet 504 of 770), which is Attachment F of this Addendum.

13. APPENDIX B – CONTRACT DRAWINGS

- a. DELETE O07-ST-701 (Sheet 590 of 770) and ADD revised O07-ST-701 (Sheet 590 of 770), which is Attachment G of this Addendum.
- 14. APPENDIX A TECHNCIAL SPECIFICATIONS, , Section 03 30 00 Cast-In-Place Concrete, PART 1– GENERAL, 1.4.C. has been DELETED.
 - a. DELETE Section 03 30 00, Part 1.4.C. in its entirety (CHANGES ARE NOTED IN RED):

C. Mockup Panel:

- 1. The Contractor shall produce a mockup wall panel for each approved mix and each finish for approval by the Owner.
- 2. Wall mockup panel shall be of sufficient size to replicate formwork, placement procedures, and quality of finish. Panel shall be no less than 2 feet wide by 4 feet high and 8 inches thick. Mockup panel shall contain reinforcement.
- 3. Concrete patching, such as for form tie holes, shall be applied to the wall mockup for approval.
- 4. For concrete mixes that incorporate Type 1L cement, the Contractor shall produce a slab mockup for each approved mix.
- 5. Minimum slab dimensions shall be 12 feet by 12 feet by 3 feet.
- 6. Placement procedures, finishing equipment, and curing shall be identical to those that will be used on final production slabs. Changes in procedures, etc. may require additional slabs to be produced.
- 7. Mockup may be used for acceptance and rejection of concrete finishes. It is critical that the mockups match the actual anticipated finishes. A different finish may be applied to each side of the mockup panel.
- 8. Mockup panels shall remain onsite for the duration of the project or until final acceptance of all concrete placements related to associated mix.

 Owner shall be notified for agreement prior to panel demolition.
- 9. Mockup panels and slabs that fail to meet acceptable quality shall be reconstructed with procedures being adjusted until panels/slabs are accepted.

15. APPENDIX B - CONTRACT DRAWINGS

- a. DELETE ORT-ST-103 (Sheet 103 of 770) and ADD revised ORT-ST-103 (Sheet 103 of 770), which is Attachment H of this Addendum.
- b. DELETE ORT-ST-500 (Sheet 152 of 770) and ADD revised ORT-ST-500 (Sheet 152 of 770), which is Attachment H of this Addendum.

16. APPENDIX B - CONTRACT DRAWINGS

a. DELETE ORT-ST-200 (Sheet 117 of 770) and ADD revised ORT-ST-200 (Sheet 117 of 770), which is Attachment I of this Addendum.

- b. DELETE ORT-ST-300 (Sheet 130 of 770) and ADD revised ORT-ST-300 (Sheet 130 of 770), which is Attachment I of this Addendum.
- c. DELETE ORT-ST-400 (Sheet 141 of 770) and ADD revised ORT-ST-400 (Sheet 141 of 770), which is Attachment I of this Addendum.
- d. DELETE ORT-ST-600 (Sheet 159 of 770) and ADD revised ORT-ST-600 (Sheet 159 of 770), which is Attachment I of this Addendum.
- e. DELETE ORT-ST-700 (Sheet 169 of 770) and ADD revised ORT-ST-700 (Sheet 169 of 770), which is Attachment I of this Addendum.
- f. DELETE ORT-ST-800 (Sheet 179 of 770) and ADD revised ORT-ST-800 (Sheet 179 of 770), which is Attachment I of this Addendum.
- 17. REVISE Article 2; Section 2.06 SUBMISSION AND OPENING OF BIDS. ADD after last paragraph. (CHANGES ARE NOTED IN RED):

 If the Notice to Proceed exceeds 180 calendar days from the bid submission date, the Contractor may submit a request under the provisions in General Contract Conditions Article 3.32. for escalation of bid costs, but not time.
- 18. REVISE Article 2; Section 2.07 AWARD AND CONTRACT EXECUTION. ADD after last paragraph. (CHANGES ARE NOTED IN RED):

If the Notice to Proceed exceeds 360 calendar days from the bid submission date, the Contractor may elect to terminate. A 60-calendar day notice of intent to terminate must be provided by the Contractor.

19. REVISE Article 3; Section 3.34. A.10. DELAYS AND EXTENSION OF TIME. DELETE the following text after "the Work" as shown below; CHANGES ARE DENOTED IN RED TEXT:

Order of any court of competent jurisdiction enjoining the performance of the Work. that is not sought by Contractor in accordance with the Contract Documents.

20. ARTICLE 4 – BID DOCUMENTS, CONTRACT AGREEMENT, Item 2. (page 4-2); 183 Calendar days are being added to the Construction Milestone. CHANGES ARE DENOTED IN RED TEXT:

The Contractor further agrees and acknowledges that time is of the essence of the Contract and that Contractor shall commence the Work immediately upon receipt of the Notice to Proceed and shall prosecute the Work diligently to Final Completion of the entire Work within 2,162 2,345 calendar days ("Contract Time") and as specified for Interim Milestone #1 and Substantial Completion of the Work as set forth below:

Construction Milestone	Contract Time Calendar Days	Notes
Interim Milestone #1 –	1,634 days	From Notice to Proceed
Demobilize AS1 Site	1,817 days	
Substantial Completion of	2,043 days	From Notice to Proceed
Contract 1797	2,226 days	
Final Completion of	2,162 days	From Notice to Proceed
Contract 1797	2,345 days	

21. CONTRACT DOCUMENTS, Article 3SC – Article 3.61 LIMITATION OF LIABILITY and ADDENDUM #6 (Q8/A8 and CHANGES TO CONTRACT DOCUMENTS ITEM 4)

AMEND ADDENDUM #6, CHANGES TO CONTRACT DOCUMENTS, ITEM 4 (CHANGES ARE DENOTED IN RED):

ADD the following in its entirety at the end of Article 3.61, 1st paragraph on page 3-69

The Contractor's total liability for all claims will be limited to 100% 50% of the Contract value, but will not apply to any amounts expressly payable pursuant to this Contract or any amounts entitled to be set-off, or Contractor's liability, to the extent that:

- A. Such losses have been covered by insurance pursuant to this Contract.
- B. Such losses are covered by the proceeds of insurance carried by the Contractor regardless of whether such policies are required pursuant to this Contract.
- C. Under any indemnity pursuant to this Contract where such indemnity relates to claims asserted and/or losses suffered by any third party including those listed as indemnified parties in Article 3SC, Section 3.10, Indemnification.
- D. Loss arising out of fraud, willful misconduct, recklessness, criminal conduct, bad faith or gross negligence.

Addendum No. 11

Attachment A - TECHNICAL SPECIFICATIONS

• Section 01 45 23, Attachment 2 – List of Utilities for Inspection and Cleaning

					Inspection and Cleani			Revised 12/29/2025	
			Descr	ription	Existing Constructed	Extent(s) of Inspection/Clean			
Site	Facility(s)	Facility Owner	Type/ Dia.	Exposure to river pool	Access	Upstream (US)	Downstream (DS)	Approx. Dimension(s)	
O27	Existing O27 Combined Sewer Flow Regulator	ALCOSAN	Concrete structure with hydro- mechanical equipment	Partially below normal river pool. Internal flap gate. Gate condition unknown.	Manhole(s) at grade	Structure inlet(s)	Structure outlet(s)	30 feet x 25 feet x 20 feet (WxLxD)	
O27	Existing O27 Combined Sewer Outfall	ALCOSAN	144-inch dia. brick sewer	Fully below normal river pool. No flap gate.	None	Manhole, ALCOSAN MH 044B002	Outfall, ALCOSAN OF 044BO27	350 feet (L)	
027	Existing Sanitary Sewer	ALCOSAN	144-inch dia. unk sewer			Manhole, ALCOSAN MH ADC044B027B	Manhole, ALCOSAN MH ADC044B027C	16 feet (L)	
O27	Existing Sanitary Sewer	Unknown	15-inch dia. PVC sewer			Manhole, Unknown MH 075P001	Junction, Unknown JCT 044B001	266 feet (L)	
O27	Existing Combined Sewer	PWSA	36-inch dia. RCP sewer			Manhole, PWSA MH 075R053	Outfall, PWSA OF OF075P001	392 feet (L)	
				5 11 1 1					
O41	Existing O41 Combined Sewer Flow Regulator	ALCOSAN	Concrete structure with hydro- mechanical equipment	Partially below normal river pool. Internal flap gate. Gate condition unknown.	Manhole(s) at grade	Structure inlet(s)	Structure outlet(s)	6 feet x 15 feet x 15 feet (WxLxD)	
041	Existing O41- Combined Sewer- Outfall	PWSA	4-foot dia. brick sewer	Fully below normal river pool. No flap gate.	None	Manhole, ALCOSAN- MH ADC007F041	Outfall, ALCOSAN- OF 007KO41	40 feet (L)	
O41	Existing Storm Sewer	PWSA	24-inch dia. RCP sewer			Manhole, PWSA MH 007F059	Manhole, PennDOT MH 007F078	142 feet (L)	
O41	Existing Storm Sewer	PennDOT	48-inch dia. RCP sewer			Manhole, PennDOT MH 007F097	Manhole, PennDOT MH 007F078	126 feet (L)	
O41	Existing Storm Sewer	PennDOT	18-inch dia. RCP sewer			Manhole, PennDOT MH 007F005	Manhole, PennDOT MH 007F078	41 feet (L)	
O41	Existing Storm Sewer	PennDOT	30-inch dia. RCP sewer			Manhole, PennDOT MH 007F064	Manhole, PennDOT MH 007F078	193 feet (L)	
O41	Existing Storm Sewer	PennDOT	18-inch dia. RCP sewer			Manhole, PennDOT MH 007F006	Manhole, PennDOT MH 007F078	95 feet (L)	
041	Existing Storm Sewer	PennDOT	54-inch dia. RCP sewer	-		Manhole, PennDOT- MH 007F078	Outfall, ALCOSAN OF 007KO40	471 feet (L)	
O41	Existing Storm Sewer	PennDOT	54-inch dia. RCP sewer			Manhole, PennDOT MH 007F078	Manhole, PennDOT MH 007F074	385 feet (L)	
O41	Existing Storm Sewer	PennDOT	54-inch dia. RCP sewer**			Manhole, PennDOT MH 007F074	Outfall, ALCOSAN OF 007KO40	86 feet (L)	
O41	Existing Combined Sewer	PWSA	18-inch dia. VCP sewer			Manhole, PWSA MH 007F051	Manhole, ALCOSAN MH ADC007F040	211 feet (L)	
O41	Existing Outfall Sewer	ALCOSAN	18-inch dia. VCP sewer			Manhole, ALCOSAN MH ADC007F040	Manhole, PennDOT MH 007F074	73 feet (L)	
O41	Existing Sanitary Sewer	PWSA	15-inch dia. PVC sewer			Manhole, PWSA MH 007G130	Manhole, ALCOSAN MH ADC007F040	788 feet (L)	

^{*}Sewer data reflects ORT survey data, received Alcosan GIS data (dated 04/11/2021), and received PWSA GIS data (dated 10/06/2015).

 $[\]ensuremath{^{**}}\mbox{Sewer}$ is to be inspected using sonar technology.

			ATTACHMEN	Γ 2 - List of Utilities for	r Inspection and Cleani			Revised 12/29/2025
			Description		Existing Constructed	Exte		
Site	Facility(s)	Facility Owner	Type/ Dia.	Exposure to river pool	Access	Upstream (US)	Downstream (DS)	Approx. Dimension(s)
O41	Existing Combined Sewer	ALCOSAN	8-inch dia. VCP sewer			Manhole, ALCOSAN MH ADC007F041	Manhole, PWSA MH 007F073	329 feet (L)
O41	Existing Combined Sewer	PWSA	24-inch dia. BR sewer			Manhole, PWSA MH 007G108	Manhole, ALCOSAN MH ADC007F041	414 feet (L)
O41	Existing Combined Sewer	PWSA	15-inch dia. VCP sewer			Manhole, PWSA MH 007F007	Manhole, PWSA MH 007F008	34 feet (L)
O41	Existing Combined Sewer	PWSA	36-inch dia. RCP & 48- inch dia. BR sewer			Manhole, PWSA MH 007F063	Manhole, ALCOSAN MH ADC007F041	225 feet (36-inch) & 33 feet (48-inch) (L)
A48	Existing Combined Sewer	PWSA	54"x72" brick Sewer	Above normal river pool. Flap gate at downstream flow regulator outfall. Gate condition unknown.	Manhole(s) at grade	Manhole, PWSA MH 008F002	Junction, PWSA JCT 008F092	633 feet (L)
A48	Existing A48 Combined Sewer	PWSA	108-inch dia. brick sewer w/gunite lining	Above normal river pool. Flap gate at downstream flow regulator outfall. Gate condition unknown.	Manhole(s) at grade	Manhole, PWSA MH 008F074	Manhole, PWSA MH 008G134	785 feet (L)
A48	Existing Combined Sewer	PWSA	15-inch dia. VCP sewer			Manhole, PWSA MH 008F003	Manhole, PWSA MH 008F059	93 feet (L)
A48	Existing Combined Sewer	PWSA	36-inch dia. UNK & 108-inch dia. BR sewer			Manhole, PWSA MH 008G067	Manhole, PWSA MH 008G070	306 feet (36-inch) & 39 feet (108-inch) (L)
A48	Existing Combined Sewer	PWSA	48-inch dia. RCP sewer			Manhole, PWSA MH 008G080	Manhole, PWSA MH 008G070	16 feet (L)
A48	Existing Combined Sewer	PWSA	18-inch dia. RCP & 24-inch dia. RCP sewer			Endcap, PWSA EC 008F004	Manhole, PWSA MH 008G074	17 feet (18-inch) & 361 feet (24-inch) (L)
A48	Existing Combined Sewer	PennDOT	21-inch dia. RCP, 24- inch dia. RCP, 27- inch, & 30-inch RCP sewer			Manhole, PennDOT MH 008F083	Manhole, PennDOT MH 008G137	233 feet (21-inch), 151 feet (24-inch), 246 feet (27-inch), & 83 feet (30-inch)
A48	Existing Storm Sewer	PWSA	15-inch dia. PVC & 14- inch dia. DIP sewer			Manhole, PWSA MH 008F109	54"x72" Brick Sewer Connection	24 feet (15-inch) & 31 feet (14-inch) (L)
A48	Existing Combined Sewer	PWSA	15-inch dia. VCP sewer			Manhole, PWSA MH 008F058	Junction, PWSA JCT 008F071	21 feet (L)
A48	Existing Combined Sewer	PWSA	15-inch dia. VCP sewer			Manhole, PWSA MH 008F079	Junction, PWSA JCT 008F068	145 feet (L)

^{*}Sewer data reflects ORT survey data, received Alcosan GIS data (dated 04/11/2021), and received PWSA GIS data (dated 10/06/2015).

 $[\]ensuremath{^{**}}\mbox{Sewer}$ is to be inspected using sonar technology.

			ATTACHMEN	T 2 - List of Utilities for	r Inspection and Clean	ing*		Revised 12/29/2025
			Desci	Description		Existing Constructed Ext		ing
Site	Facility(s)	Facility Owner	Type/ Dia.	Exposure to river	Access	Upstream (US)	Downstream (DS)	Approx.
			Type Dim	pool		epsireum (es)	201111111111111111111111111111111111111	Dimension(s)
A58	Existing A58 Combined Sewer (Madison Ave.)	ALCOSAN	102-inch dia. brick sewer w/gunite lining	Below normal river pool. Flap gate at downstream flow regulator outfall. Gate condition unknown.	Manhole(s) at grade	Manhole, ALCOSAN MH 009A100	A58 Outfall, ALCOSAN OF ACSO009EA58	651 feet (L)
A58	Existing Combined Sewer Outfall (Voeghtly St.)	PennDOT	10-foot x 12-foot (HxW) reinforced concrete box culvert	Varies from fully (at outfall) to partially (upstream) below normal river pool. No flap gate.	None	Manhole, Unknown MH 009A0099	Manhole, Unknown MH 009E087	1051 feet (L)
A58	Existing Combined Sewer (E. Lacock St.)	PWSA	15-inch dia. VCP sewer	Below normal river pool. Flap gate at downstream flow regulator outfall. Gate condition unknown.	Manhole(s) at grade	Manhole, PWSA MH 009A071	Direct connection to existing A58 Combined Sewer (Madison Ave.), PWSA JCT009A015	205 feet (L)
A58	Existing Combined Sewer (Voeghly St.)	PWSA	15-inch dia. VCP sewer	Below normal river pool. Flap gate at downstream flow regulator outfall. Gate condition unknown.	Manhole(s) at grade	Manhole, PWSA MH 009A009	Manhole, PWSA MH 009E064	537 feet (L)
A58	Existing Combined Sewer	Unknown	15-inch dia. UNK sewer			End Cap, Unknown EC 009A004	Manhole, PWSA MH 009A016	74 feet (L)
A58	Existing Combined Sewer	PWSA	15-inch dia. VCP sewer			Manhole, PWSA MH 009A015	Manhole, PWSA MH 009B026	327 feet (L)
A58	Existing Combined Sewer	PWSA	15-inch dia. VCP sewer			Manhole, PWSA MH 009B038	Junction, PWSA JCT 009E027	292 feet (L)
AS1	Existing Combined Sewer (Warfield Street)	PWSA	24-inch dia. VCP Sewer	MH invert above normal river pool. Flap gate at downstream flow regulator outfall. Gate condition unknown.	Manhole(s) at grade	Manhole, PWSA MH 009B022	Manhole, PWSA MH 009B036	451 feet (L)
AS1	Existing Combined Sewer (Carpenter Way)	PWSA	15-inch dia. VCP Sewer	MH invert above normal river pool. Flap gate at downstream flow regulator outfall. Gate condition unknown.	Manhole(s) at grade	Manhole, PWSA MH 024P150	Manhole, PWSA MH 009B022	572 feet (L)
AS1	Existing Combined Sewer (Carpenter Way)	PWSA	15-inch dia. VCP Sewer	MH invert above normal river pool. Flap gate at downstream flow regulator outfall. Gate condition unknown.	Manhole(s) at grade	Endcap, PWSA EC 009B003	Manhole, PWSA MH 009B022	103 feet (L)

^{*}Sewer data reflects ORT survey data, received Alcosan GIS data (dated 04/11/2021), and received PWSA GIS data (dated 10/06/2015).

^{**}Sewer is to be inspected using sonar technology.

	<u> </u>				· Inspection and Cleani		(() CT (CT	Revised 12/29/2025	
G*:	F		Description		Existing Constructed	Extent(s) of Inspection/Clean			
Site	Facility(s)	Facility Owner	Type/ Dia.	Exposure to river pool	Access	Upstream (US)	Downstream (DS)	Approx. Dimension(s)	
AS1	Existing Combined Sewer	ALCOSAN	8-inch dia. VCP Sewer			Manhole, ALCOSAN MH A-59Z-02	Manhole, ALCOSAN MH ADC009BA59A	255 feet (L)	
AS1	Existing Combined Sewer	PWSA	15-inch dia. VCP Sewer			Manhole, PWSA MH 009B026	Manhole, PWSA MH 009B027	129 feet (L)	
AS1	Existing Combined Sewer	PWSA	15-inch dia. VCP Sewer			Manhole, PWSA MH 009B076	Manhole, PWSA MH 009B027	562 feet (L)	
O14	Existing O14 Combined Sewer Flow Regulator	ALCOSAN	Concrete structure with hydro- mechanical equipment	Partially below normal river pool. Internal flap gate. Gate condition unknown.	Manhole(s) at grade	Structure inlet(s)	Structure outlet(s)	35 feet x 35 feet x 15 feet (WxLxD)	
O14	Existing O14 Combined Sewer (East)	ALCOSAN	42-inch dia. RCP sewer	Below normal river pool. Flap gate at downstream flow regulator outfall. Gate condition unknown.	Manhole(s) at grade	Manhole, ALCOSAN MH N03	Manhole, ALCOSAN MH O-14-PS	385 feet (L)	
O14	Existing O14 Combined Sewer (West)	ALCOSAN	48-inch dia. RCP sewer	Below normal river pool. Flap gate at downstream flow regulator outfall. Gate condition unknown.	Manhole(s) at grade	Manhole, ALCOSAN MH 1A	Manhole, ALCOSAN MH O-14-PS	537 feet (L)	
014	Existing Combined- Sewer (Riverside St.)	PWSA	15-inch dia. VCP- sewer & 30-inch dia. RCP-sewer	Below normal river- pool. Flap gate at- downstream flow- regulator outfall. Gate- condition unknown.	Manhole(s) at grade	Manhole, PWSA MH-007P029	Manhole, ALCOSAN- MH 1D	625 feet (15-inch) & 12 feet (30-inch) (L)	
O14	Existing Combined Sewer (Riverside St.)	PWSA	15-inch dia. VCP sewer		Manhole(s) at grade	Manhole, PWSA MH 007P029	Manhole, ALCOSAN MH 007P023	590 feet (L)	
O14	Existing Combined Sewer Outfall	ALCOSAN	48-inch dia. RCP sewer**			Manhole, ALCOSAN MH O-14-PS	Outfall, ALCOSAN OF O-14	160 feet (L)	
O14	Existing Combined Sewer Outfall	ALCOSAN	42-inch dia. RCP sewer**			Manhole, ALCOSAN MH O-14-PS	Outfall, ALCOSAN OF O-14A	155 feet (L)	
O14	Existing Combined Sewer	PWSA	24-inch dia.VCP sewer			Manhole, PWSA MH 006B043	Manhole, ALCOSAN MH N02	676 feet (L)	
014	Existing Combined Sewer	ALCOSAN	54-inch dia. RCP sewer			Manhole, ALCOSAN- MH O-14-PS	Manhole, ALCOSAN MH ADC007P014A	13 feet (L)	
O06A	Existing Combined Sewer (Shingiss St, south of Ella St.)	McKees Rocks	12-inch dia. VCP sewer	Below normal river pool. Downstream river backflow controlled by Ella St. pump station.	Manhole(s) at grade	Manhole, MROCK MH 0287	Manhole, MROCK MH 0324	834 feet (L)	

^{*}Sewer data reflects ORT survey data, received Alcosan GIS data (dated 04/11/2021), and received PWSA GIS data (dated 10/06/2015).

 $[\]ensuremath{^{**}}\mbox{Sewer}$ is to be inspected using sonar technology.

			ATTACHMEN	Γ 2 - List of Utilities for	r Inspection and Cleani	ng*		Revised 12/29/2025
				ription	Existing Constructed		nt(s) of Inspection/Clear	
Site	Facility(s)	Facility Owner	Type/ Dia.	Exposure to river pool	Access	Upstream (US)	Downstream (DS)	Approx. Dimension(s)
O06A	Existing Combined Sewer	McKees Rocks	60-inch dia. brick sewer	Below normal river pool. Downstream river backflow controlled by Ella St. pump station.	Manhole(s) at grade	Manhole, MROCK MH 0340	Manhole, MROCK MH 0295A	696 feet (L)
O06A	Existing Combined Sewer	McKees Rocks	15-inch dia. VCP sewer			Manhole, MROCK MH 0292	Manhole, MROCK MH 0340A	254 feet (L)
O06A	Existing Combined Sewer	McKees Rocks	12-inch dia. VCP sewer			Manhole, Unknown UK_MH-1	Manhole, MROCK MH 0295	193 feet (L)
O06A	Existing Combined Sewer	McKees Rocks	12-inch dia. VCP sewer			Manhole, MROCK MH 0322	Manhole, MROCK MH 0295	289 feet (L)
O06A	Existing Combined Sewer	McKees Rocks	12-inch dia. VCP sewer			Manhole, MROCK MH 0332	Manhole, MROCK MH 0334	376 feet (L)
O06A	Existing Combined Sewer	McKees Rocks	12-inch dia. VCP sewer			Manhole, MROCK MH 0320	Manhole, MROCK MH 0335	389 feet (L)
O06A	Existing Combined Sewer	McKees Rocks	18-inch RCP & 18- inch dia. VCP sewer			Manhole, MROCK MH 0282	Manhole, MROCK MH 0283	170 feet (RCP) & 143 feet (VCP) (L)
O06A	Existing Combined Sewer	McKees Rocks	12-inch dia. VCP sewer			Manhole, MROCK MH 0464	Manhole, MROCK MH 0328	417 feet (L)
O06A	Existing Combined Sewer	McKees Rocks	15-inch dia. VCP sewer			Manhole, MROCK MH 0318	Manhole, MROCK MH 0328	227 feet (L)

^{*}Sewer data reflects ORT survey data, received Alcosan GIS data (dated 04/11/2021), and received PWSA GIS data (dated 10/06/2015).

 $[\]ensuremath{^{**}}\mbox{Sewer}$ is to be inspected using sonar technology.

	, , , , , , , , , , , , , , , , , , , 				Inspection and Cleani			Revised 12/29/2025
6:4	E924 ()	Eilia O	Descr	iption .	Existing Constructed	Exte	nt(s) of Inspection/Clear	
Site	Facility(s)	Facility Owner	Type/ Dia.	Exposure to river pool	Access	Upstream (US)	Downstream (DS)	Approx. Dimension(s)
O06A	Existing Combined Sewer	McKees Rocks	18-inch dia. VCP sewer			Manhole, MROCK MH 0326	Dropshaft, ALCOSAN DS O-06	1267 feet (L)
O06A	Existing Combined Sewer	McKees Rocks	18-inch & 36-inch dia. VCP sewer		-	Manhole, MROCK MH 0285	Manhole, MROCK MH 0329A	991 feet (18-inch) & 5 feet (36-inch) (L)
O06A	Existing Combined Sewer	McKees Rocks	36-inch dia. CP sewer			Manhole, MROCK MH 0535	Manhole, MROCK MH 0329	222 feet (L)
006A	Existing Combined- Sewer	McKees Rocks	36-inch & 24-inch &- 18-inch dia. VCP- sewer	-	-	Manhole, MROCK- MH-0329	Outfall, MROCK O-06	44 feet (36-inch) & 60 feet (24-inch) & 395- feet (18-inch) (L)
O06A	Existing Combined Sewer	McKees Rocks	36-inch & 24-inch & 18-inch dia. VCP sewer			Manhole, MROCK MH 0329	Manhole, MROCK MH O-06-04	44 feet (36-inch) & 60 feet (24-inch) & 215 feet (18-inch) (L)
O06A	Existing Combined Sewer	McKees Rocks	18-inch dia. VCP sewer**			Manhole, MROCK MH O-06-04	Outfall, MROCK O-06	180 feet (L)
O06A	Existing Combined Sewer	McKees Rocks	36-inch dia. UNK sewer			Manhole, MROCK MH 0329A	Outfall, MROCK OF Robb St PS	473 feet (L)
007	Existing Combined- Sewer	McKees Rocks	24-inch dia. VCP- sewer	Below normal river pool. Flap gate at- downstream flow- regulator outfall. Gate- condition unknown.	Manhole(s) at grade	Manhole, MROC MH- 0366A	C-04 flow regulator, ALCOSAN C-04-00	483 feet (L)
O07	Existing Combined Sewer	McKees Rocks	24-inch dia. VCP sewer	Below normal river pool. Flap gate at downstream flow regulator outfall. Gate condition unknown.	Manhole(s) at grade	Manhole, MROC MH 0366A	Regulator, ACSA RG C-04-00	469 feet (L)
007	Existing Combined	McKees Rocks	24-inch dia. VCP	-	_	Regulator, ACSA	Outfall, ACSA	14 feet
	Sewer Existing Combined		sewer 18-inch dia. VCP			RG C-04-00 Manhole, MROC	OF C-04-00 Manhole, MROC	(L) 258 feet
O07	Sewer	McKees Rocks	sewer			MH 0367	MH 0370	(L)
O07	Existing Combined Sewer	ALCOSAN	8-inch dia. CAS sewer			Manhole, ACSA MH C-03A-00	Regulator, ASCA RG C-04-00	24 feet (L)

^{*}Sewer data reflects ORT survey data, received Alcosan GIS data (dated 04/11/2021), and received PWSA GIS data (dated 10/06/2015).

 $[\]ensuremath{^{**}}\mbox{Sewer}$ is to be inspected using sonar technology.

	ATTACHMENT 2 - List of Utilities for Inspection and Cleaning* Re										
			Descr	iption	Existing Constructed	Exte	nt(s) of Inspection/Clear	ning			
Site	Facility(s)	Facility Owner	Type/ Dia.	Exposure to river pool	Access	Upstream (US)	Downstream (DS)	Approx. Dimension(s)			
007	Existing Combined Sewer	ALCOSAN	36-inch & 34-inch dia. RCP sewer		1	Manhole, ACSA MH C-03A-00	Outfall, ASCA OF C-03A-OVF	17 feet (36-inch) & 15- feet (34-inch) (L)			
O07	Existing Combined Sewer	ALCOSAN	8-inch dia. CAS sewer			Regulator, ACSA RG C-03-00	Manhole, ACSA MH C-03A-00	181 feet (L)			
O07	Existing Combined Sewer	PWSA	18-inch dia. VCP sewer			Manhole, PWSA MH 043S001	Regulator, ACSA RG C-03-00	149 feet (L)			
O07	Existing Combined Sewer	ALCOSAN & PWSA	8-inch dia. CAS & 15-inch dia. UNK sewer			Manhole, PWSA MH 043S013	Regulator, ACSA RG C-03-00	102 feet (8-inch) & 98 feet (15-inch) (L)			

^{*}Sewer data reflects ORT survey data, received Alcosan GIS data (dated 04/11/2021), and received PWSA GIS data (dated 10/06/2015).

 $[\]ensuremath{^{**}}\mbox{Sewer}$ is to be inspected using sonar technology.

Attachment B

APPENDIX E – SUPPLEMENTAL INFORMATION (FOR INFORMATION ONLY)

SECTION 10


• Utility Inspection Coverage Exhibits (9 sheets including Appendix E – Supplemental Information fly sheet)


Attachment B


APPENDIX E – SUPPLEMENTAL INFORMATION (FOR REFERENCE ONLY)


SECTION 10


Utility Inspection Coverage Exhibits

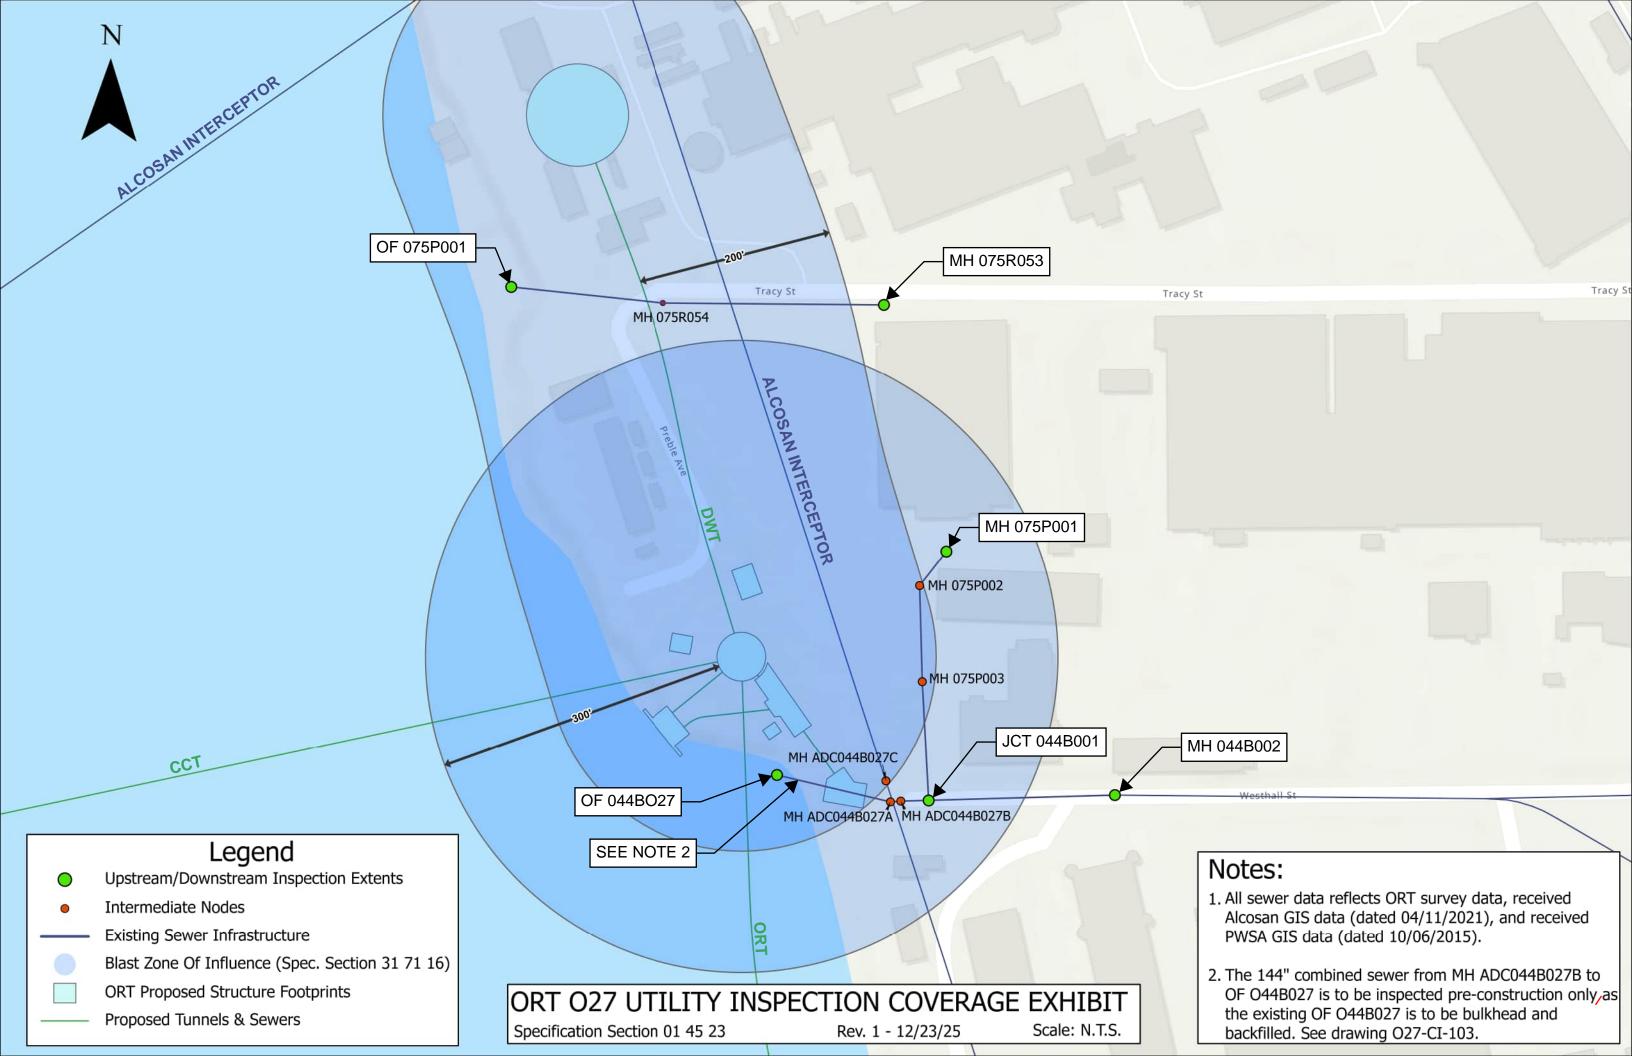


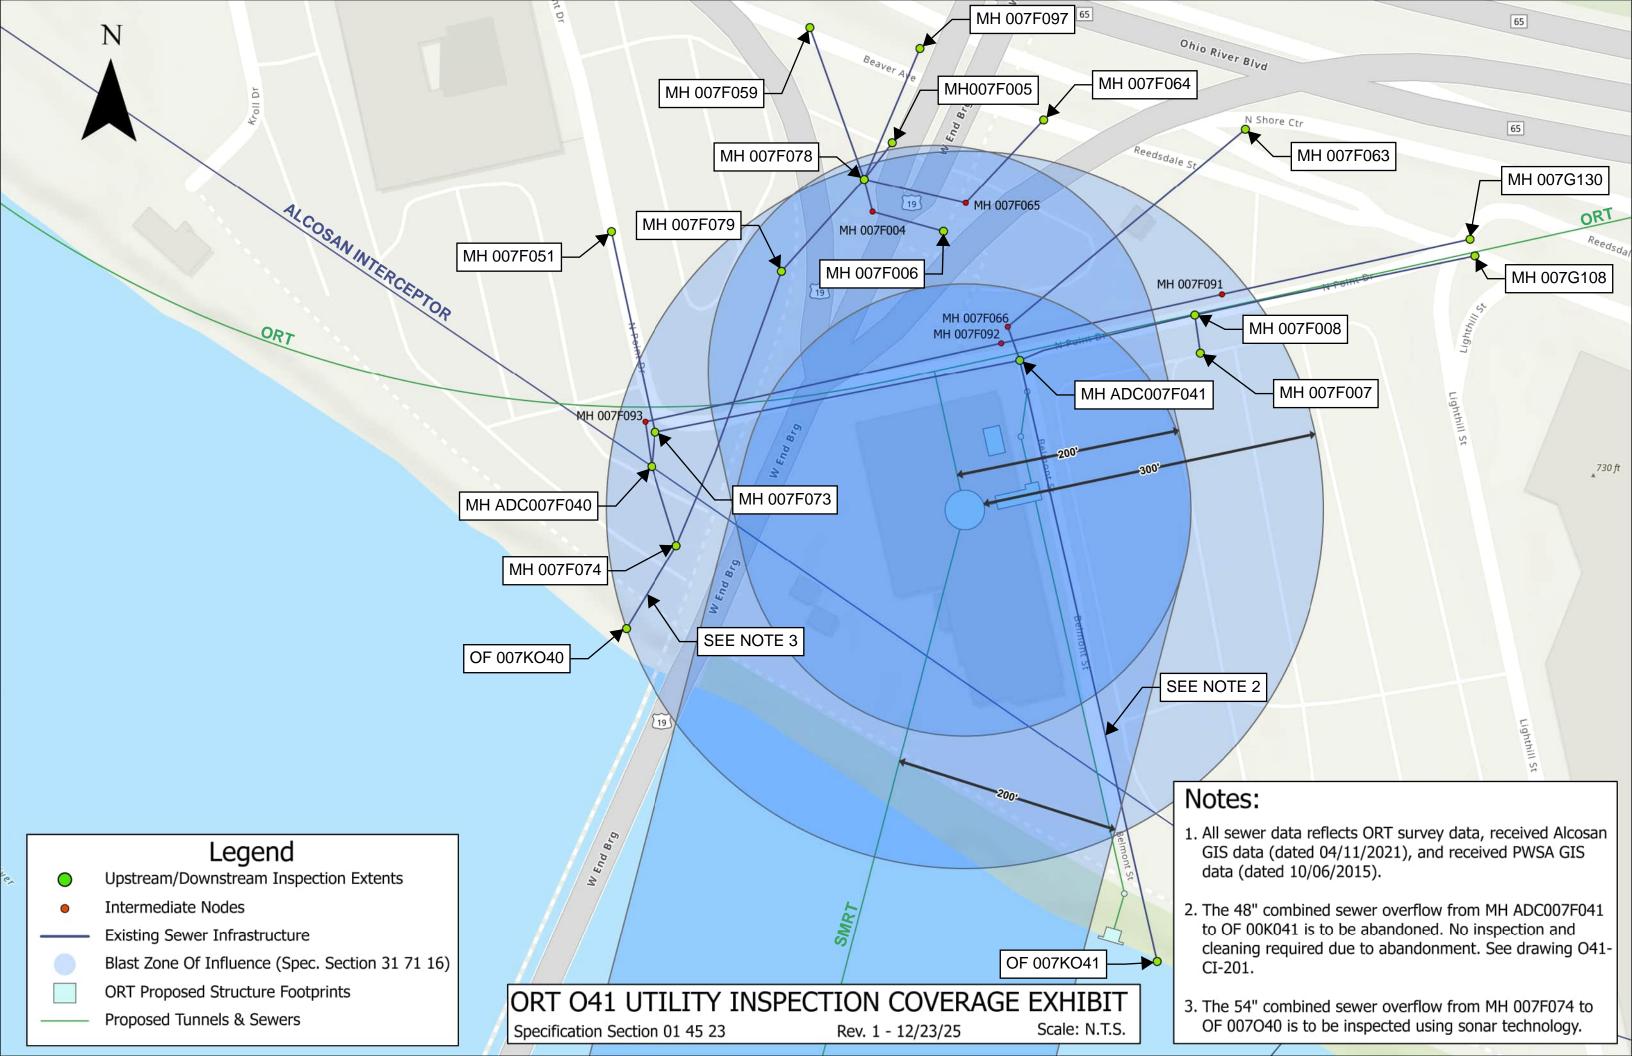


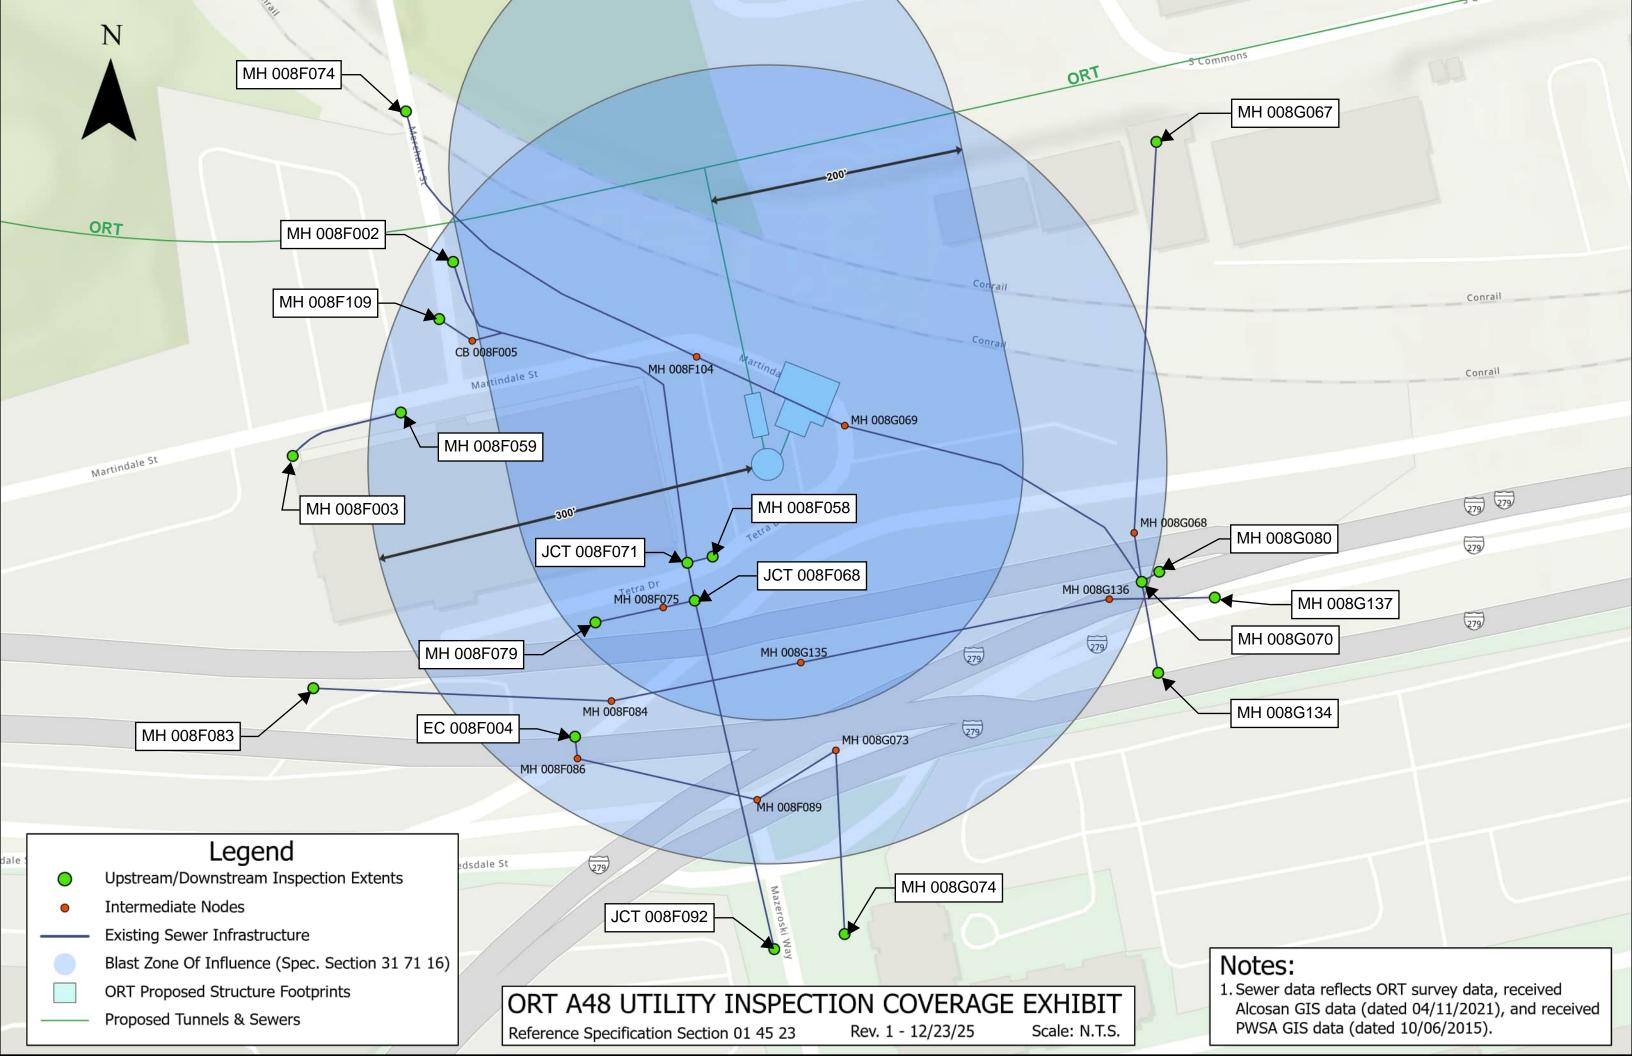


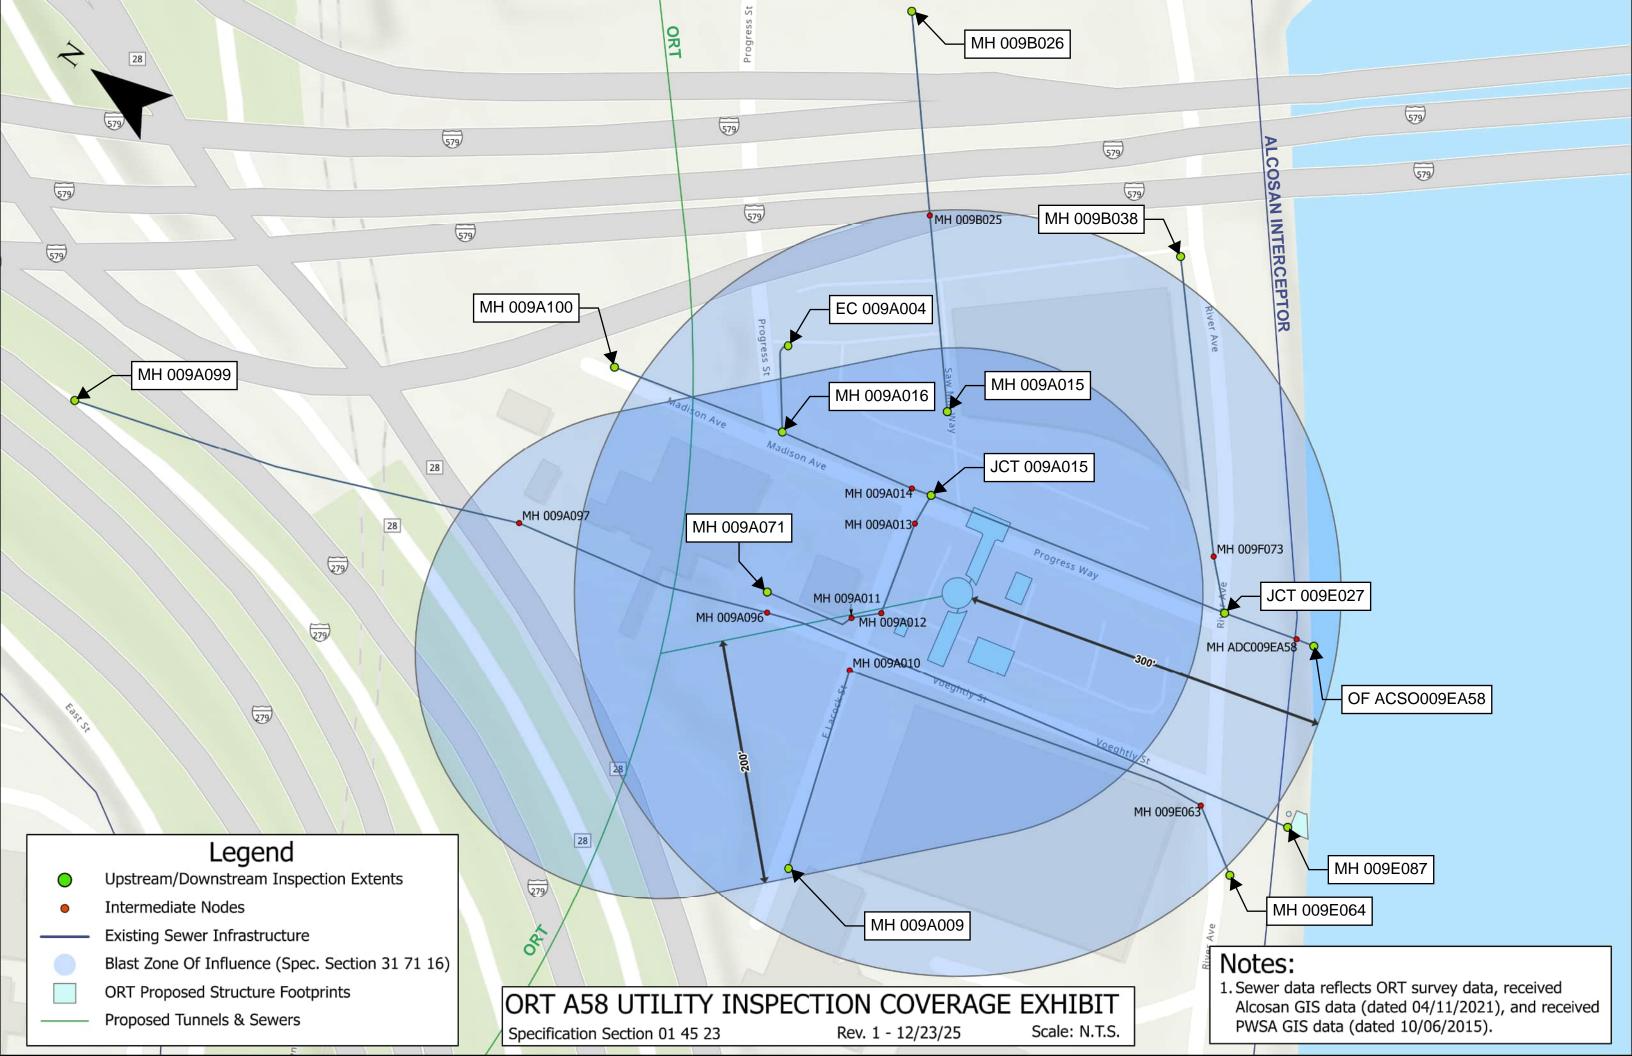

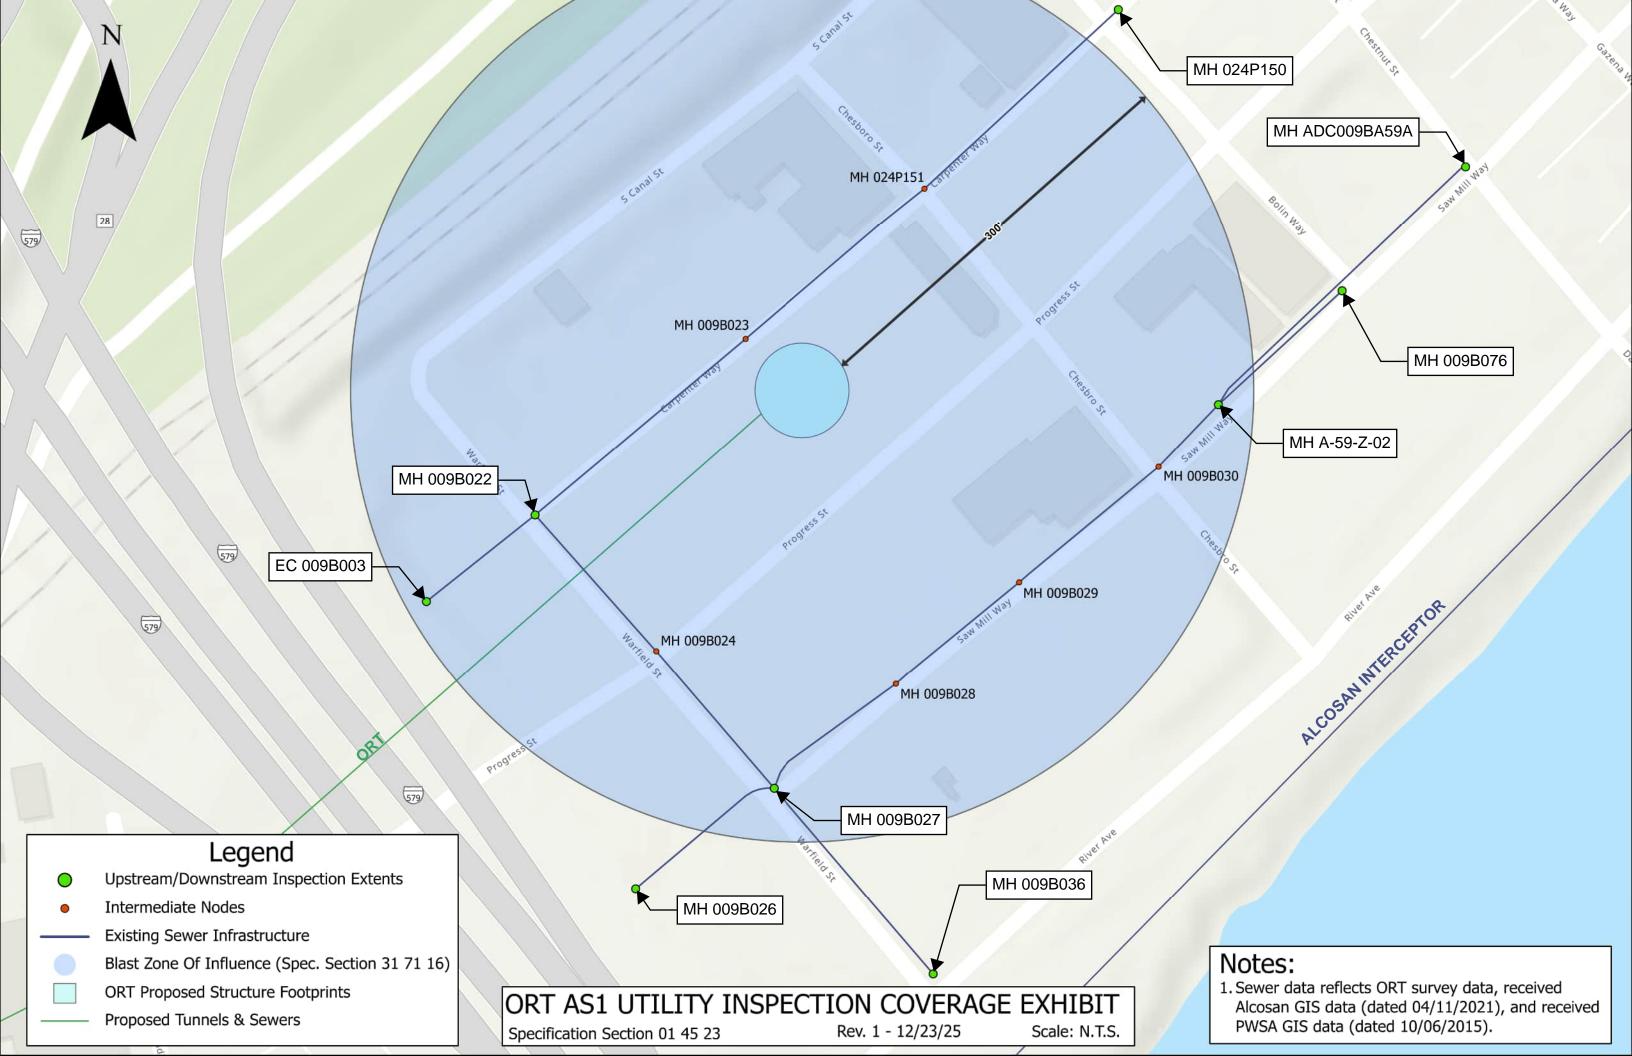

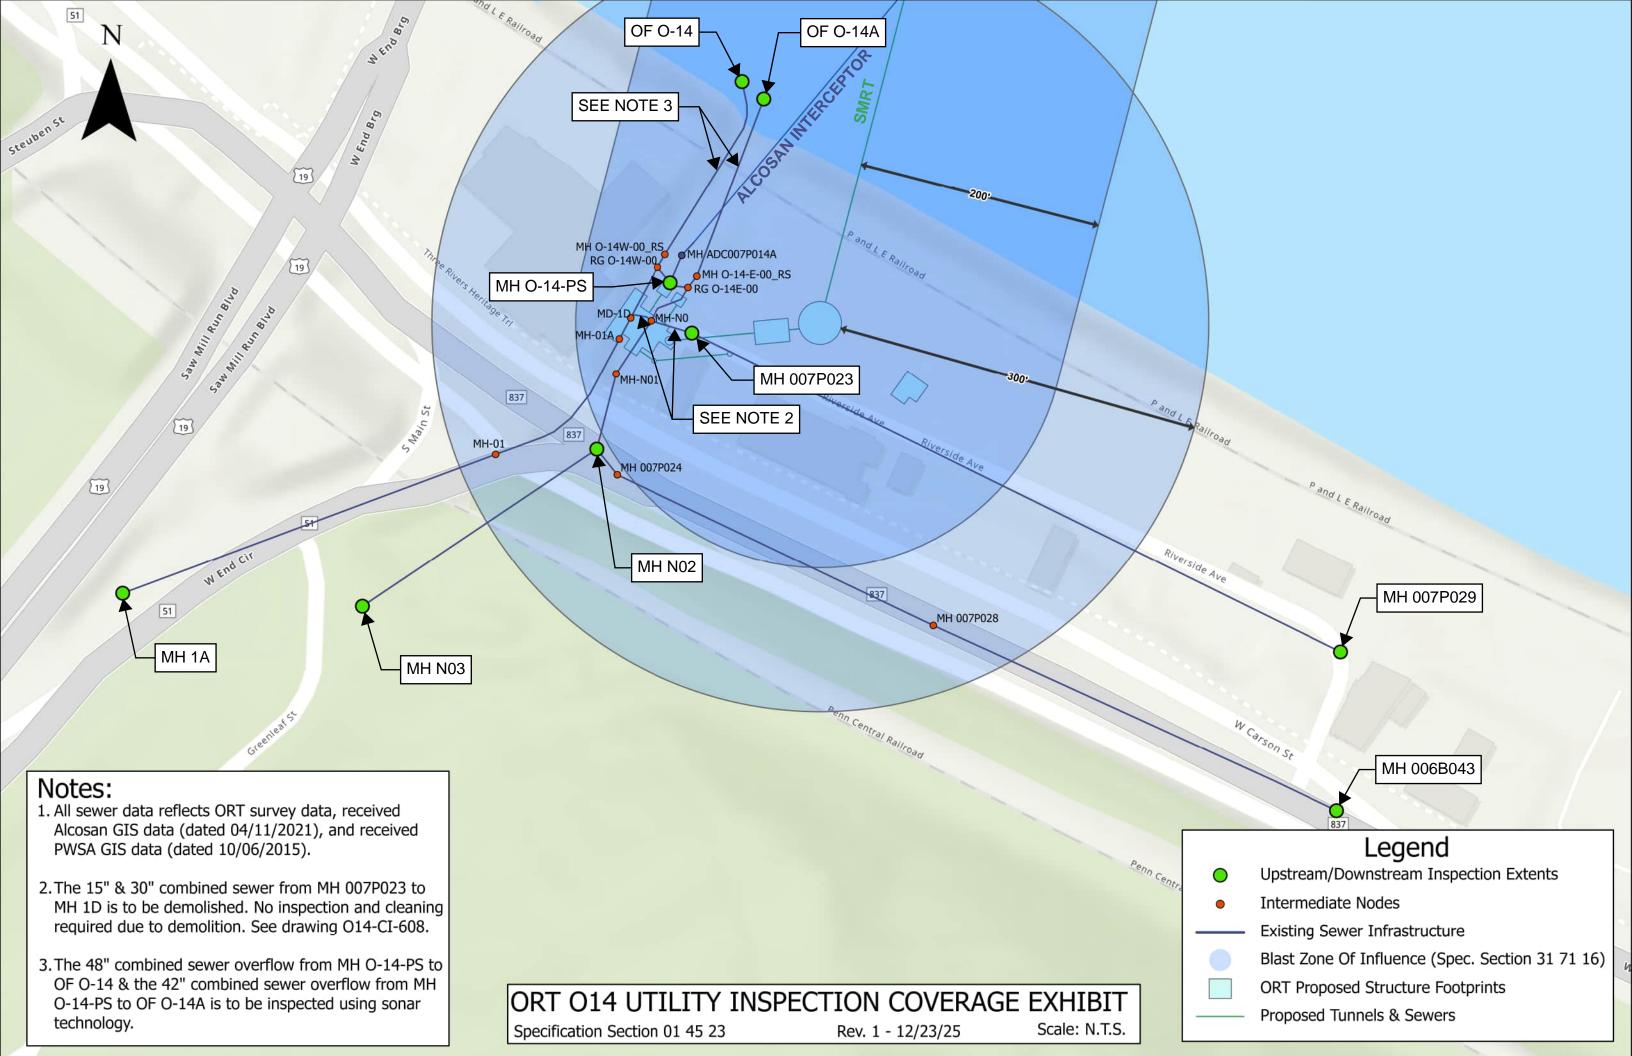


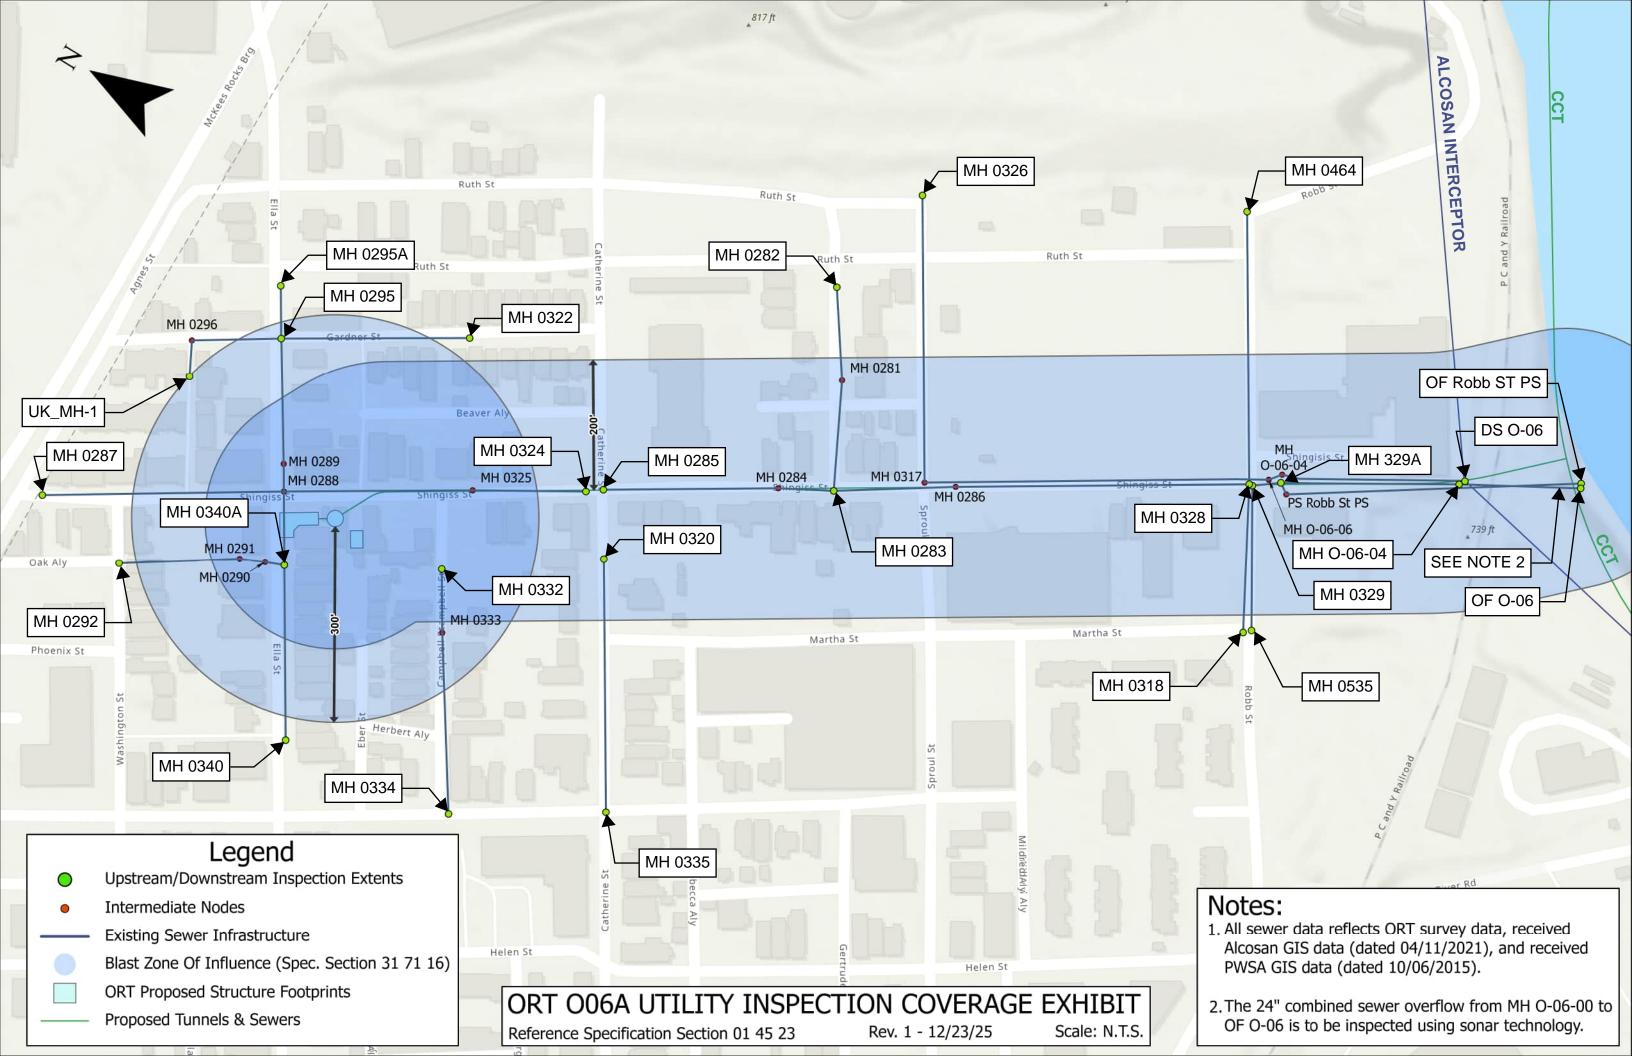

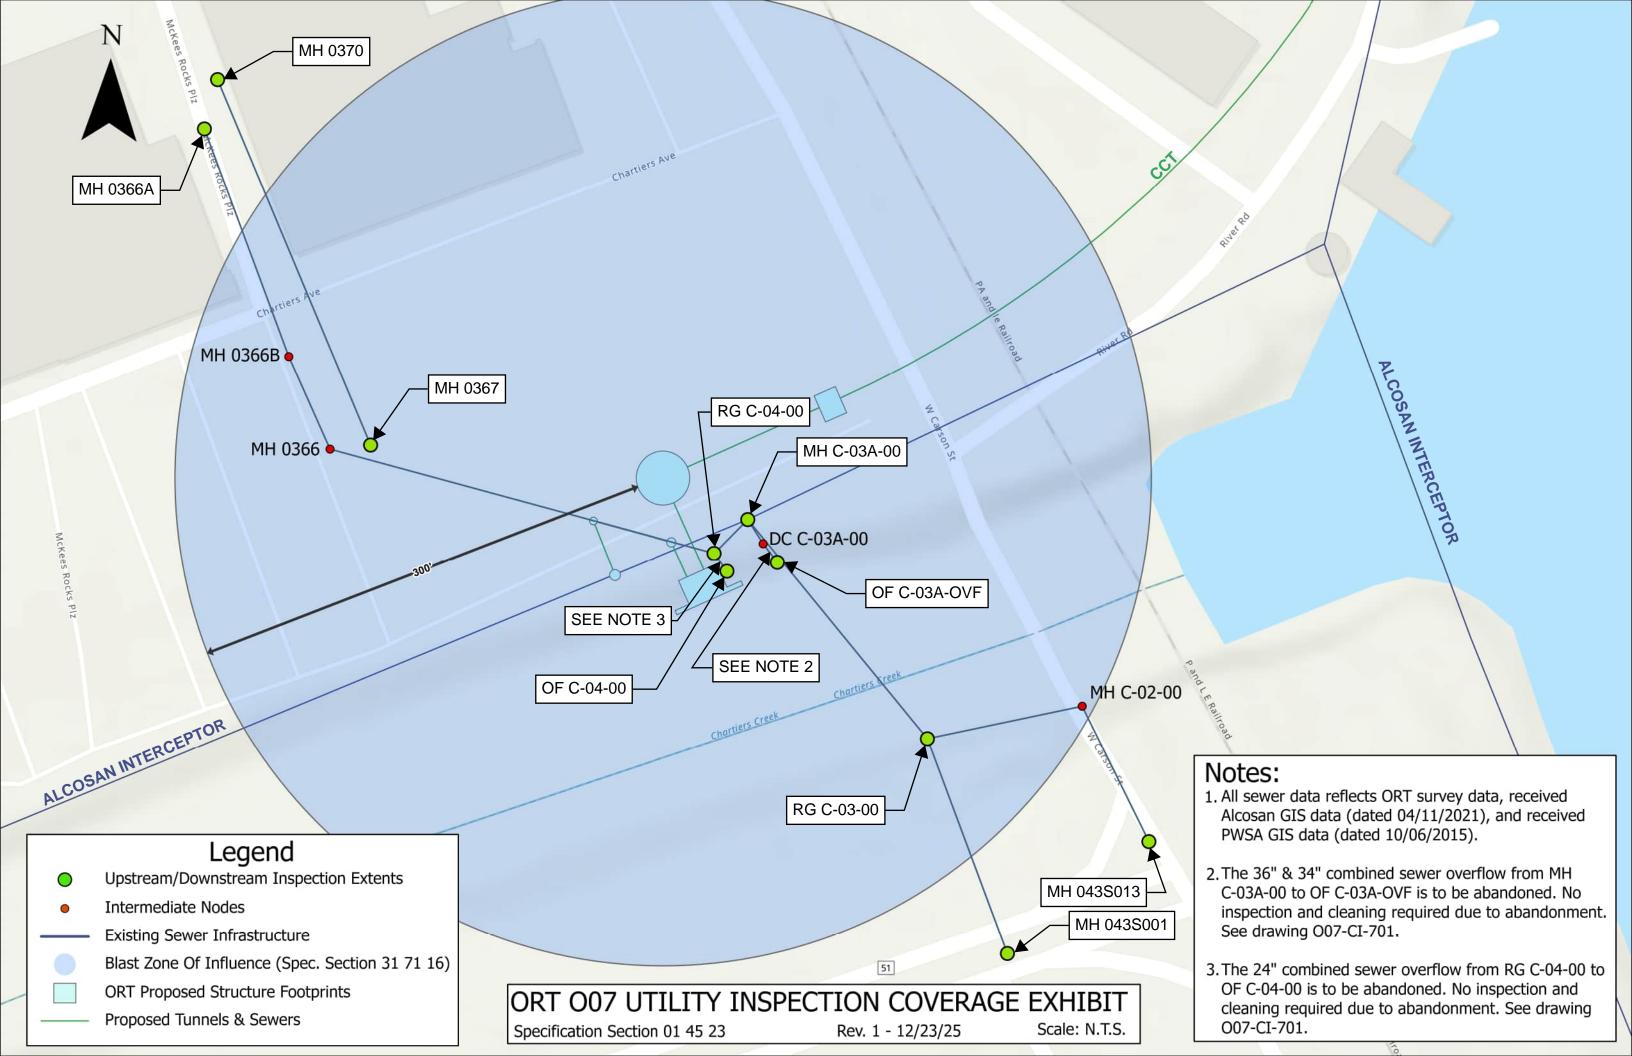

Attachment C – CONTRACT DRAWINGS

- Revised O14-CI-600 (Sheet 519 of 770)
- Revised O14-ST-605 (Sheet 545 of 770)
- Revised O14-ST-606 (Sheet 546 of 770)

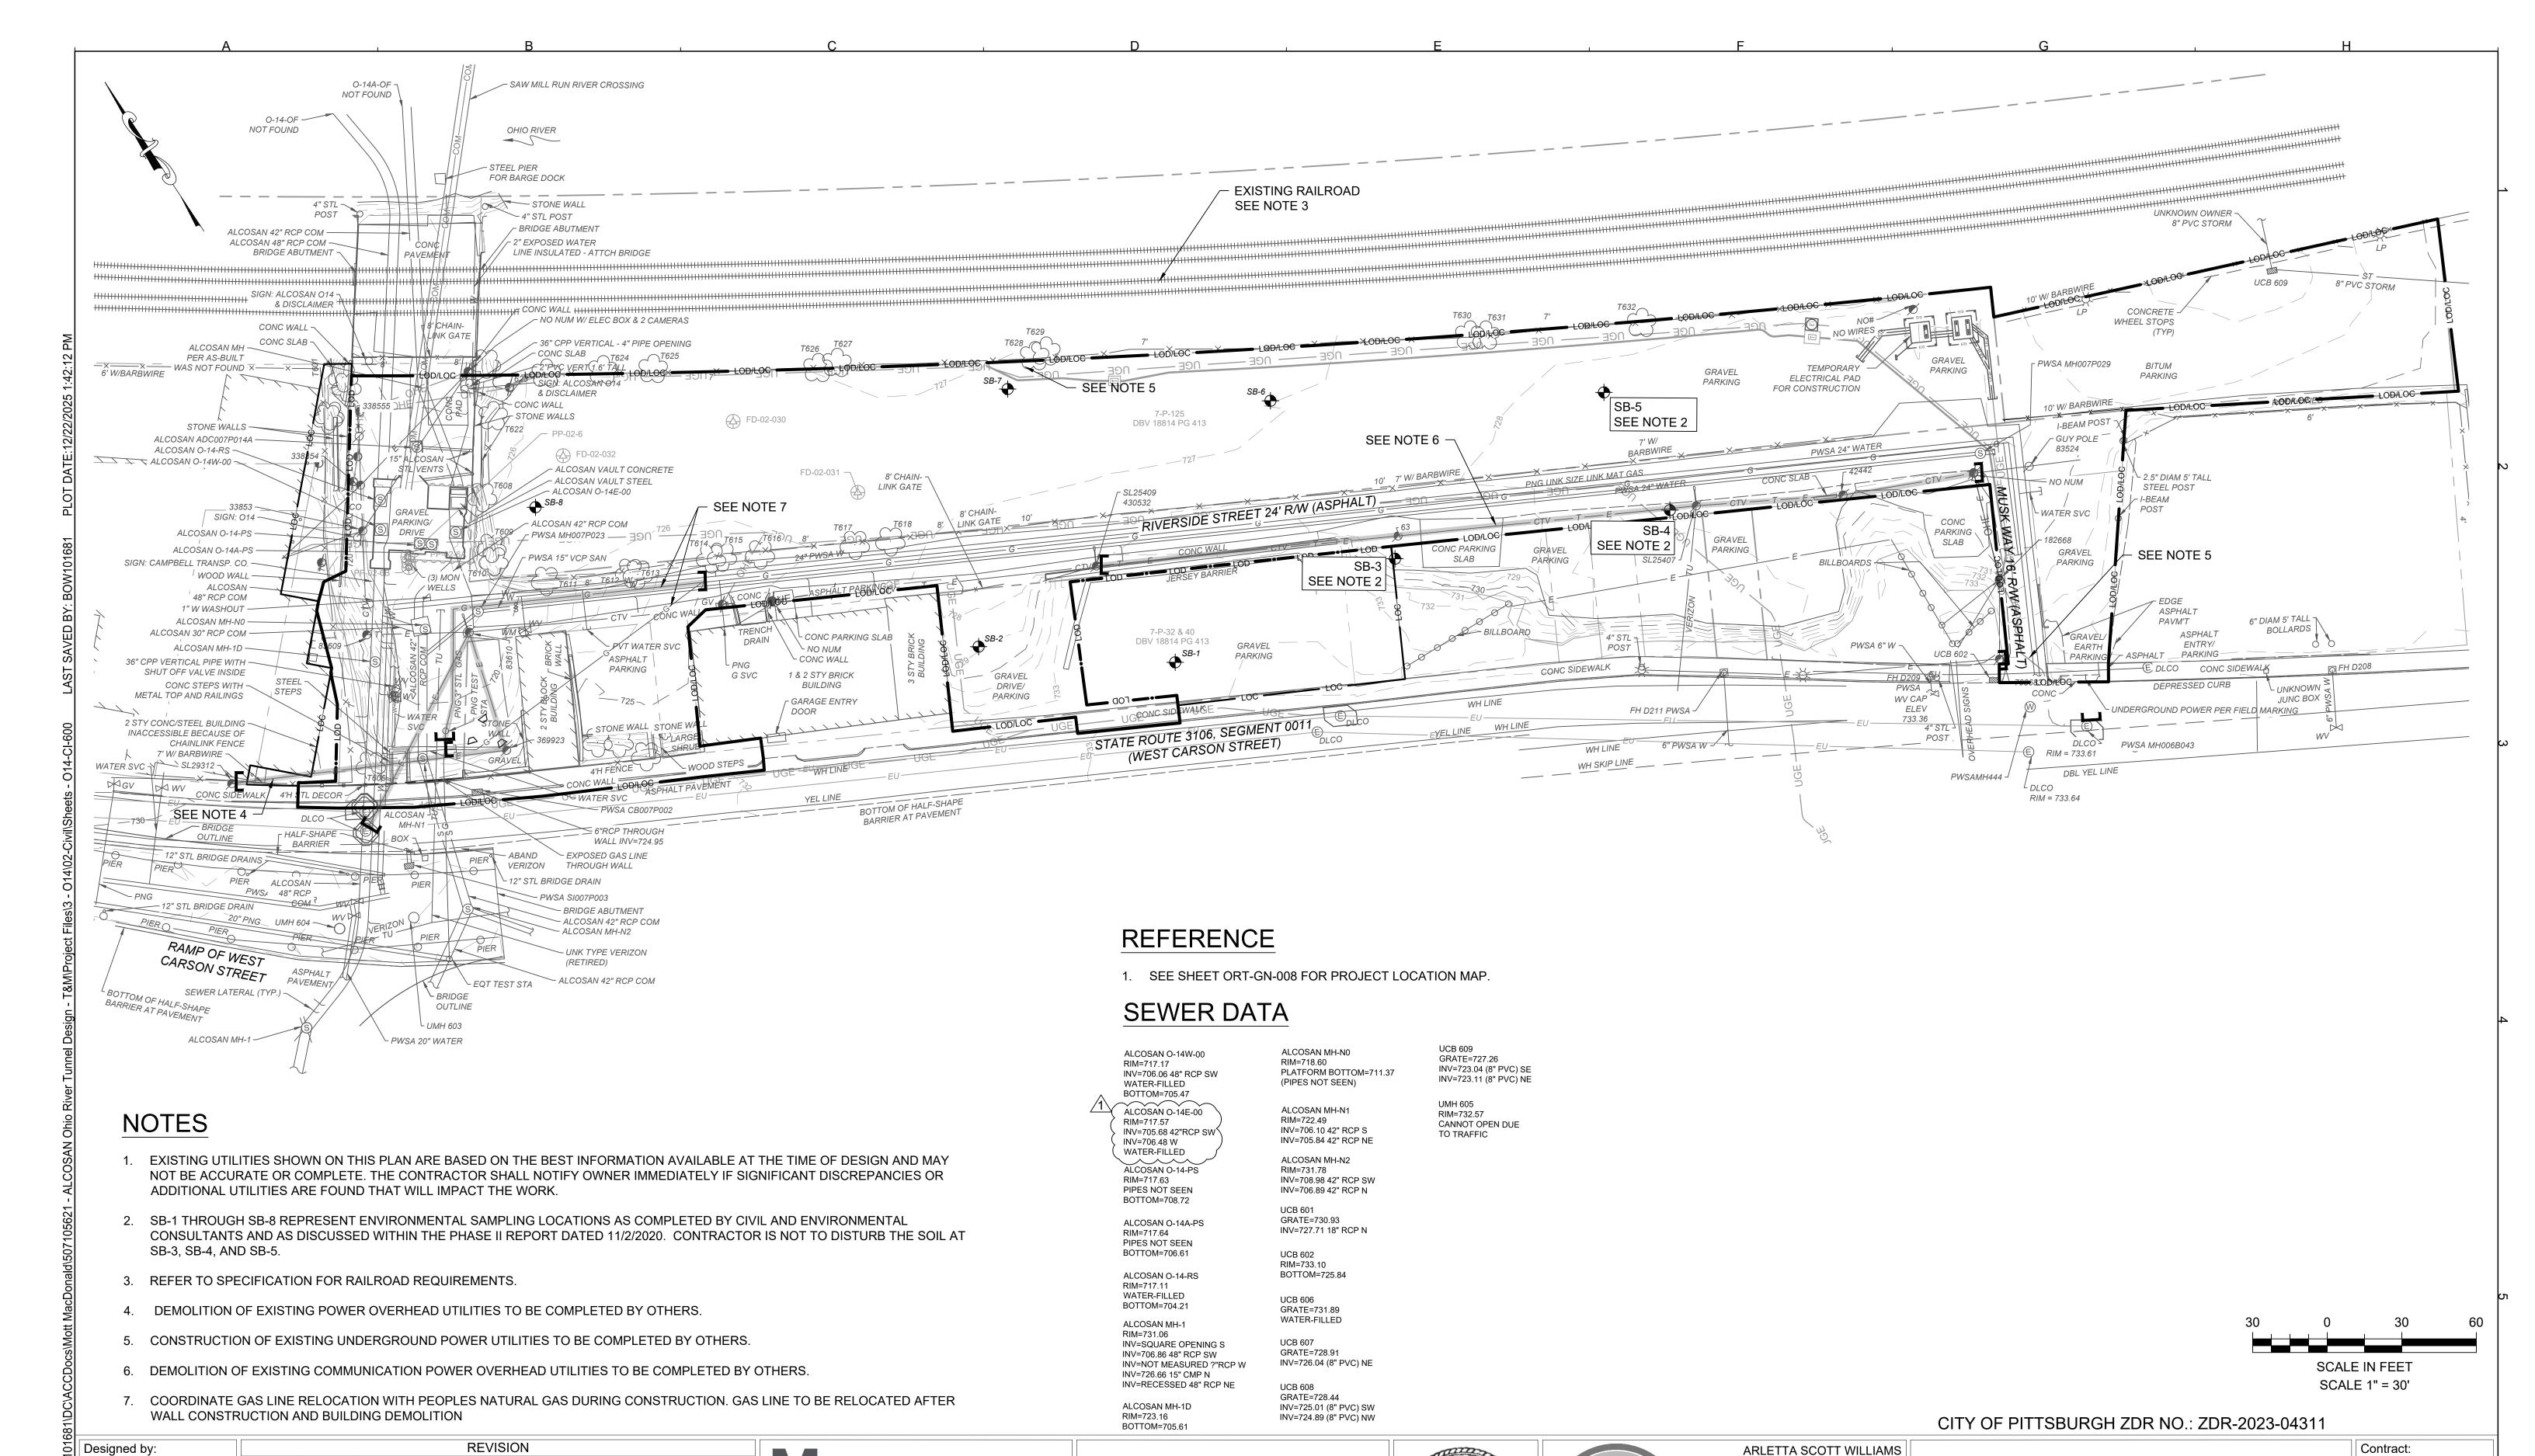

Dial 8-1-1 or 1-800-242-1776 not less

than 3 business days nor more than

10 business days prior to the start of

nnsylvania One Call System Serial Number

excavation.

PROFESSIONAL

allegheny county sanitary authority

ALLEGHENY COUNTY SANITARY AUTHORITY (ALCOSAN)

File:

Date:

Sheet:

O14-CI-600.dwg

07/30/2025

519 OF 770

OHIO RIVER TUNNEL (ORT)

O14-CI-600

EXISTING CONDITIONS PLAN

EXECUTIVE DIRECTOR, ALCOSAN

3300 PREBLE AVE. PITTSBURGH, PA 15233

www.alcosan.org

(412) 766 - 4810

APPV

ZC

MOTT

MACDONALD

Two Allegheny Center Nova Tower 2, Suite 1301 Pittsburgh, PA 15212

(412) 497 - 2900

DESCRIPTION

REVISION FOR ADDENDUM 11

REV No. DATE

1

12/23/25


JRL

MJN

DLM

Drawn by:

Checked by:

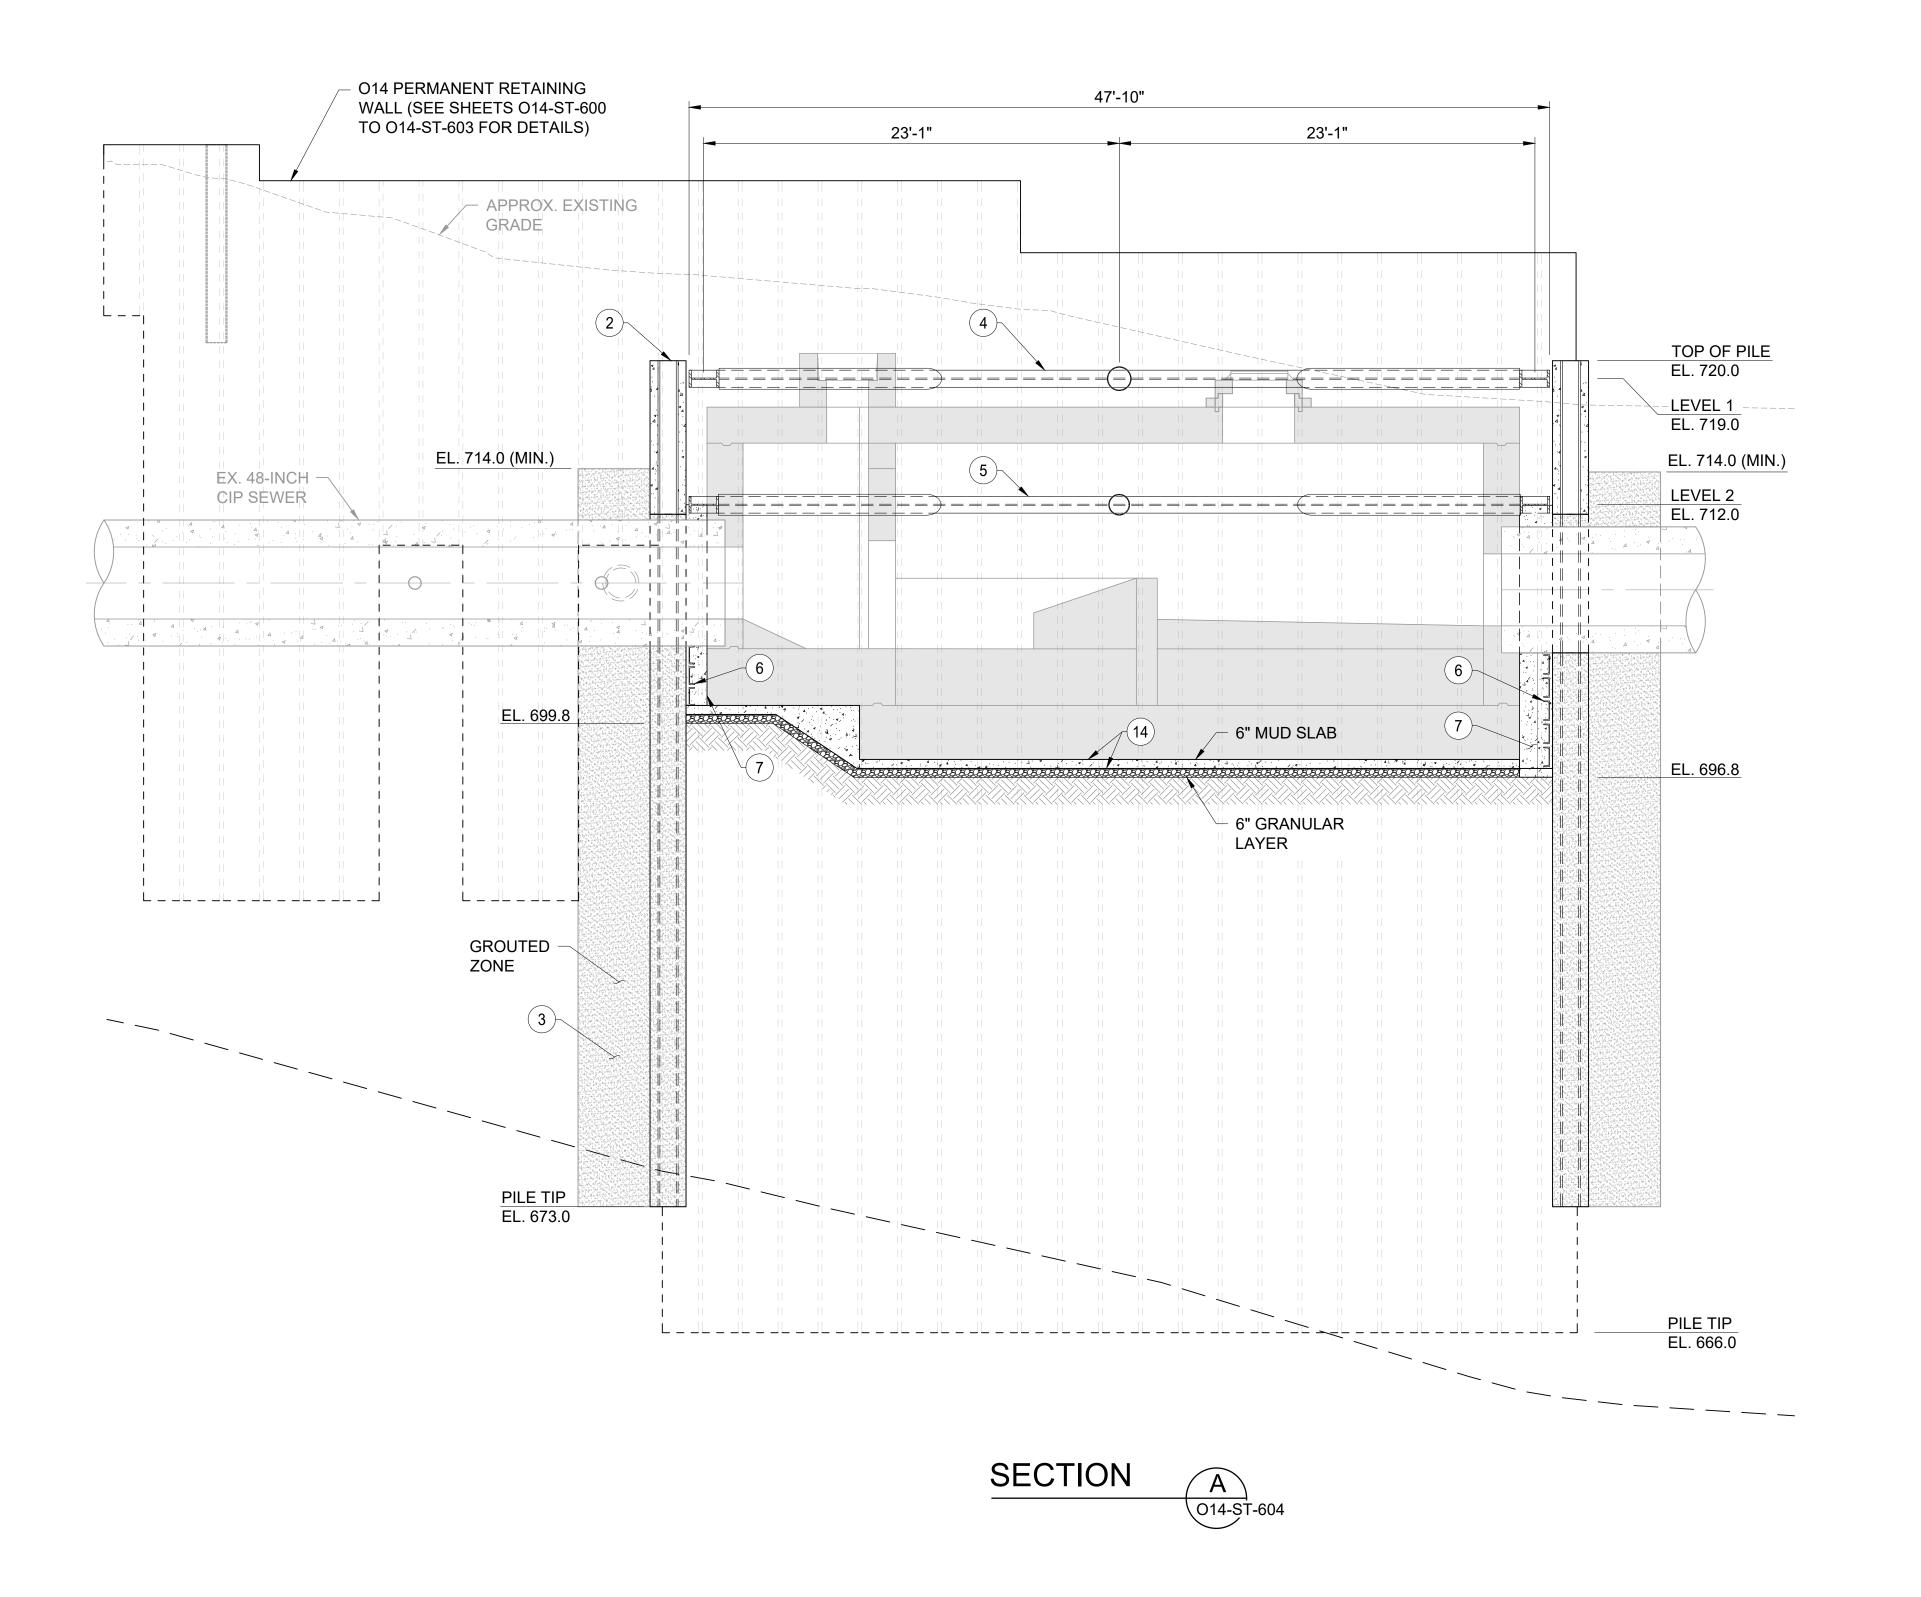

NOTES

(NOTES CONTINUED FROM SHEET 014-ST-604)

- 11. THE INSTALLATION OF THE PARTIAL DEPTH SOE PILES ABOVE, AND FULL DEPTH PILES IMMEDIATELY NEXT TO, THE EXISTING SEWERS MUST AVOID DAMAGES TO THE SEWER BY LEAVING THE APPROPRIATE CLEARANCES TO BE DETERMINED BY THE CONTRACTOR BASED ON ITS MEANS AND METHODS. THE PARTIAL DEPTH SOE PILES SHALL BE INSTALLED TO THE MAXIMUM EXTENT POSSIBLE ONLY AFTER THE FULL DEPTH PILES ARE COMPLETED.
- 12. THE UNSUPPORTED CLEARANCE ZONES, INCLUDING THE ENTIRE SPACE BELOW EACH SEWER INVERT SHALL BE GROUTED PRIOR TO EXCAVATION AND DURING EXCAVATION WHEN NECESSARY. IN ADDITION TO GROUTING, THE EXPOSED UNSUPPORTED CLEARANCE ZONES SHALL BE FULLY SUPPORTED BY INSTALLATION OF INTERNAL LAGGING DURING THE EXCAVATION PROCESS TO PREVENT SOIL MOVEMENT INTO THE EXCAVATION.
- 13. THE ADJOINING ZONES BETWEEN THE SOES AND THE EXISTING REGULATOR, INCLUDING THE UNDERSIDE OF THE REGULATOR SHALL BE GROUTED AS REQUIRED HEREIN TO PREVENT GROUNDWATER AND SOIL MOVEMENT INTO THE EXCAVATION.
- 14. THE EXTENTS OF GROUTED ZONES SHOWN HEREIN ARE MINIMUM REQUIREMENTS AND THE CONTRACTOR SHALL EXPAND THESE ZONES AND CONDUCT ADDITIONAL GROUTING AS DEEMED NECESSARY DURING ALL STAGES OF CONSTRUCTION TO ENSURE THAT NO VISIBLE DRIPPING OR MORE SEVERE GROUNDWATER INFILTRATION ENTERS THE EXCAVATION. THE GROUTING METHODOLOGY AND TYPE OF GROUT MIX SHALL BE DETERMINED BY THE CONTRACTOR BASED ON GEOTECHNICAL CONDITIONS AND SITE ACCESS AND SUBMITTED TO THE OWNER FOR REVIEW AND APPROVAL ACCORDING TO SPECIFICATION SECTION 31 55 00.
- 15. TO MAINTAIN EXISTING FLOW FOR THE 42-INCH RCP SEWER, THE CONTRACTOR SHALL DESIGN AND INSTALL A FLUMING PIPE OF THE MINIMUM SIZE SHOWN HEREIN. ITS SUPPORT ELEMENTS SHALL BE INDEPENDENT OF THE REGULATOR SOE SYSTEM. ANY ADDITIONAL LOADS IMPARTED ON THE EXISTING SEWER INVERT AND THE NEW 48-INCH RCP SEWER BY THE FLUMING PIPE AT EACH END SHALL BE KEPT TO A MINIMUM, AND THESE LOADS SHALL BE ANALYZED BY A PROFESSIONAL ENGINEER LICENSED IN THE COMMONWEALTH OF PENNSYLVANIA TO DEMONSTRATE THAT NO UNACCEPTABLE MOVEMENT WILL OCCUR IN THE SEWER INVERT AND THE EXPOSED VERTICAL SOIL WALL BELOW THE SEWER INVERT AS EXCAVATION REACHES THE BOTTOM ELEVATION. THE CONTRACTOR'S DESIGN SHALL BE SUBMITTED TO THE OWNER FOR REVIEW AND APPROVAL.
 - 15.1. THE FLUMING PIPE SHALL CONNECT THE 42-INCH SEWER AT THE LIMIT OF REMOVAL ON THE UPSTREAM SIDE AND THE NEWLY INSTALLED 48-INCH RCP SEWER CONNECTING TO THE EXISTING REGULATOR. THE INSTALLATION OF THE FLUMING PIPE SHALL BE FACILITATED BY IMPLEMENTING A BYPASS PUMPING SYSTEM FOR DRY WEATHER FLOW FROM THE EXISTING MANHOLE MH-N1 ON THE 42-INCH RCP SEWER TO THE NEWLY INSTALLED TRANSITION BOX.
- 15.2. DURING THE PERIOD OF INSTALLING THE FLUMING (PIPE), WHICH INVOLVES DISMANTLING OF THE EXISTING 42-INCH SEWER AND ASSOCIATED CONNECTING CHAMBER ELEMENTS AND INSTALLING THE WESTERN FLOW TRANSITION BOX INTO THE EXISTING O-14 REGULATOR AND THE NEW 48-INCH SEWER, DRY WEATHER FLOW SHALL BE HANDLED BY THE BYPASS PUMPING SYSTEM. HOWEVER, THE CONTRACTOR SHALL MAKE PROVISIONS TO ALLOW FOR WET WEATHER FLOWS OCCURRING DURING THIS PERIOD OF CONSTRUCTION TO PASS THROUGH THE CONSTRUCTION ZONE TO THE EXISTING REGULATOR.

(NOTES CONTINUE ON SHEET 014-ST-606)


BRACING SCHEDULE											
LEVEL	WALERS	CROSS-STRUTS	CORNER STRUTS								
LEVEL 1	W18x175	HSS16x0.625	HSS14x0.625								
LEVEL 2	W18x143	HSS14x0.625	HSS14x0.375								

LEGEND

OUTLINE OF PERMANENT STRUCTURES (SEE NOTE 3 ON SHEET O14-ST-604)


GROUTED ZONE

SUGGESTED CONSTRUCTION SEQUENCE STEP (SEE SHEET 014-ST-607 TO 014-ST-609)

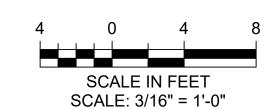


Designed by:			REVISION								
		REV No.	DATE	DESCRIPTION	APPV						
	JP/SE	1	12/23/25	REVISION FOR ADDENDUM 11	ZC						
Drawn by:											
	BJD										
Checked by:											
	ZC										

MOTT **MACDONALD**

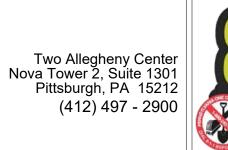



Dial 8-1-1 or 1-800-242-1776 not less than 3 business days nor more than 10 business days prior to the start of nnsylvania One Call System Serial Numbe

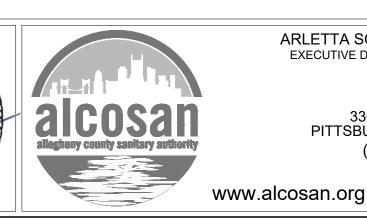


ARLETTA SCOTT WILLIAMS
EXECUTIVE DIRECTOR, ALCOSAN

3300 PREBLE AVE. PITTSBURGH, PA 15233 (412) 766 - 4810

Contract: ALLEGHENY COUNTY SANITARY AUTHORITY (ALCOSAN) OHIO RIVER TUNNEL (ORT)

O14-ST-605.dwg O14-ST-605 SMRT-014-RG SUPPORT OF EXCAVATION 07/30/2025 Sheet: SHEET 2 OF 8 545 OF 770

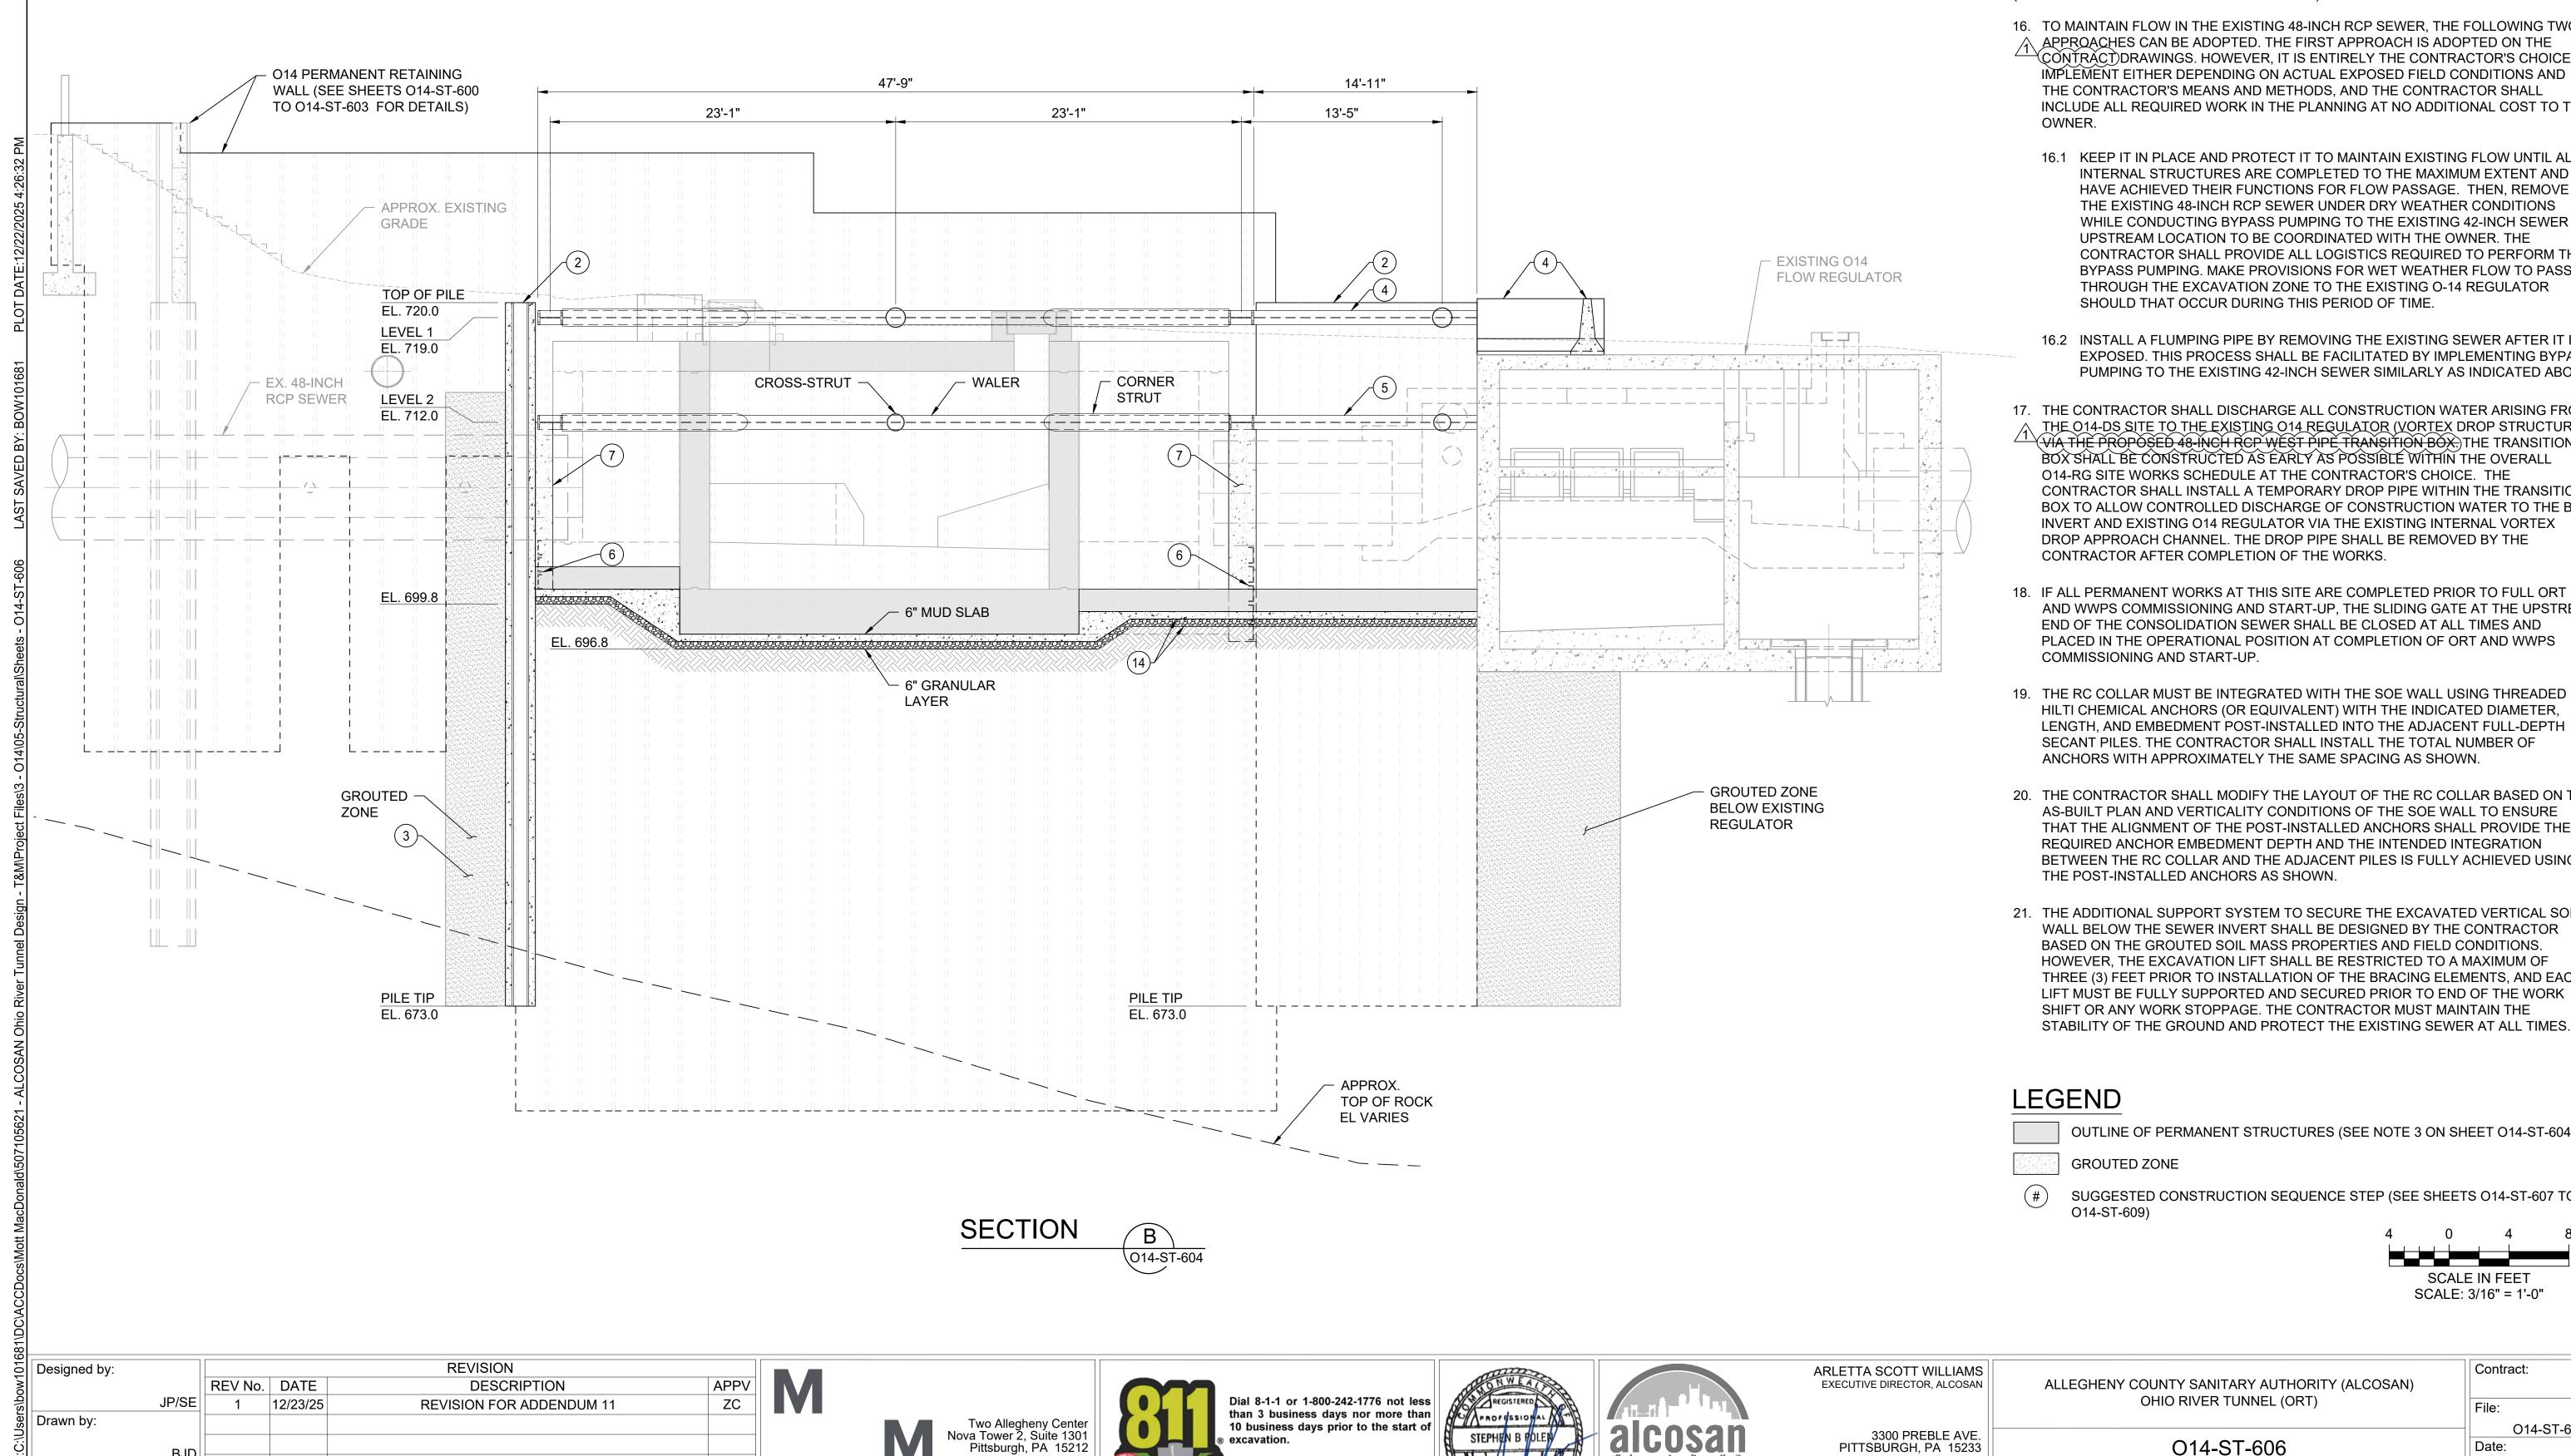

excavation.

(412) 497 - 2900

MOTT

MACDONALD

BJD

ZC

Checked by:

NOTES


(NOTES CONTINUED FROM SHEET 014-ST-605)

- 16. TO MAINTAIN FLOW IN THE EXISTING 48-INCH RCP SEWER, THE FOLLOWING TWO APPROACHES CAN BE ADOPTED. THE FIRST APPROACH IS ADOPTED ON THE CONTRACTOR'S CHOICE TO IMPLEMENT EITHER DEPENDING ON ACTUAL EXPOSED FIELD CONDITIONS AND THE CONTRACTOR'S MEANS AND METHODS, AND THE CONTRACTOR SHALL INCLUDE ALL REQUIRED WORK IN THE PLANNING AT NO ADDITIONAL COST TO THE
 - 16.1 KEEP IT IN PLACE AND PROTECT IT TO MAINTAIN EXISTING FLOW UNTIL ALL INTERNAL STRUCTURES ARE COMPLETED TO THE MAXIMUM EXTENT AND HAVE ACHIEVED THEIR FUNCTIONS FOR FLOW PASSAGE. THEN, REMOVE THE EXISTING 48-INCH RCP SEWER UNDER DRY WEATHER CONDITIONS WHILE CONDUCTING BYPASS PUMPING TO THE EXISTING 42-INCH SEWER UPSTREAM LOCATION TO BE COORDINATED WITH THE OWNER. THE CONTRACTOR SHALL PROVIDE ALL LOGISTICS REQUIRED TO PERFORM THE BYPASS PUMPING. MAKE PROVISIONS FOR WET WEATHER FLOW TO PASS THROUGH THE EXCAVATION ZONE TO THE EXISTING O-14 REGULATOR
 - 16.2 INSTALL A FLUMPING PIPE BY REMOVING THE EXISTING SEWER AFTER IT IS EXPOSED. THIS PROCESS SHALL BE FACILITATED BY IMPLEMENTING BYPASS PUMPING TO THE EXISTING 42-INCH SEWER SIMILARLY AS INDICATED ABOVE.
- 17. THE CONTRACTOR SHALL DISCHARGE ALL CONSTRUCTION WATER ARISING FROM THE 014-DS SITE TO THE EXISTING 014 REGULATOR (VORTEX DROP STRUCTURE). VIA THE PROPOSED 48-INCH RCP WEST PIPE TRANSITION BOX THE TRANSITION BOX SHALL BE CONSTRUCTED AS EARLY AS POSSIBLE WITHIN THE OVERALL O14-RG SITE WORKS SCHEDULE AT THE CONTRACTOR'S CHOICE. THE CONTRACTOR SHALL INSTALL A TEMPORARY DROP PIPE WITHIN THE TRANSITION BOX TO ALLOW CONTROLLED DISCHARGE OF CONSTRUCTION WATER TO THE BOX INVERT AND EXISTING 014 REGULATOR VIA THE EXISTING INTERNAL VORTEX DROP APPROACH CHANNEL. THE DROP PIPE SHALL BE REMOVED BY THE
- 18. IF ALL PERMANENT WORKS AT THIS SITE ARE COMPLETED PRIOR TO FULL ORT AND WWPS COMMISSIONING AND START-UP, THE SLIDING GATE AT THE UPSTREAM END OF THE CONSOLIDATION SEWER SHALL BE CLOSED AT ALL TIMES AND PLACED IN THE OPERATIONAL POSITION AT COMPLETION OF ORT AND WWPS
- HILTI CHEMICAL ANCHORS (OR EQUIVALENT) WITH THE INDICATED DIAMETER, LENGTH, AND EMBEDMENT POST-INSTALLED INTO THE ADJACENT FULL-DEPTH SECANT PILES. THE CONTRACTOR SHALL INSTALL THE TOTAL NUMBER OF ANCHORS WITH APPROXIMATELY THE SAME SPACING AS SHOWN.
- 20. THE CONTRACTOR SHALL MODIFY THE LAYOUT OF THE RC COLLAR BASED ON THE AS-BUILT PLAN AND VERTICALITY CONDITIONS OF THE SOE WALL TO ENSURE THAT THE ALIGNMENT OF THE POST-INSTALLED ANCHORS SHALL PROVIDE THE REQUIRED ANCHOR EMBEDMENT DEPTH AND THE INTENDED INTEGRATION BETWEEN THE RC COLLAR AND THE ADJACENT PILES IS FULLY ACHIEVED USING
- 21. THE ADDITIONAL SUPPORT SYSTEM TO SECURE THE EXCAVATED VERTICAL SOIL WALL BELOW THE SEWER INVERT SHALL BE DESIGNED BY THE CONTRACTOR BASED ON THE GROUTED SOIL MASS PROPERTIES AND FIELD CONDITIONS. HOWEVER, THE EXCAVATION LIFT SHALL BE RESTRICTED TO A MAXIMUM OF THREE (3) FEET PRIOR TO INSTALLATION OF THE BRACING ELEMENTS, AND EACH LIFT MUST BE FULLY SUPPORTED AND SECURED PRIOR TO END OF THE WORK SHIFT OR ANY WORK STOPPAGE. THE CONTRACTOR MUST MAINTAIN THE STABILITY OF THE GROUND AND PROTECT THE EXISTING SEWER AT ALL TIMES.

OUTLINE OF PERMANENT STRUCTURES (SEE NOTE 3 ON SHEET 014-ST-604)

SUGGESTED CONSTRUCTION SEQUENCE STEP (SEE SHEETS 014-ST-607 TO

SHEET 3 OF 8

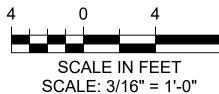

Contract:

546 OF 770

3300 PREBLE AVE. PITTSBURGH, PA 15233 (412) 766 - 4810


www.alcosan.org


illegheny county sanitary authority

File: O14-ST-606.dwg O14-ST-606 SMRT-014-RG SUPPORT OF EXCAVATION 07/30/2025 Sheet:

Attachment D – CONTRACT DRAWINGS

- Revised AS1-CI-501 (Sheet 500 of 770)
- Revised AS1-CI-507 (Sheet 506 of 770)
- Revised O41-CI-202 (Sheet 301 of 770)
- Revised O41-CI-203 (Sheet 302 of 770)
- Revised O41-CI-205 (Sheet 304 of 770)

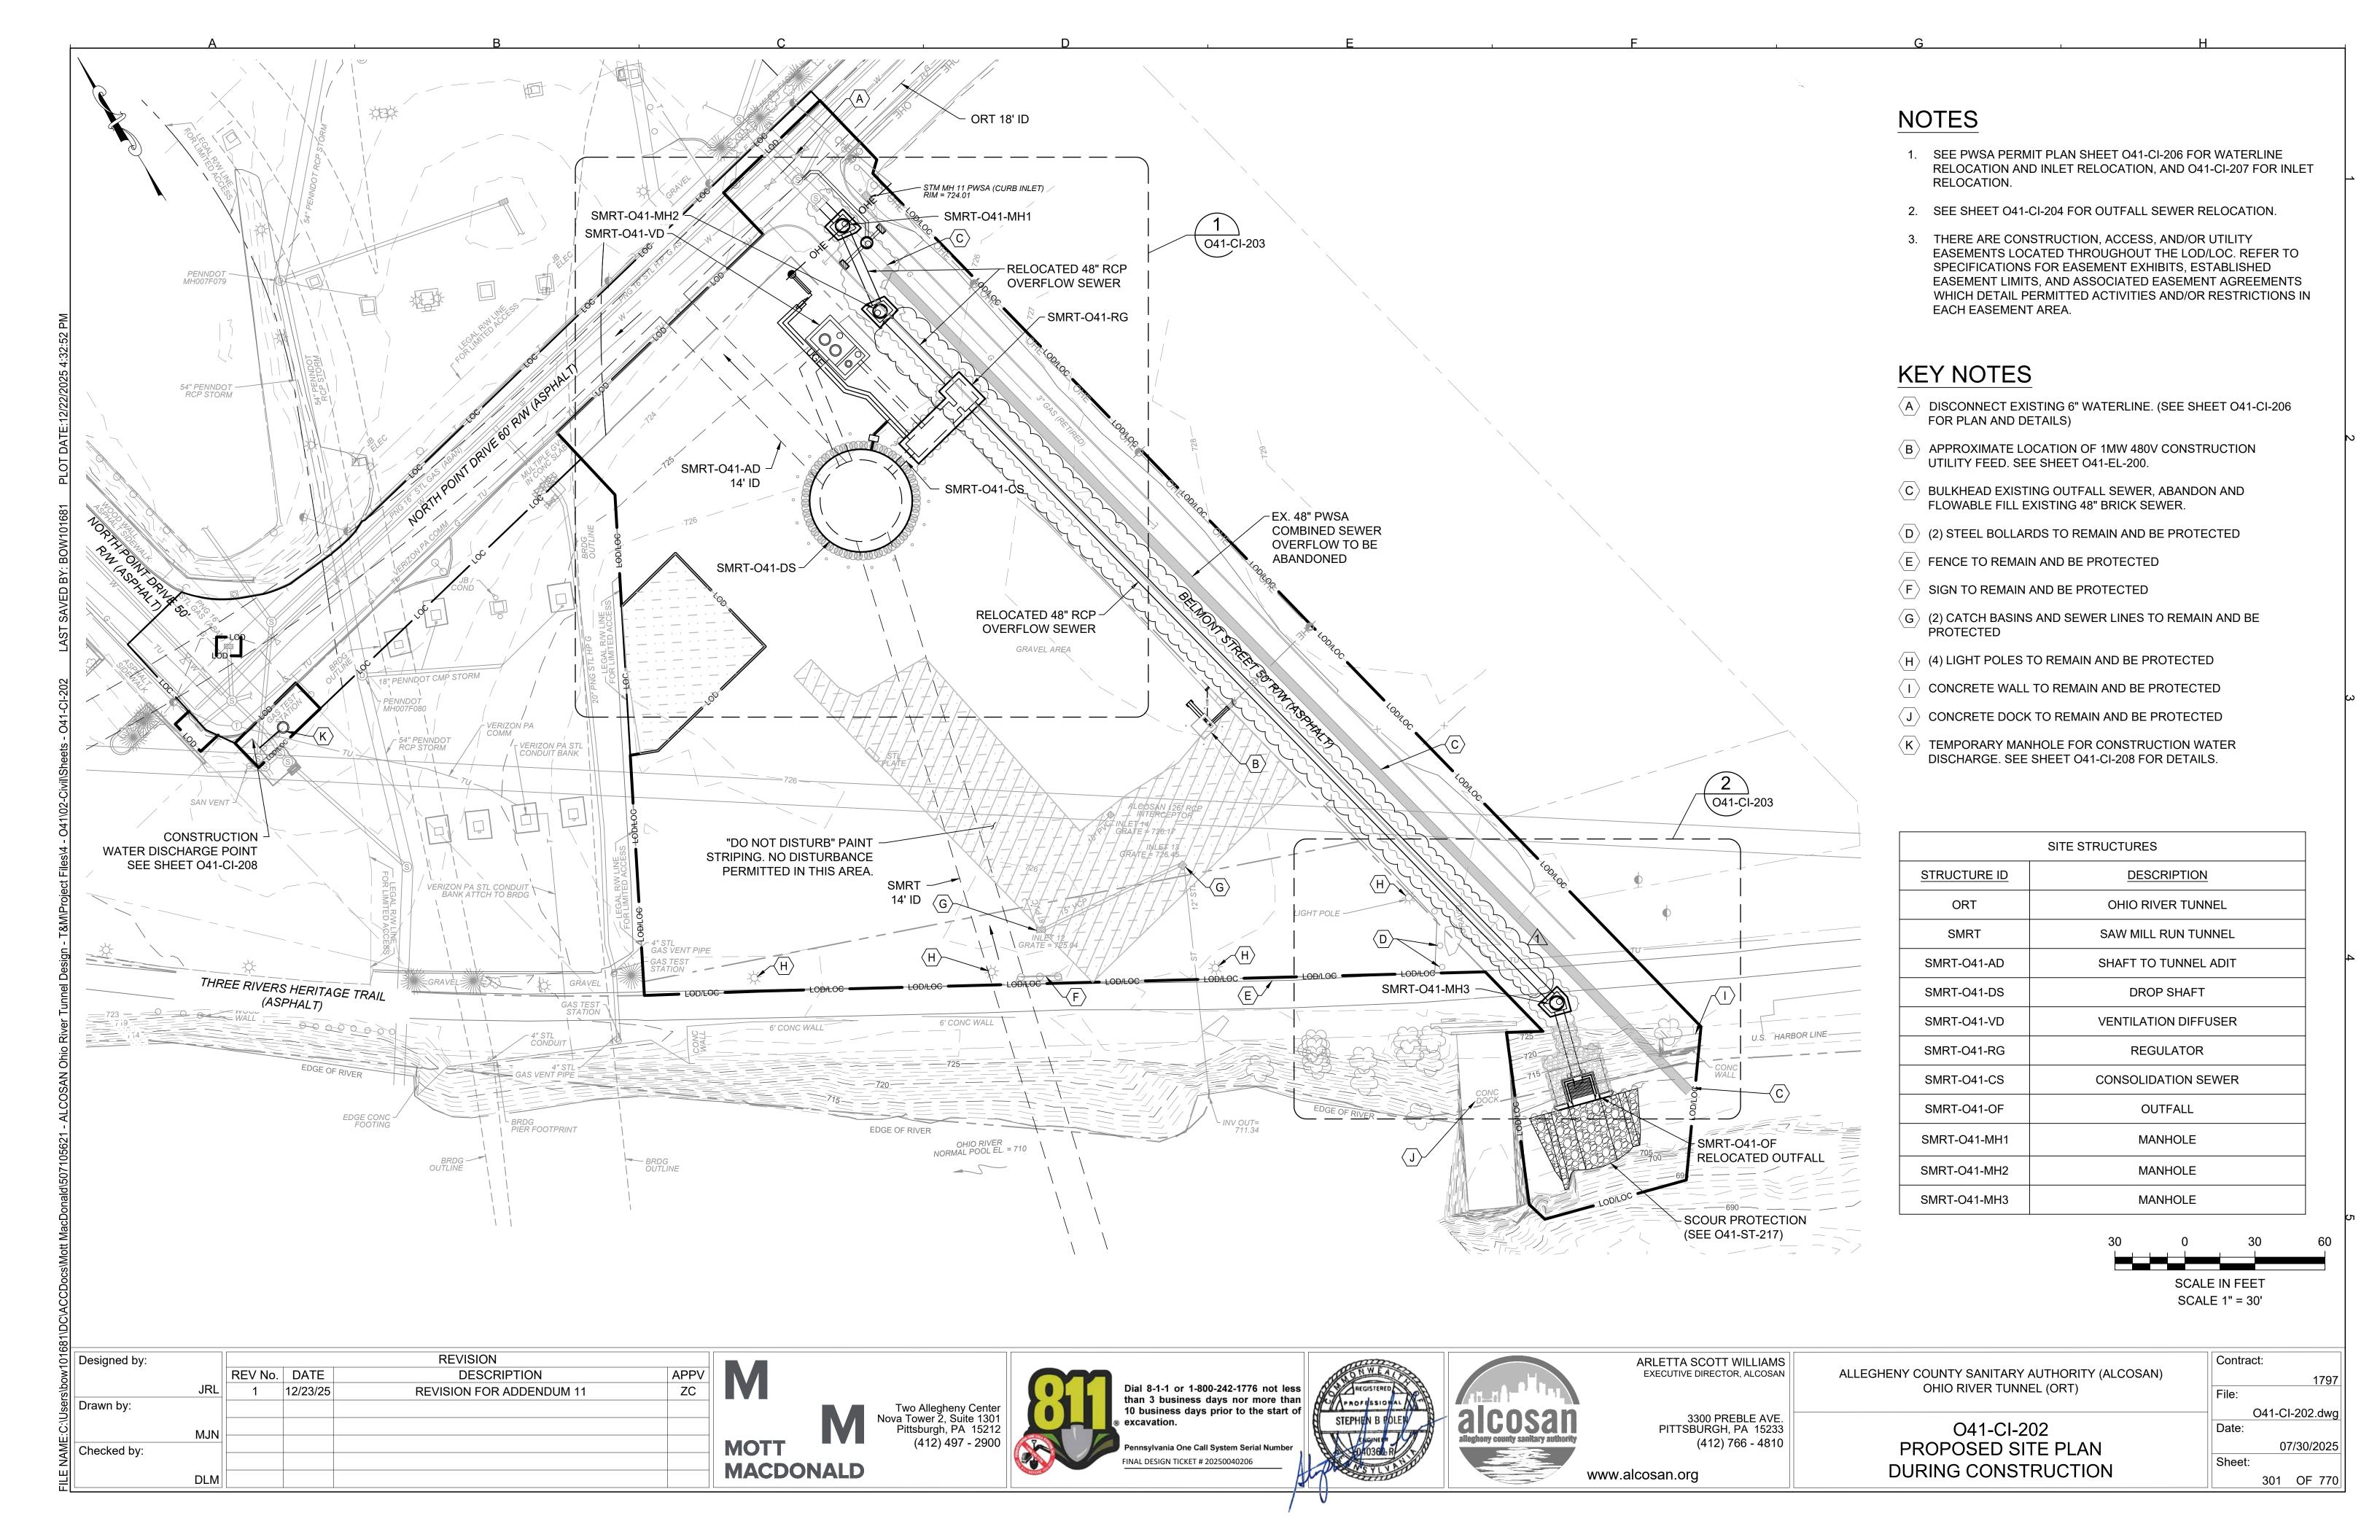

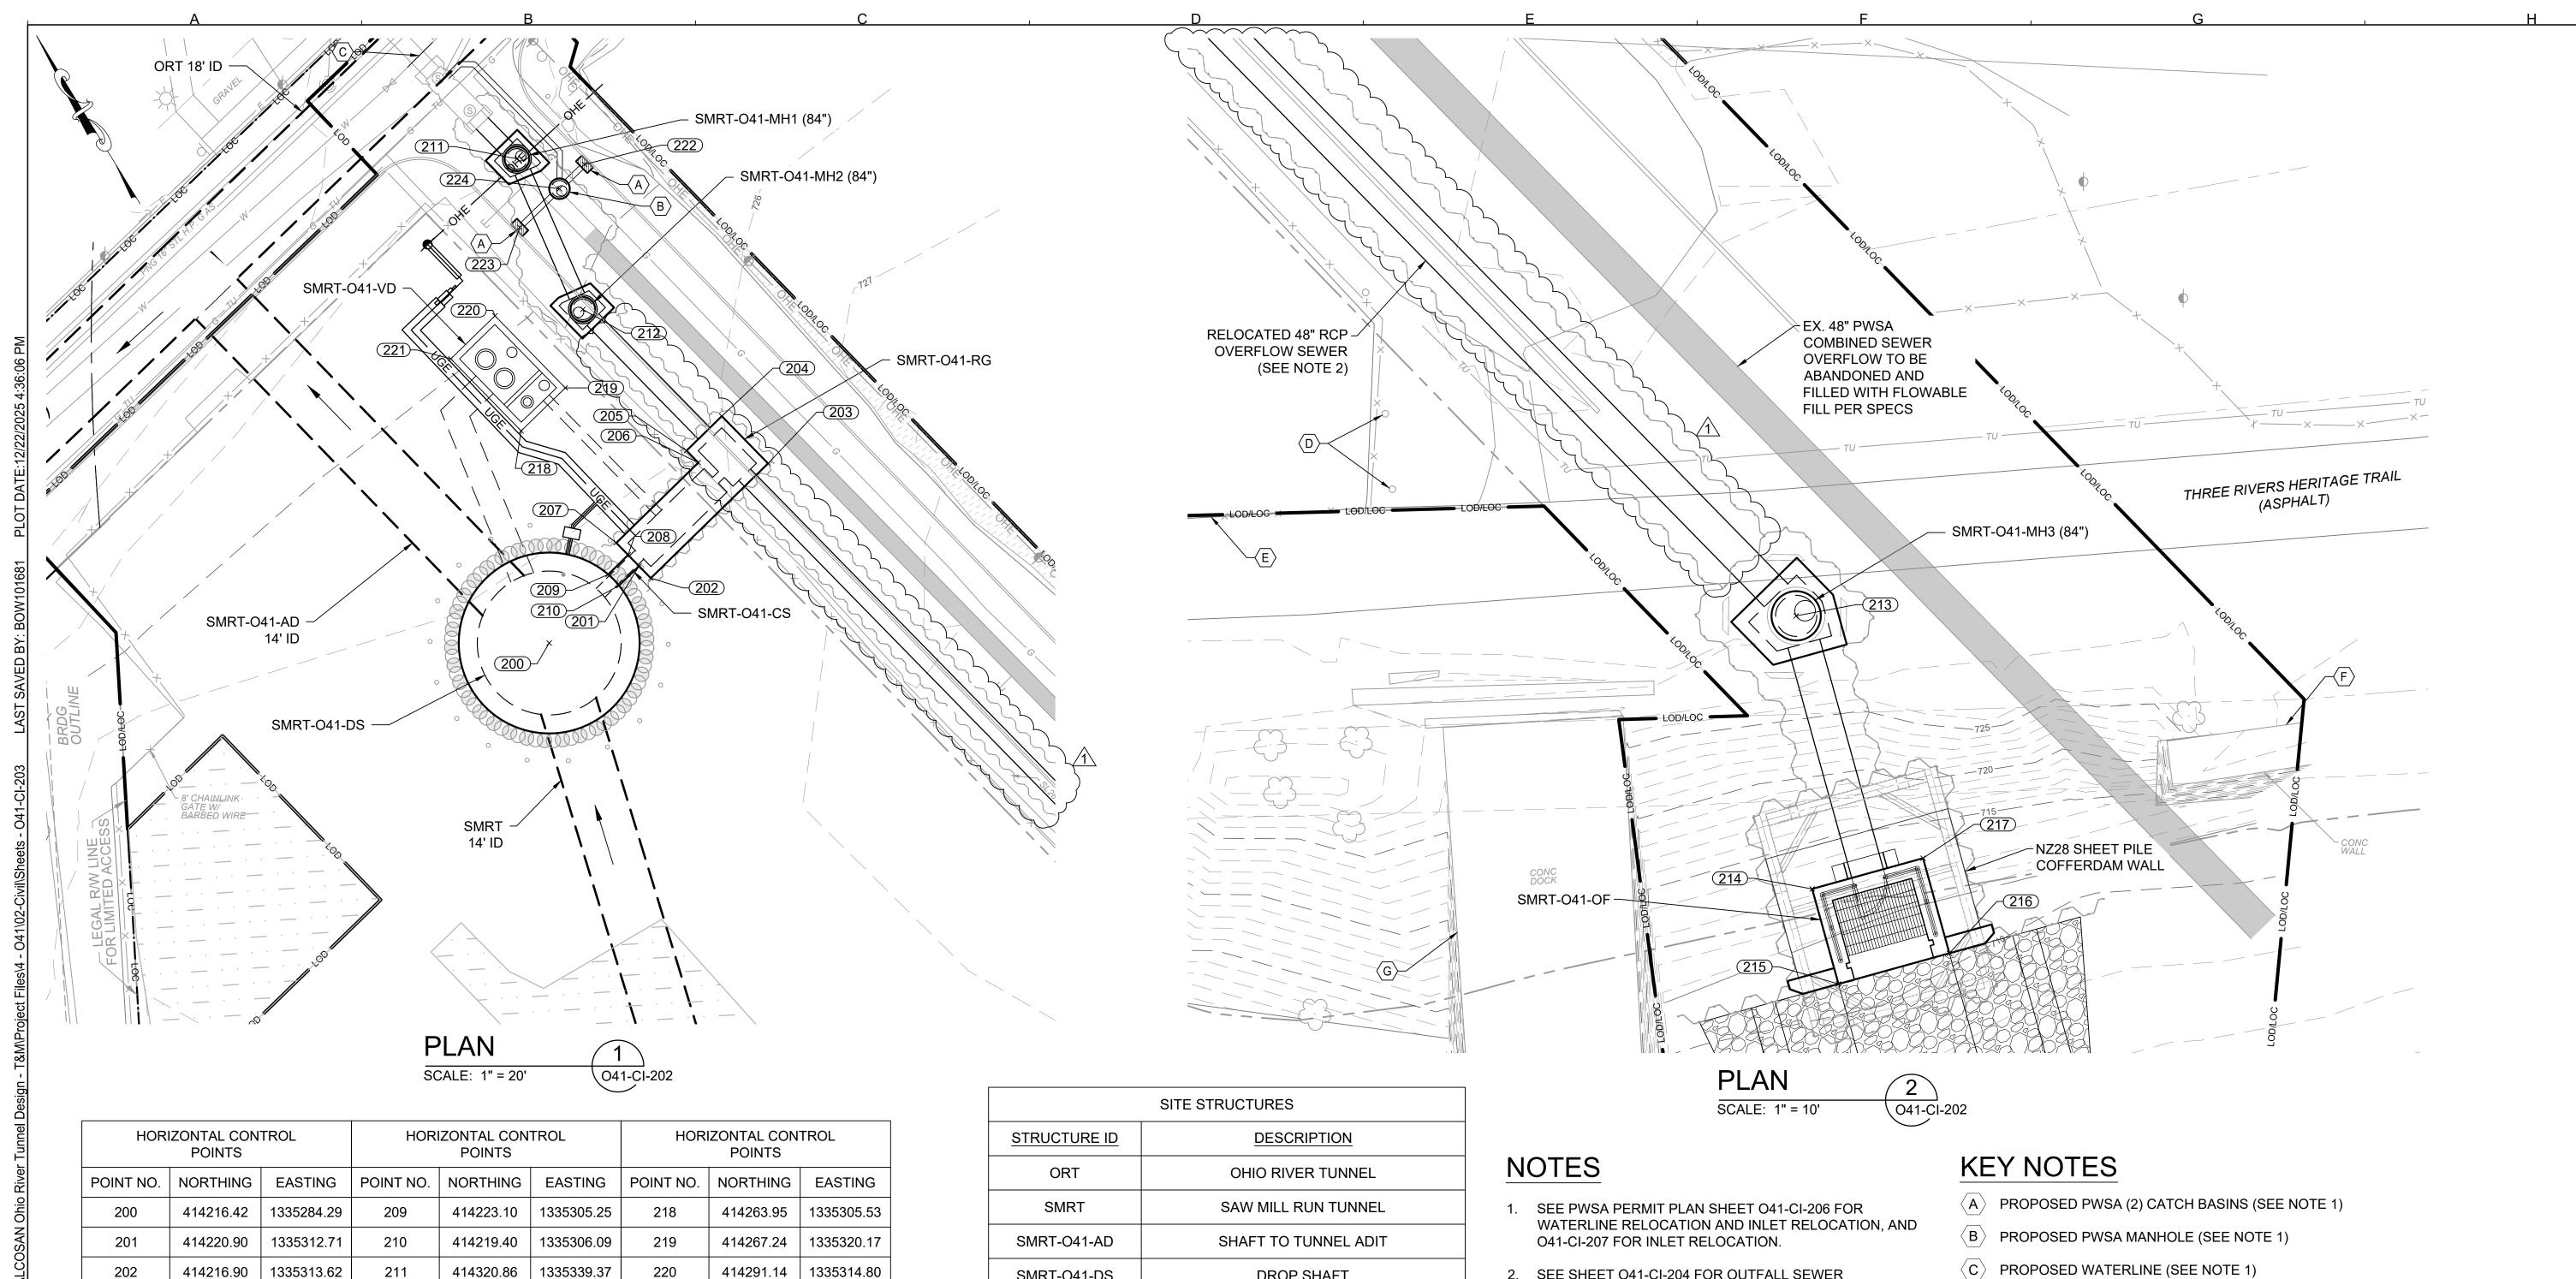


HORIZONTAL CONTROL POINTS			HORIZONTAL CONTROL POINTS			HORIZONTAL CONTROL POINTS			
POINT NO.	NORTHING	EASTING	POINT NO.	NORTHING	EASTING	POINT NO.	NORTHING	EASTING	
200	414216.42	1335284.29	209	414223.10	1335305.25	218	414263.95	1335305.53	
201	414220.90	1335312.71	210	414219.40	1335306.09	219	414267.24	1335320.17	
202	414216.90	1335313.62	211	414320.86	1335339.37	220	414291.14	1335314.80	
203	414225.70	1335352.55	212	414281.25	1335333.83	221	414287.86	1335300.16	
204	414241.40	1335349.00	213	413876.72	1335425.33	222	414311.09	1335352.69	
205	414238.75	1335337.30	214	413847.41	1335409.56	223	414306.32	1335331.21	
206	414234.77	1335338.20	215	413835.88	1335406.23	224	414309.24	1335344.39	
207	414228.65	1335310.97	216	413831.99	1335419.68				
208	414224.60	1335311.88	217	413843.52	1335423.01				

	SITE STRUCTURES
STRUCTURE ID	DESCRIPTION
ORT	OHIO RIVER TUNNEL
SMRT	SAW MILL RUN TUNNEL
SMRT-O41-AD	SHAFT TO TUNNEL ADIT
SMRT-O41-DS	DROP SHAFT
SMRT-O41-VD	VENTILATION DIFFUSER
SMRT-O41-RG	REGULATOR
SMRT-O41-CS	CONSOLIDATION SEWER
SMRT-O41-OF	OUTFALL
SMRT-O41-MH1	MANHOLE
SMRT-O41-MH2	MANHOLE
SMRT-O41-MH3	MANHOLE

- 2. SEE SHEET O41-CI-204 FOR OUTFALL SEWER RELOCATION.
- 3. THERE ARE CONSTRUCTION, ACCESS, AND/OR UTILITY EASEMENTS LOCATED THROUGHOUT THE LOD/LOC. REFER TO APPENDIX E SUPPLEMENTAL INFORMATION FOR EASEMENT EXHIBITS, ESTABLISHED EASEMENT LIMITS, AND ASSOCIATED EASEMENT AGREEMENTS WHICH DETAIL PERMITTED ACTIVITIES AND/OR RESTRICTIONS IN EACH EASEMENT AREA.
 - 7-L-31: TEMPORARY CONSTRUCTION AND PERMANENT ACCESS EASEMENTS.
 - 7-M-110-9: TEMPORARY CONSTRUCTION EASEMENT.

- (2) STEEL BOLLARDS TO REMAIN AND BE PROTECTED
- E FENCE TO REMAIN AND BE PROTECTED
- F CONCRETE WALL TO REMAIN AND BE PROTECTED
- G CONCRETE DOCK TO REMAIN AND BE PROTECTED

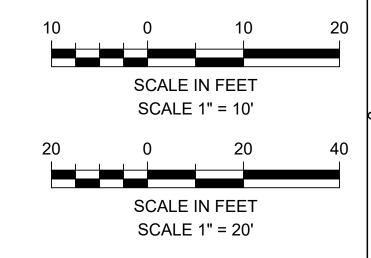

Designed by:		REVISION									
		REV No.	DATE	DESCRIPTION	APPV						
	JRL	1	12/23/25	REVISION FOR ADDENDUM 11	ZC						
Drawn by:											
	MJN										
Checked by:	IVIJIN										
Officered by:											
	DLM										


Two Allegheny Center Nova Tower 2, Suite 1301 Pittsburgh, PA 15212 MOTT **MACDONALD**



Dial 8-1-1 or 1-800-242-1776 not less than 3 business days nor more than 10 business days prior to the start of

> nnsylvania One Call System Serial Number FINAL DESIGN TICKET # 20250040206



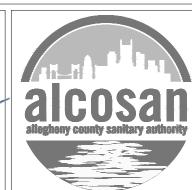

ARLETTA SCOTT WILLIAMS EXECUTIVE DIRECTOR, ALCOSAN

www.alcosan.org


3300 PREBLE AVE. PITTSBURGH, PA 15233 (412) 766 - 4810


OHIO RIVER TUNNEL (ORT) O41-CI-203 ENLARGED SITE PLAN

ALLEGHENY COUNTY SANITARY AUTHORITY (ALCOSAN)

DURING CONSTRUCTION


Contract: O41-CI-203.dwg 07/30/2025 Sheet: 302 OF 770

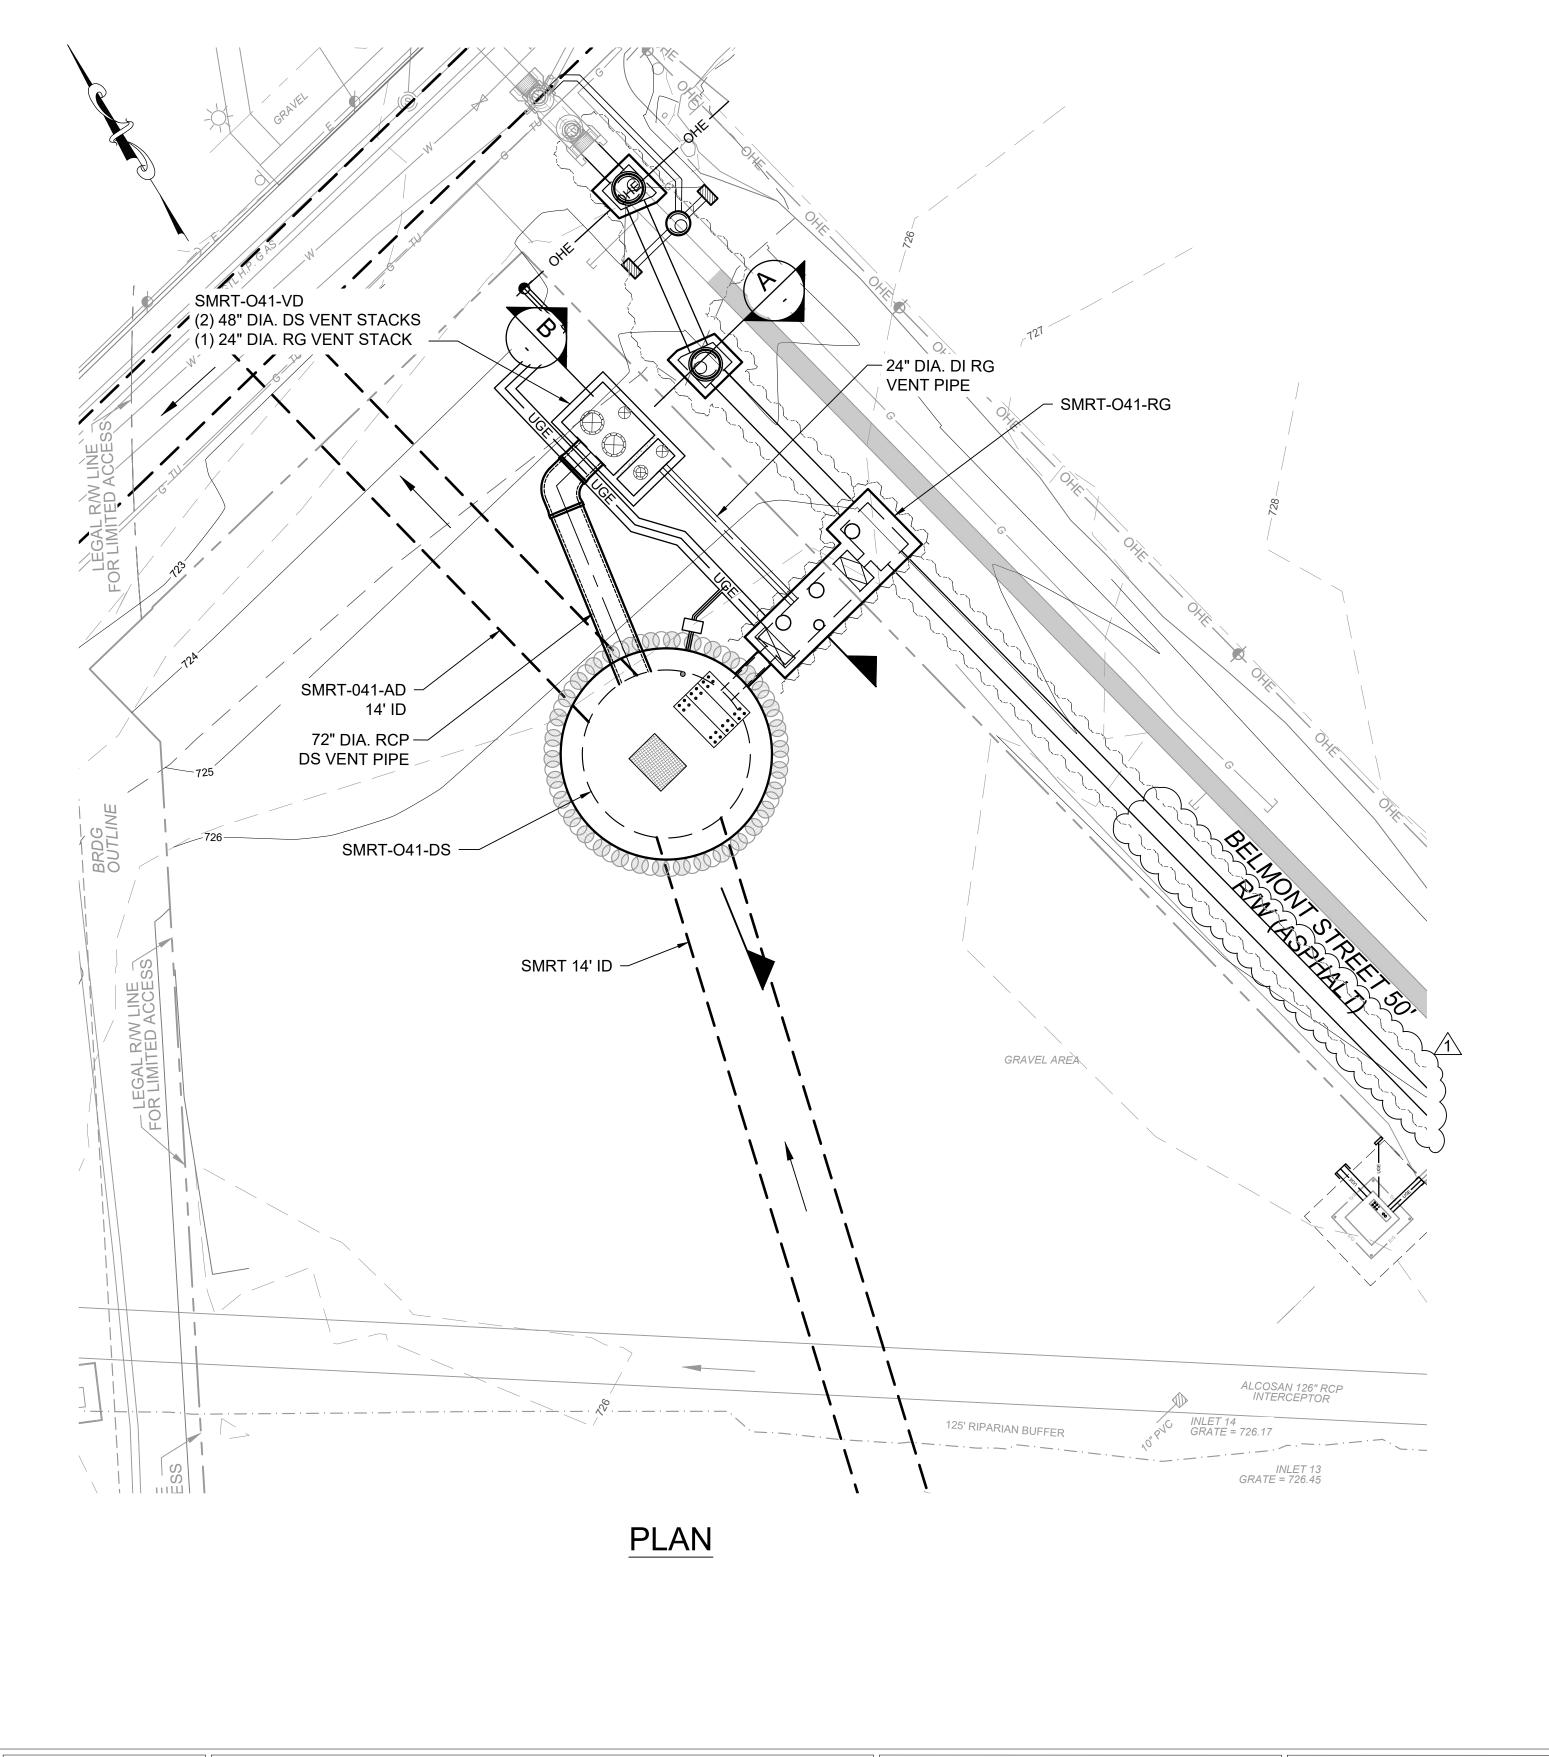

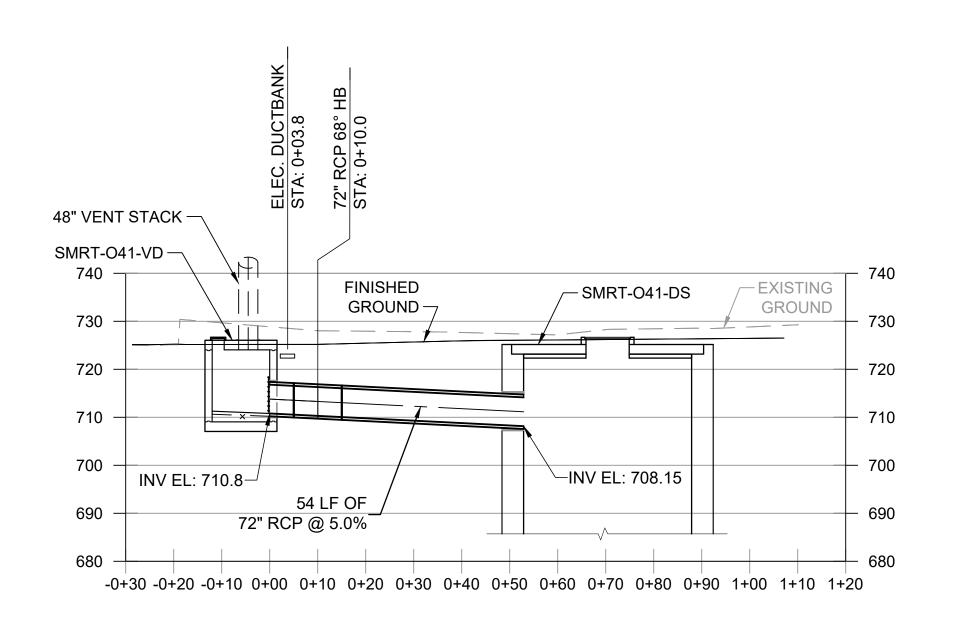

72" DIA. DS VENT PIPE PROFILE



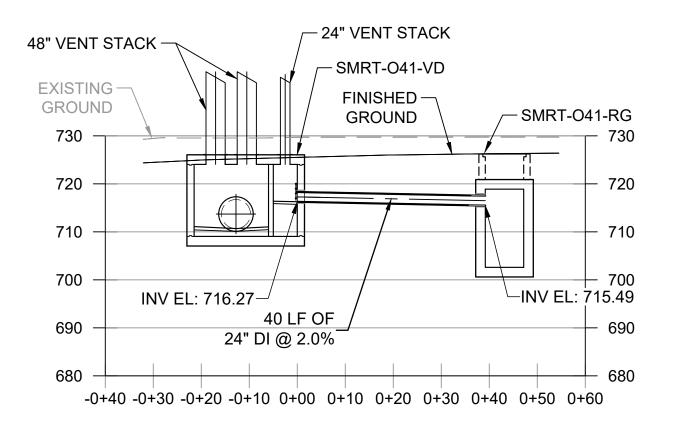

24" DIA. RG VENT PIPE PROFILE



20	()	2	0	40
	_		IN FEE 1" = 20		


Contract:

വ								
5	Designed by:	REVISION						
<u></u>		REV No.	DATE	DESCRIPTION	APPV			
[۵	JRL	1	12/23/25	REVISION FOR ADDENDUM 11	ZC			
	Drawn by:					-		
?								
ان	VN							
⋛	Checked by:					IV.		
<u> </u>						N		
ΞI	DI M							

MOTT MACDONALD

Two Allegheny Center Nova Tower 2, Suite 1301 Pittsburgh, PA 15212 (412) 497 - 2900



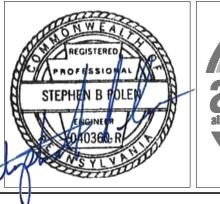





	ARLETTA SCOTT WILLIAMS EXECUTIVE DIRECTOR, ALCOSAN
	EXECUTIVE BINEOTON, NEGOCINA
an	3300 PREBLE AVE.
	PITTSBURGH, PA 15233
ary authority	(412) 766 - 4810
	,
	www.alcoson.org
	www.alcosan.org

ALLEGHENY COUNTY SANITARY AUTHORITY (ALCOSAN) OHIO RIVER TUNNEL (ORT)

O41-CI-205.dwg O41-CI-205 UTILITY PLAN 07/30/2025 Sheet: VENTILATION PLAN AND PROFILE 304 OF 770

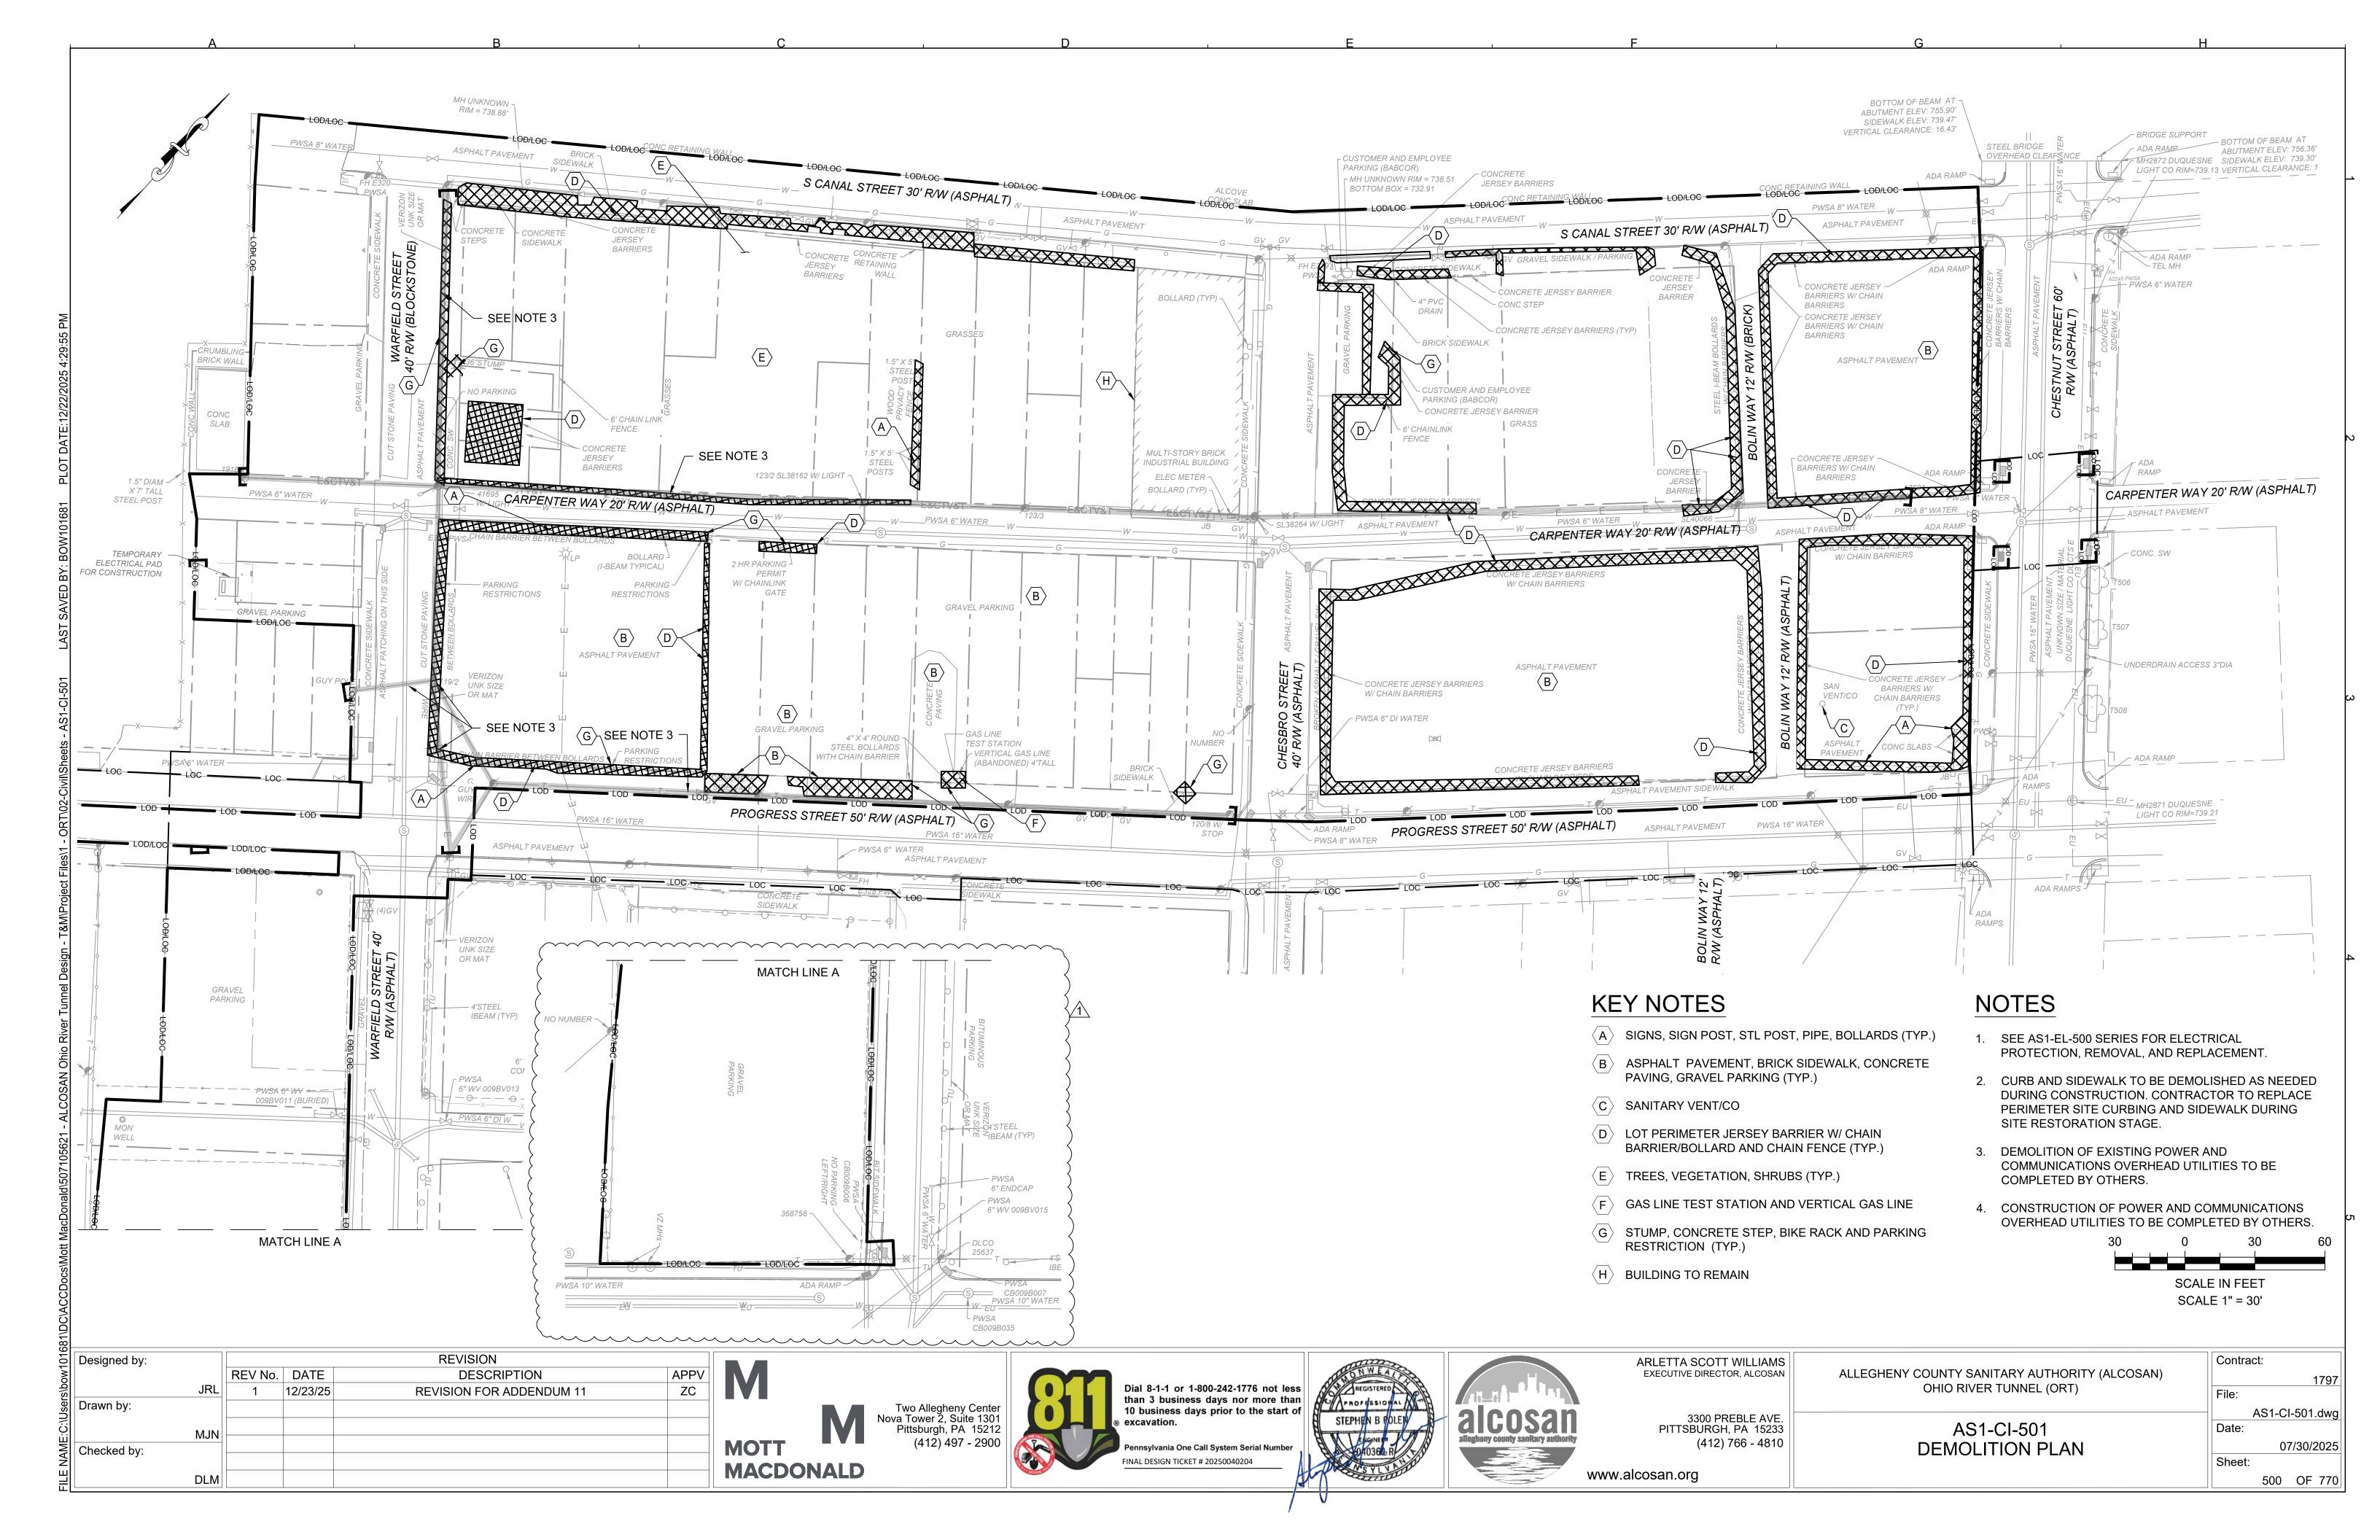

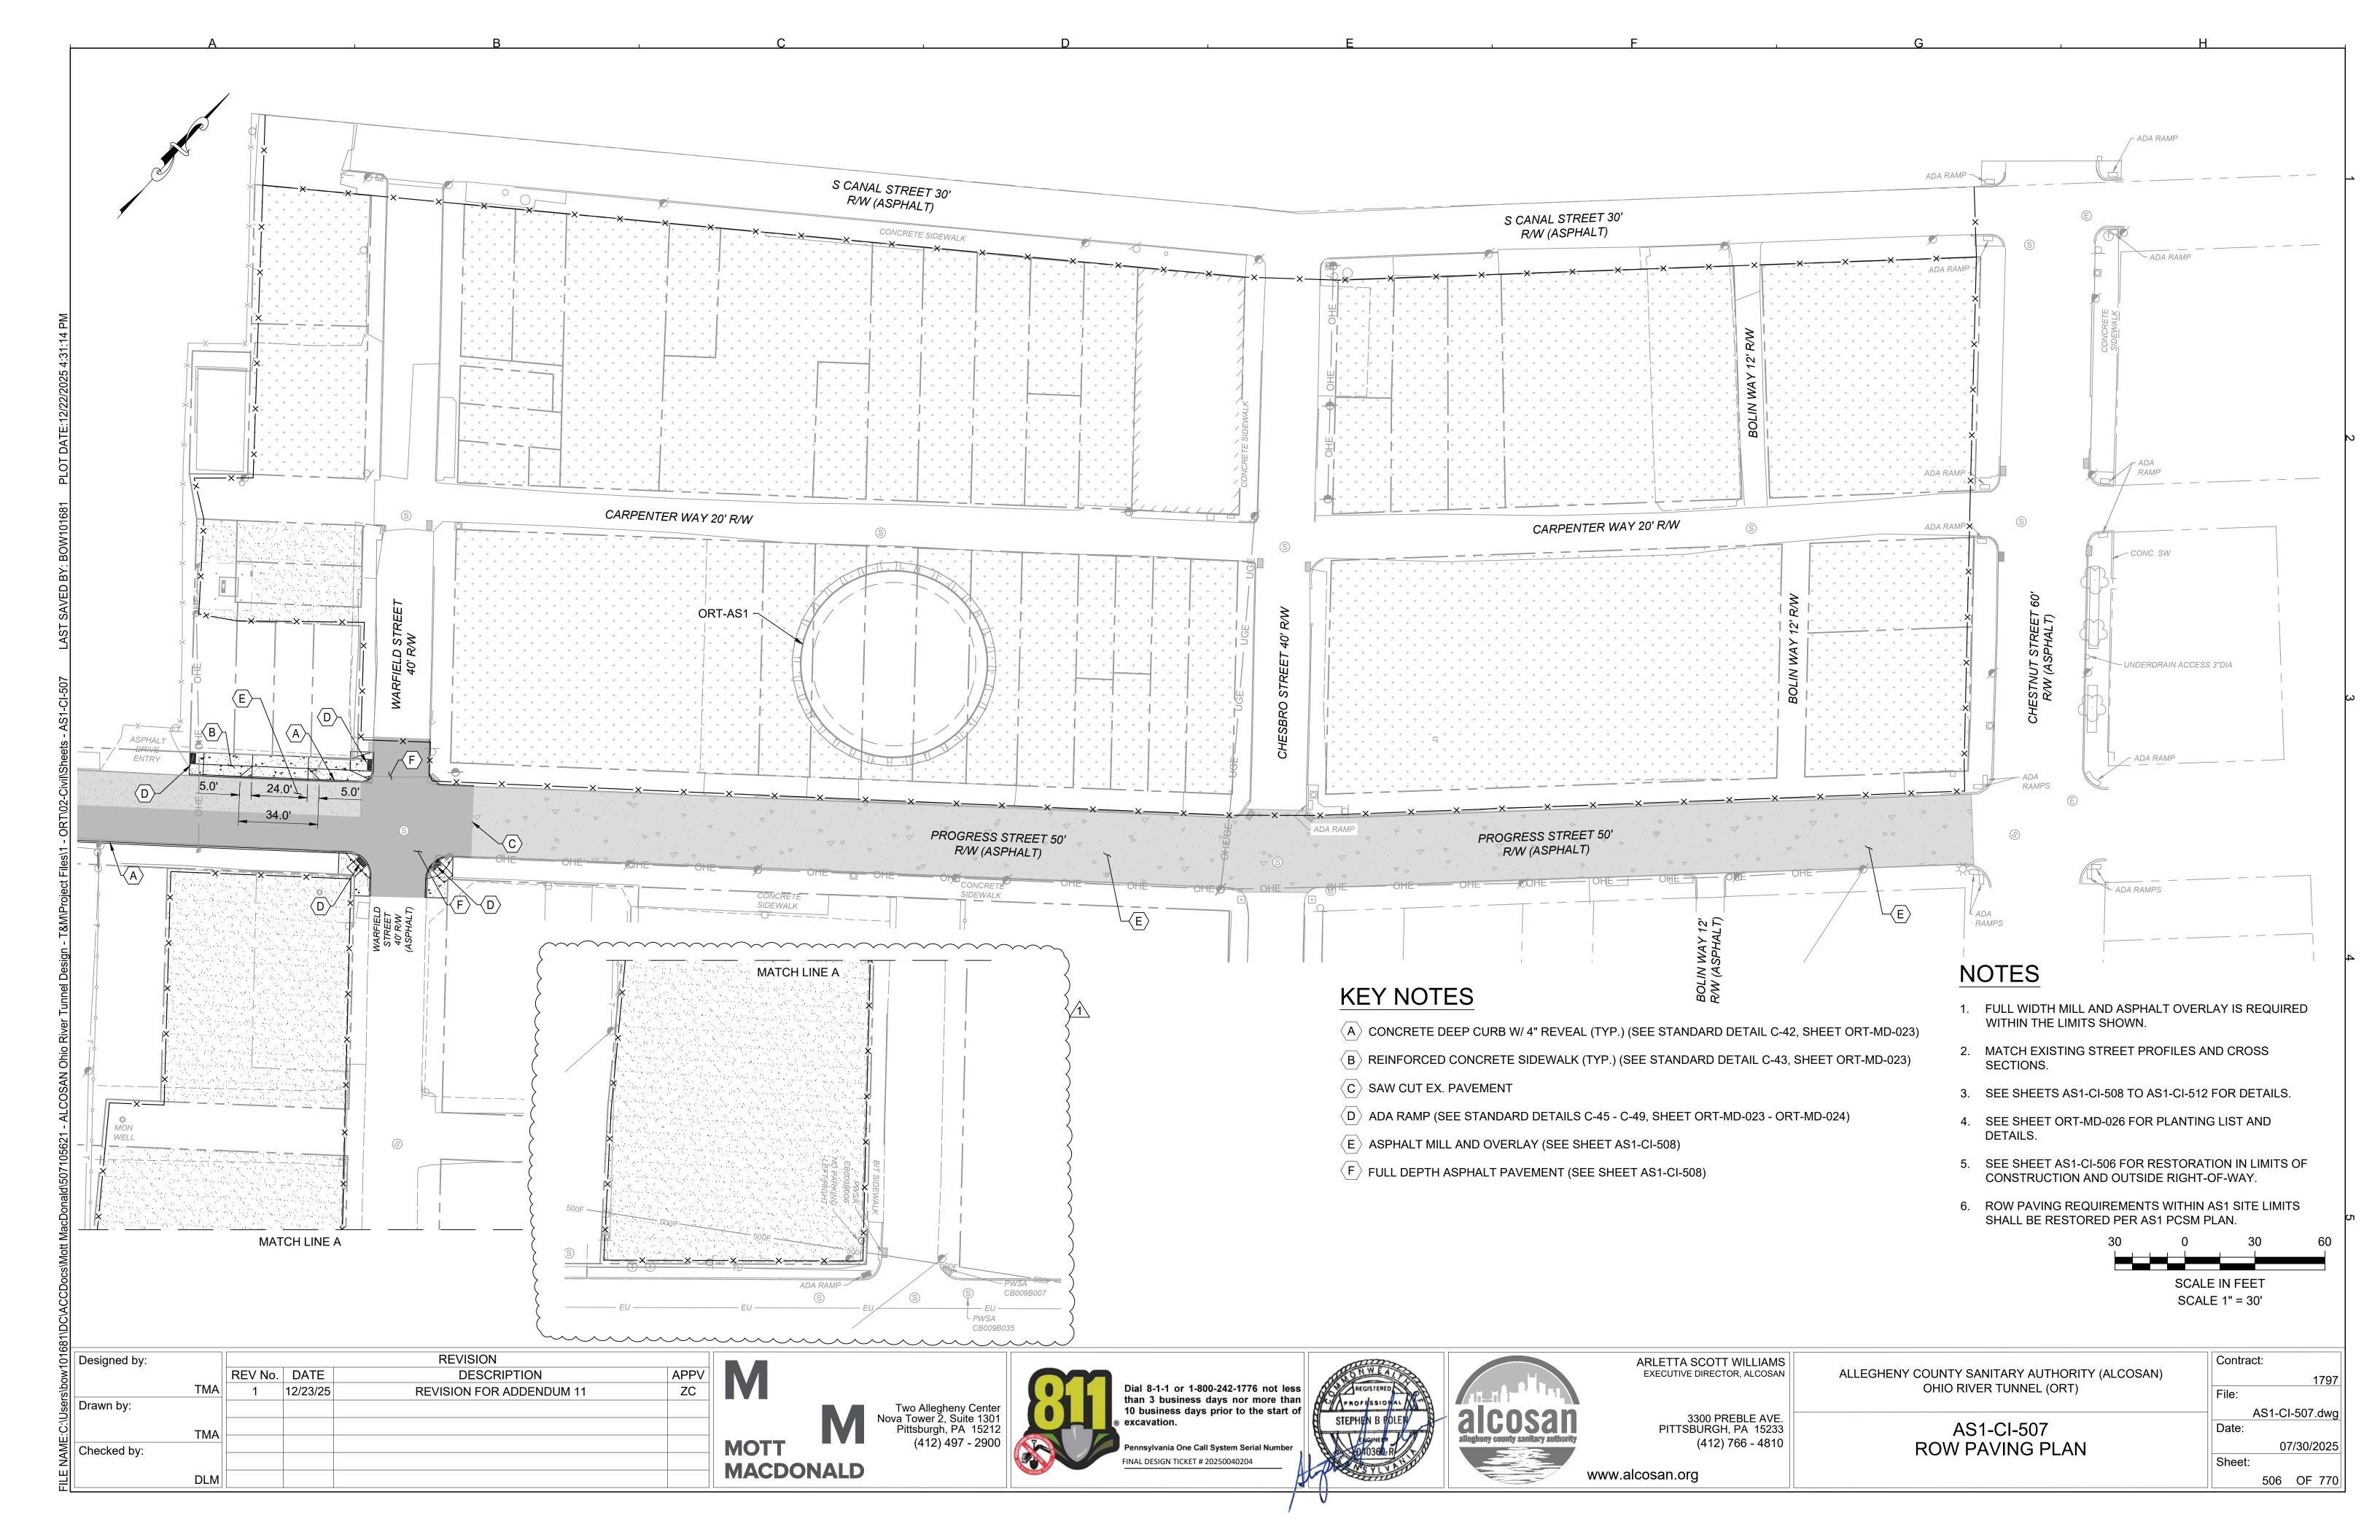

Attachment E

APPENDIX E – SUPPLEMENTAL INFORMATION (FOR INFORMATION ONLY)

SECTION 5.7.3

• Robb Street Sewer (8 sheets including Appendix E – Supplemental Information fly sheet) (Referenced Project Number 76-0212-006-02)


Attachment E


APPENDIX E – SUPPLEMENTAL INFORMATION (FOR REFERENCE ONLY)


SECTION 5.7.3


Pages from Robb Street Sewer, Project Number 76-0212-006-02


- Robb Street Sewer and Pump Station GraphicRobb Street Pump Station Drawings (November 1977)

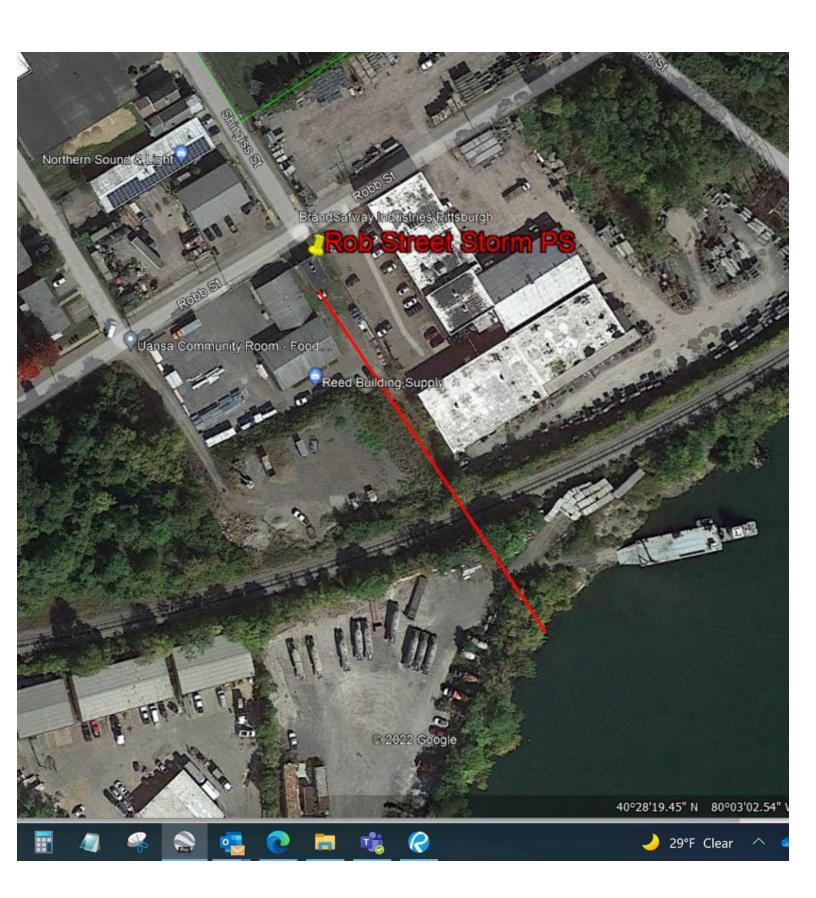


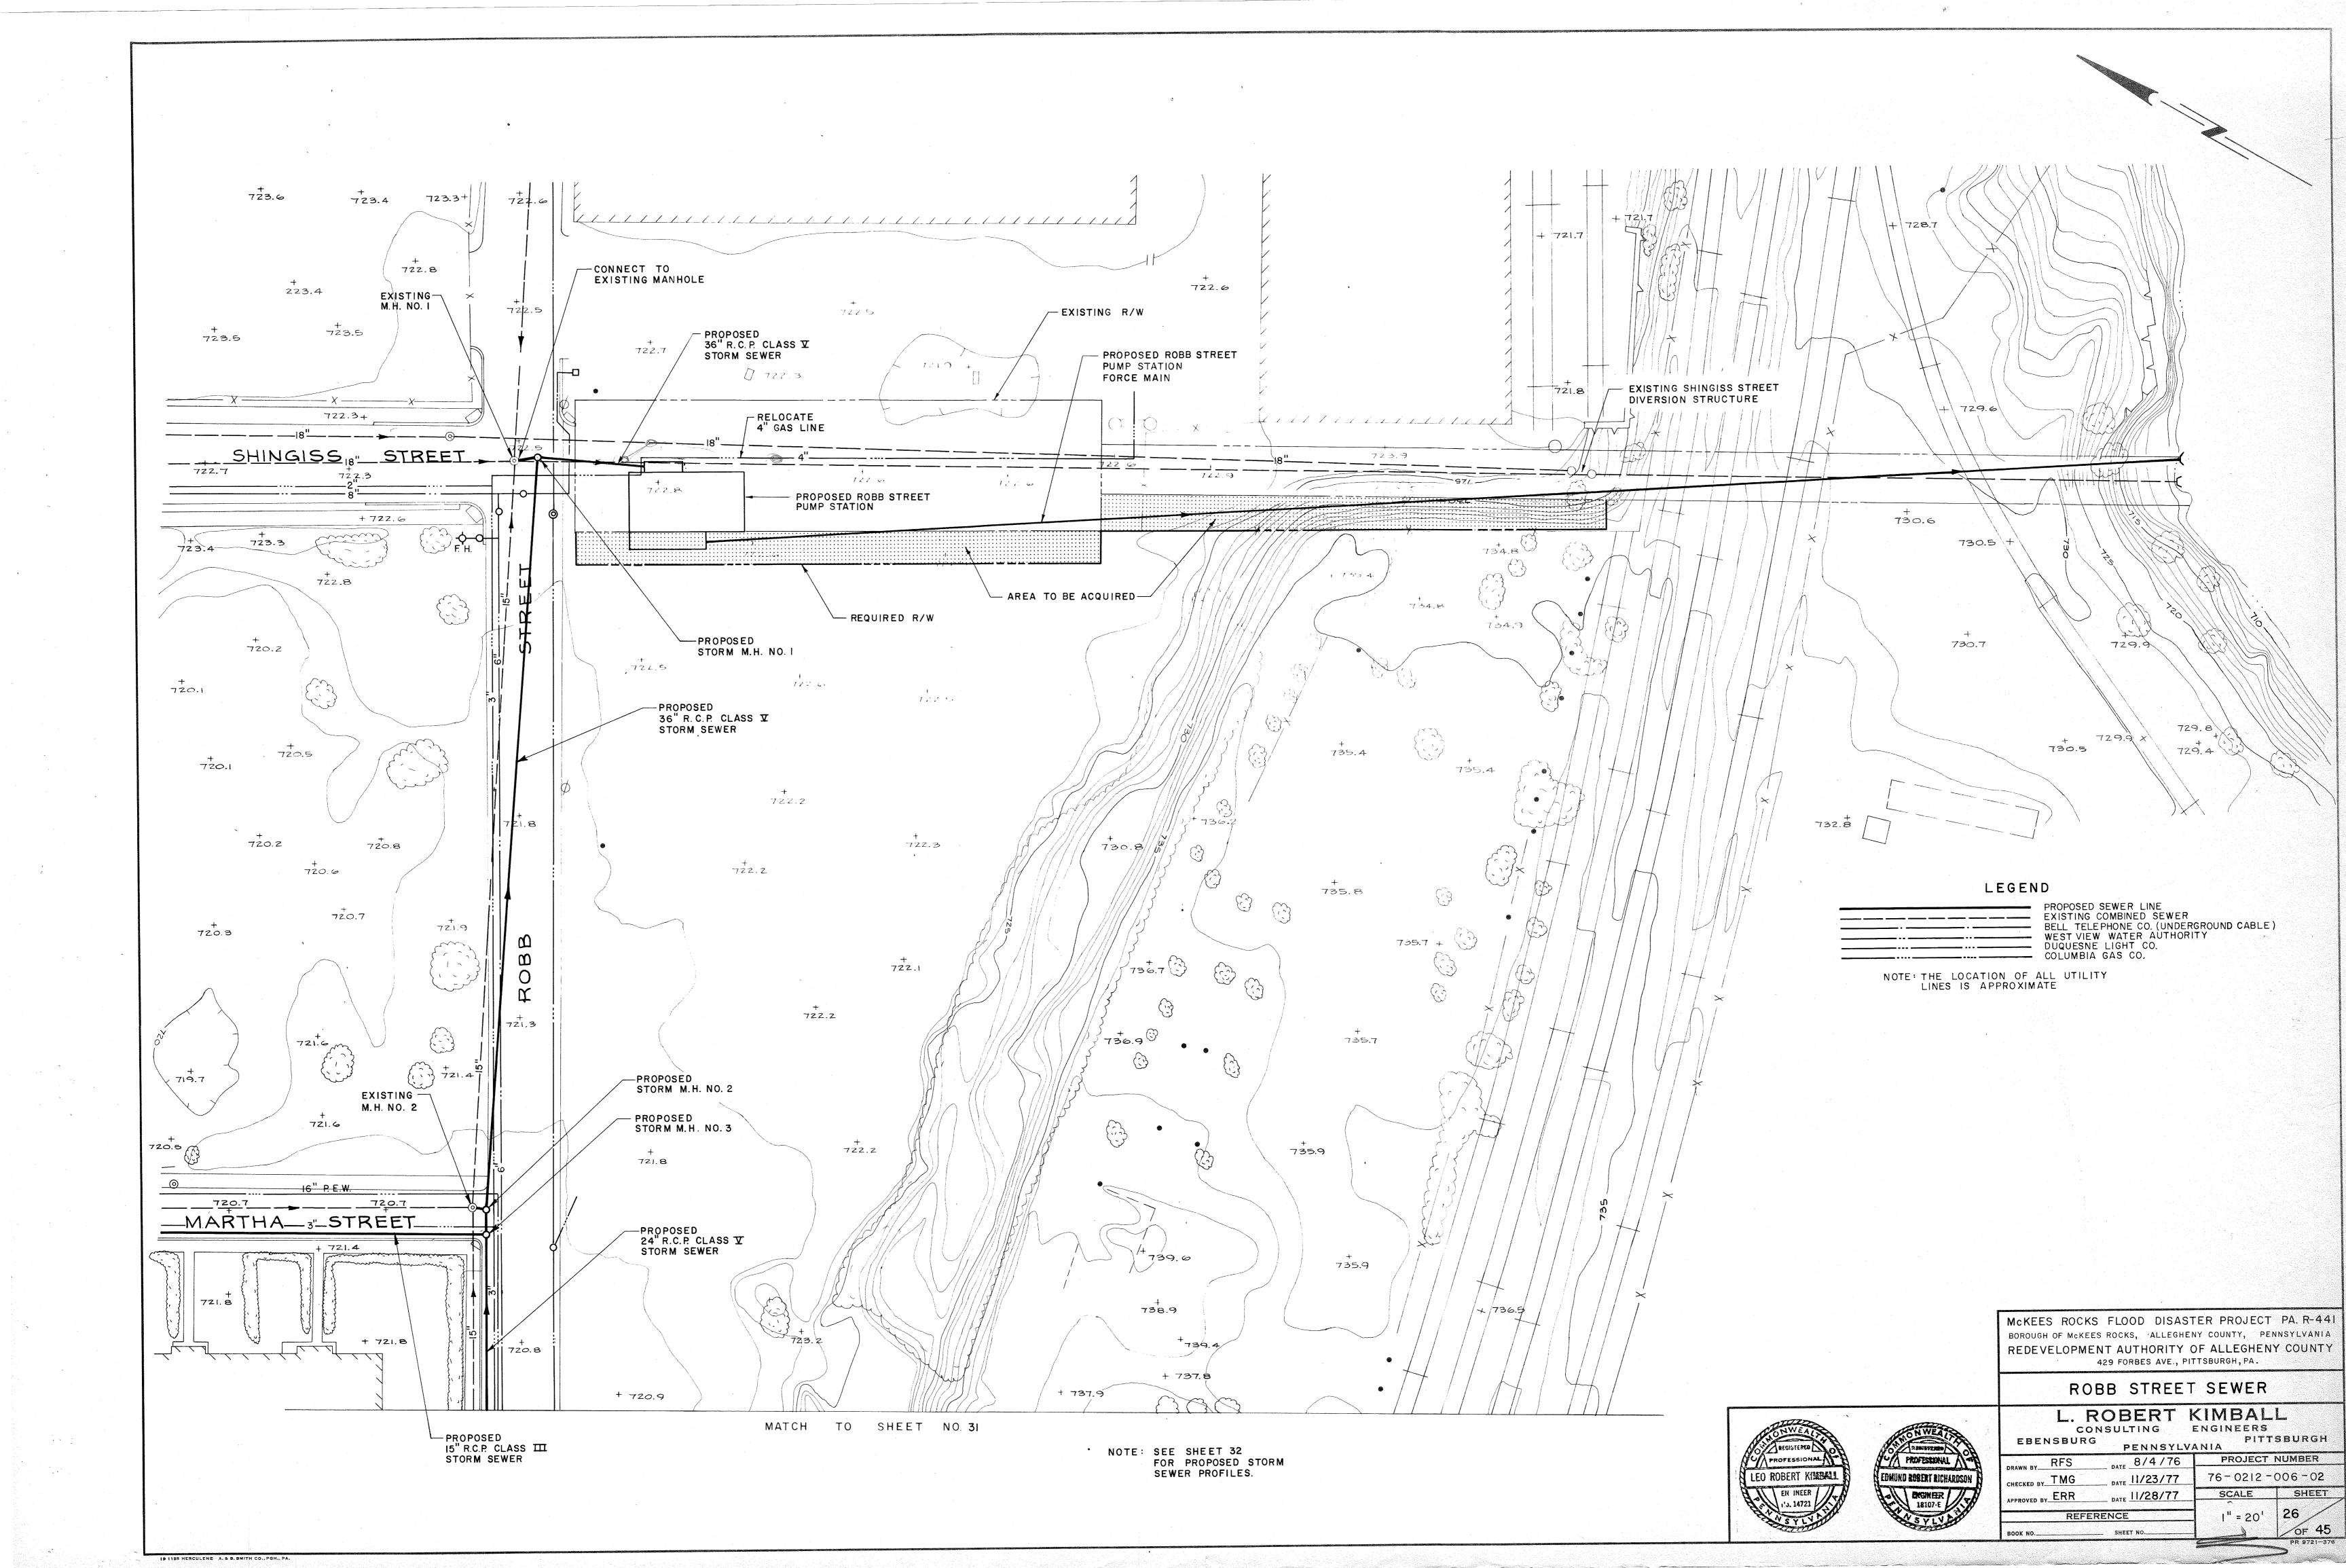

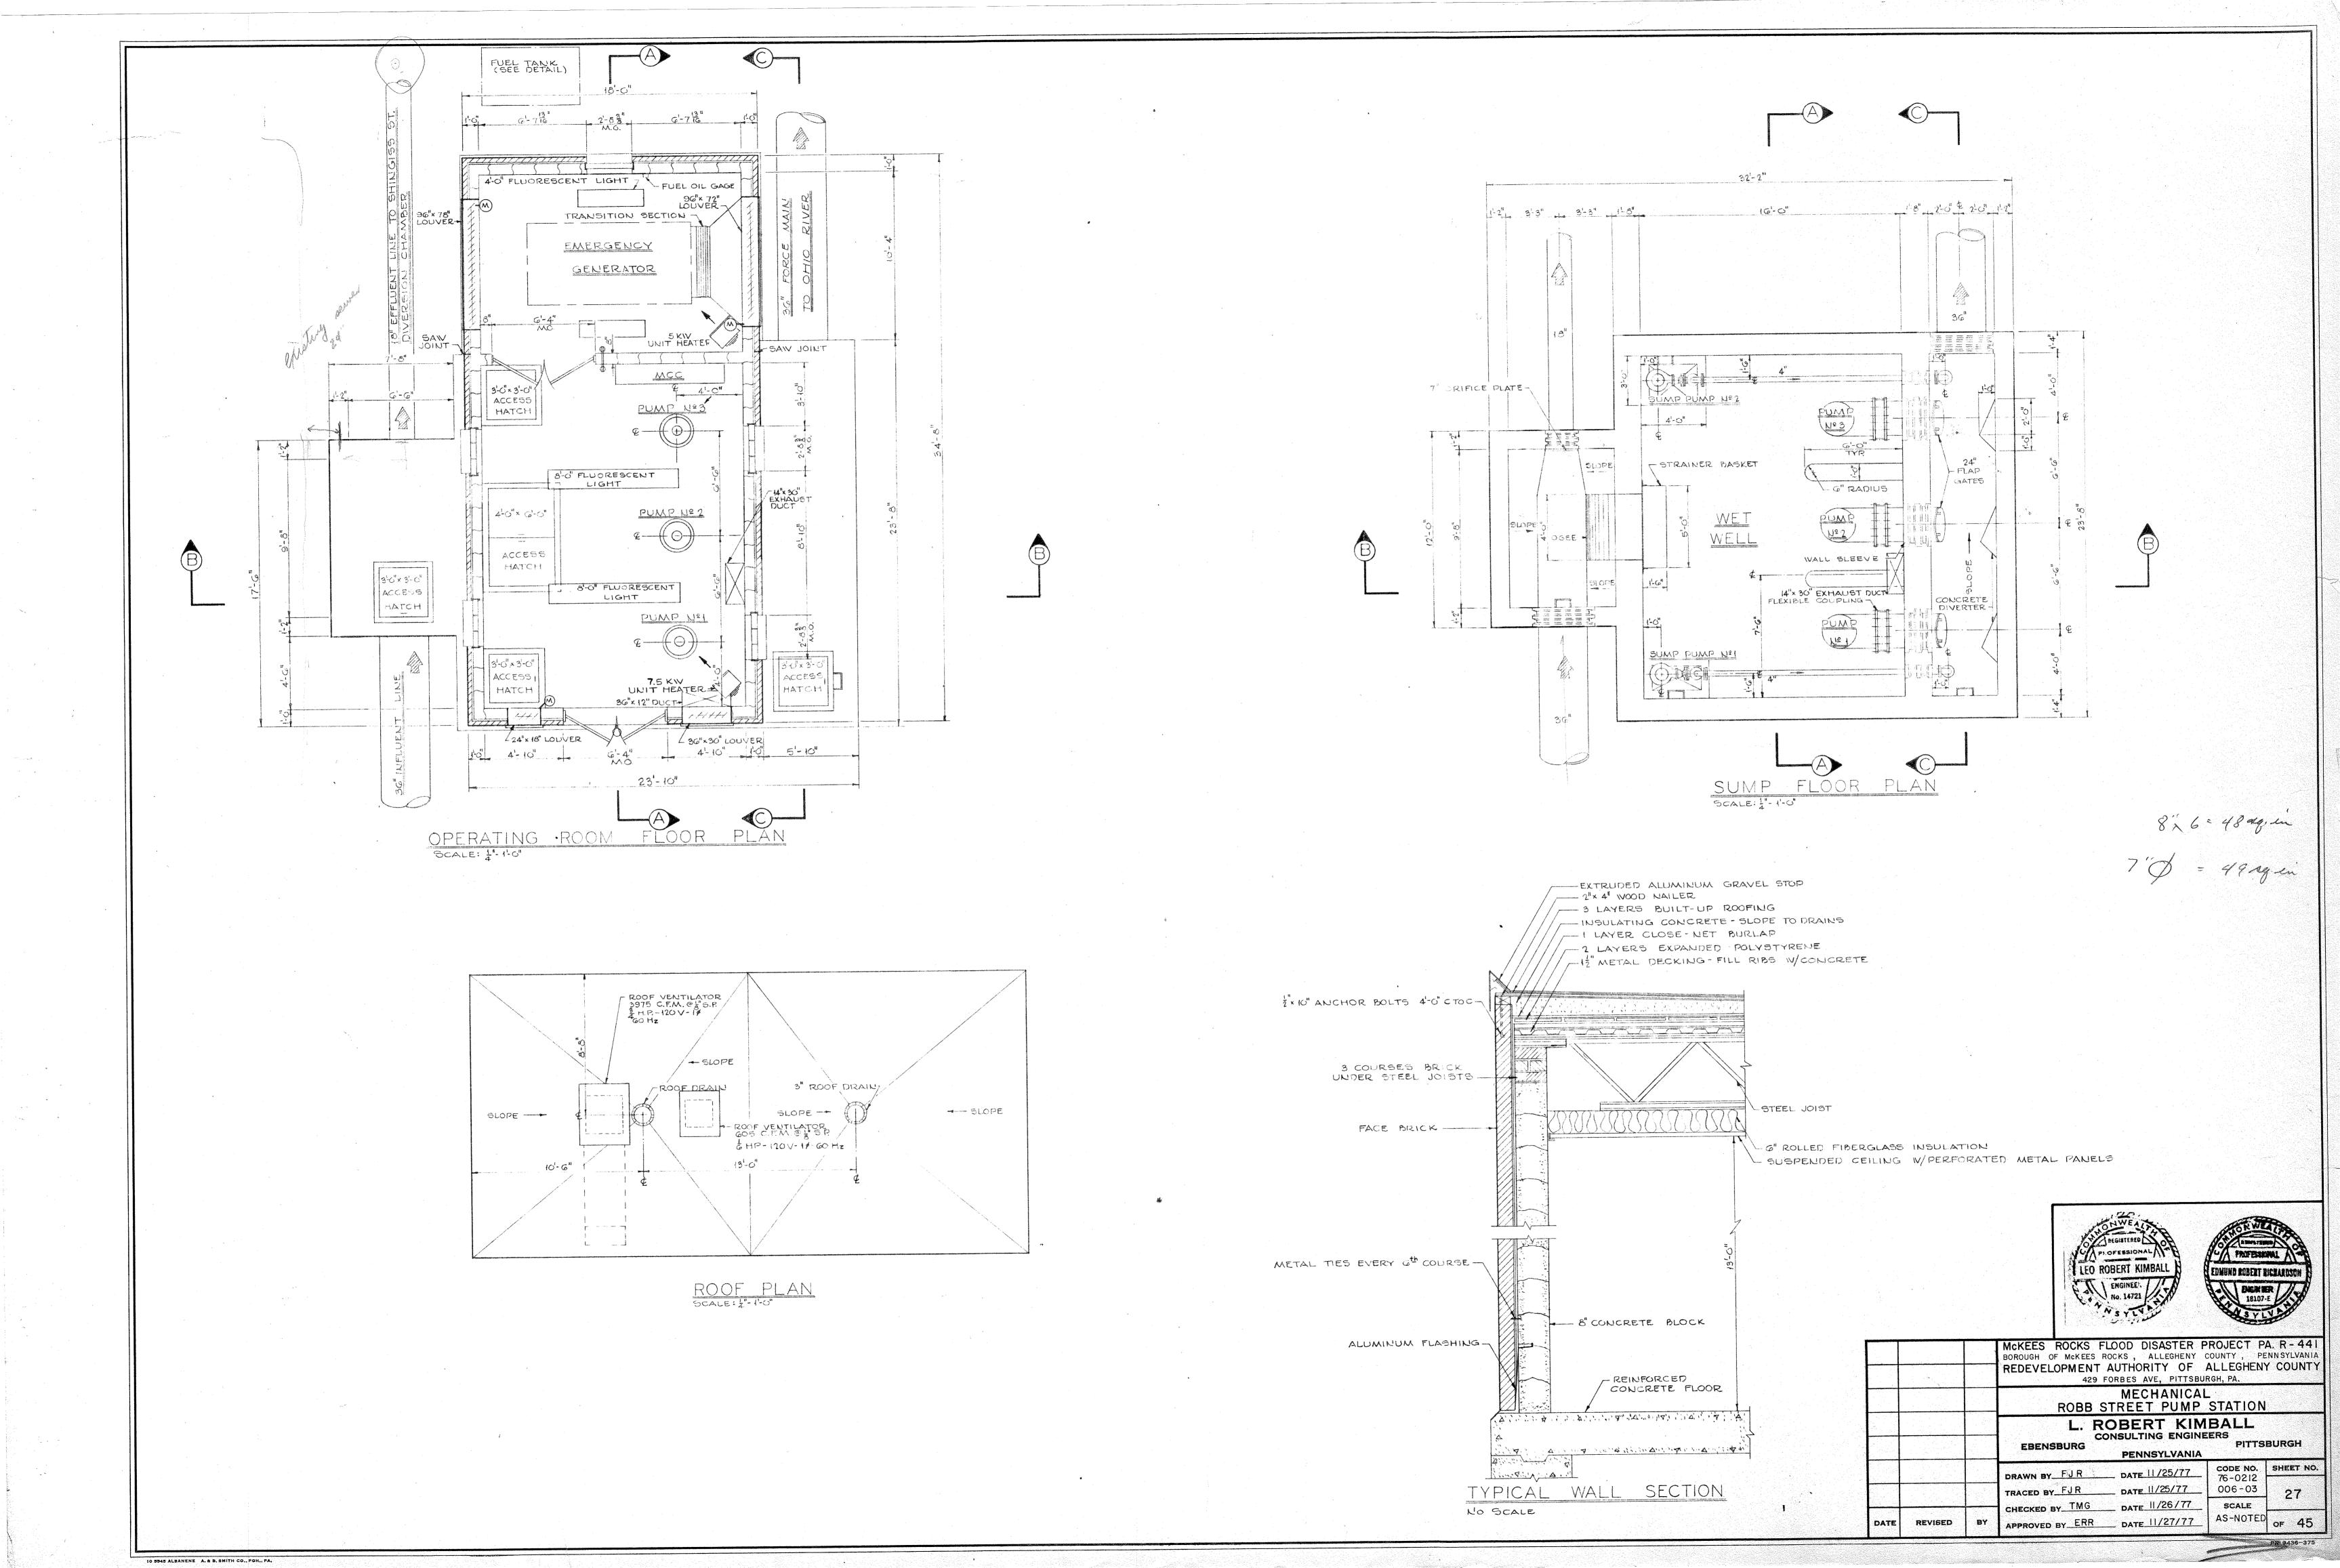

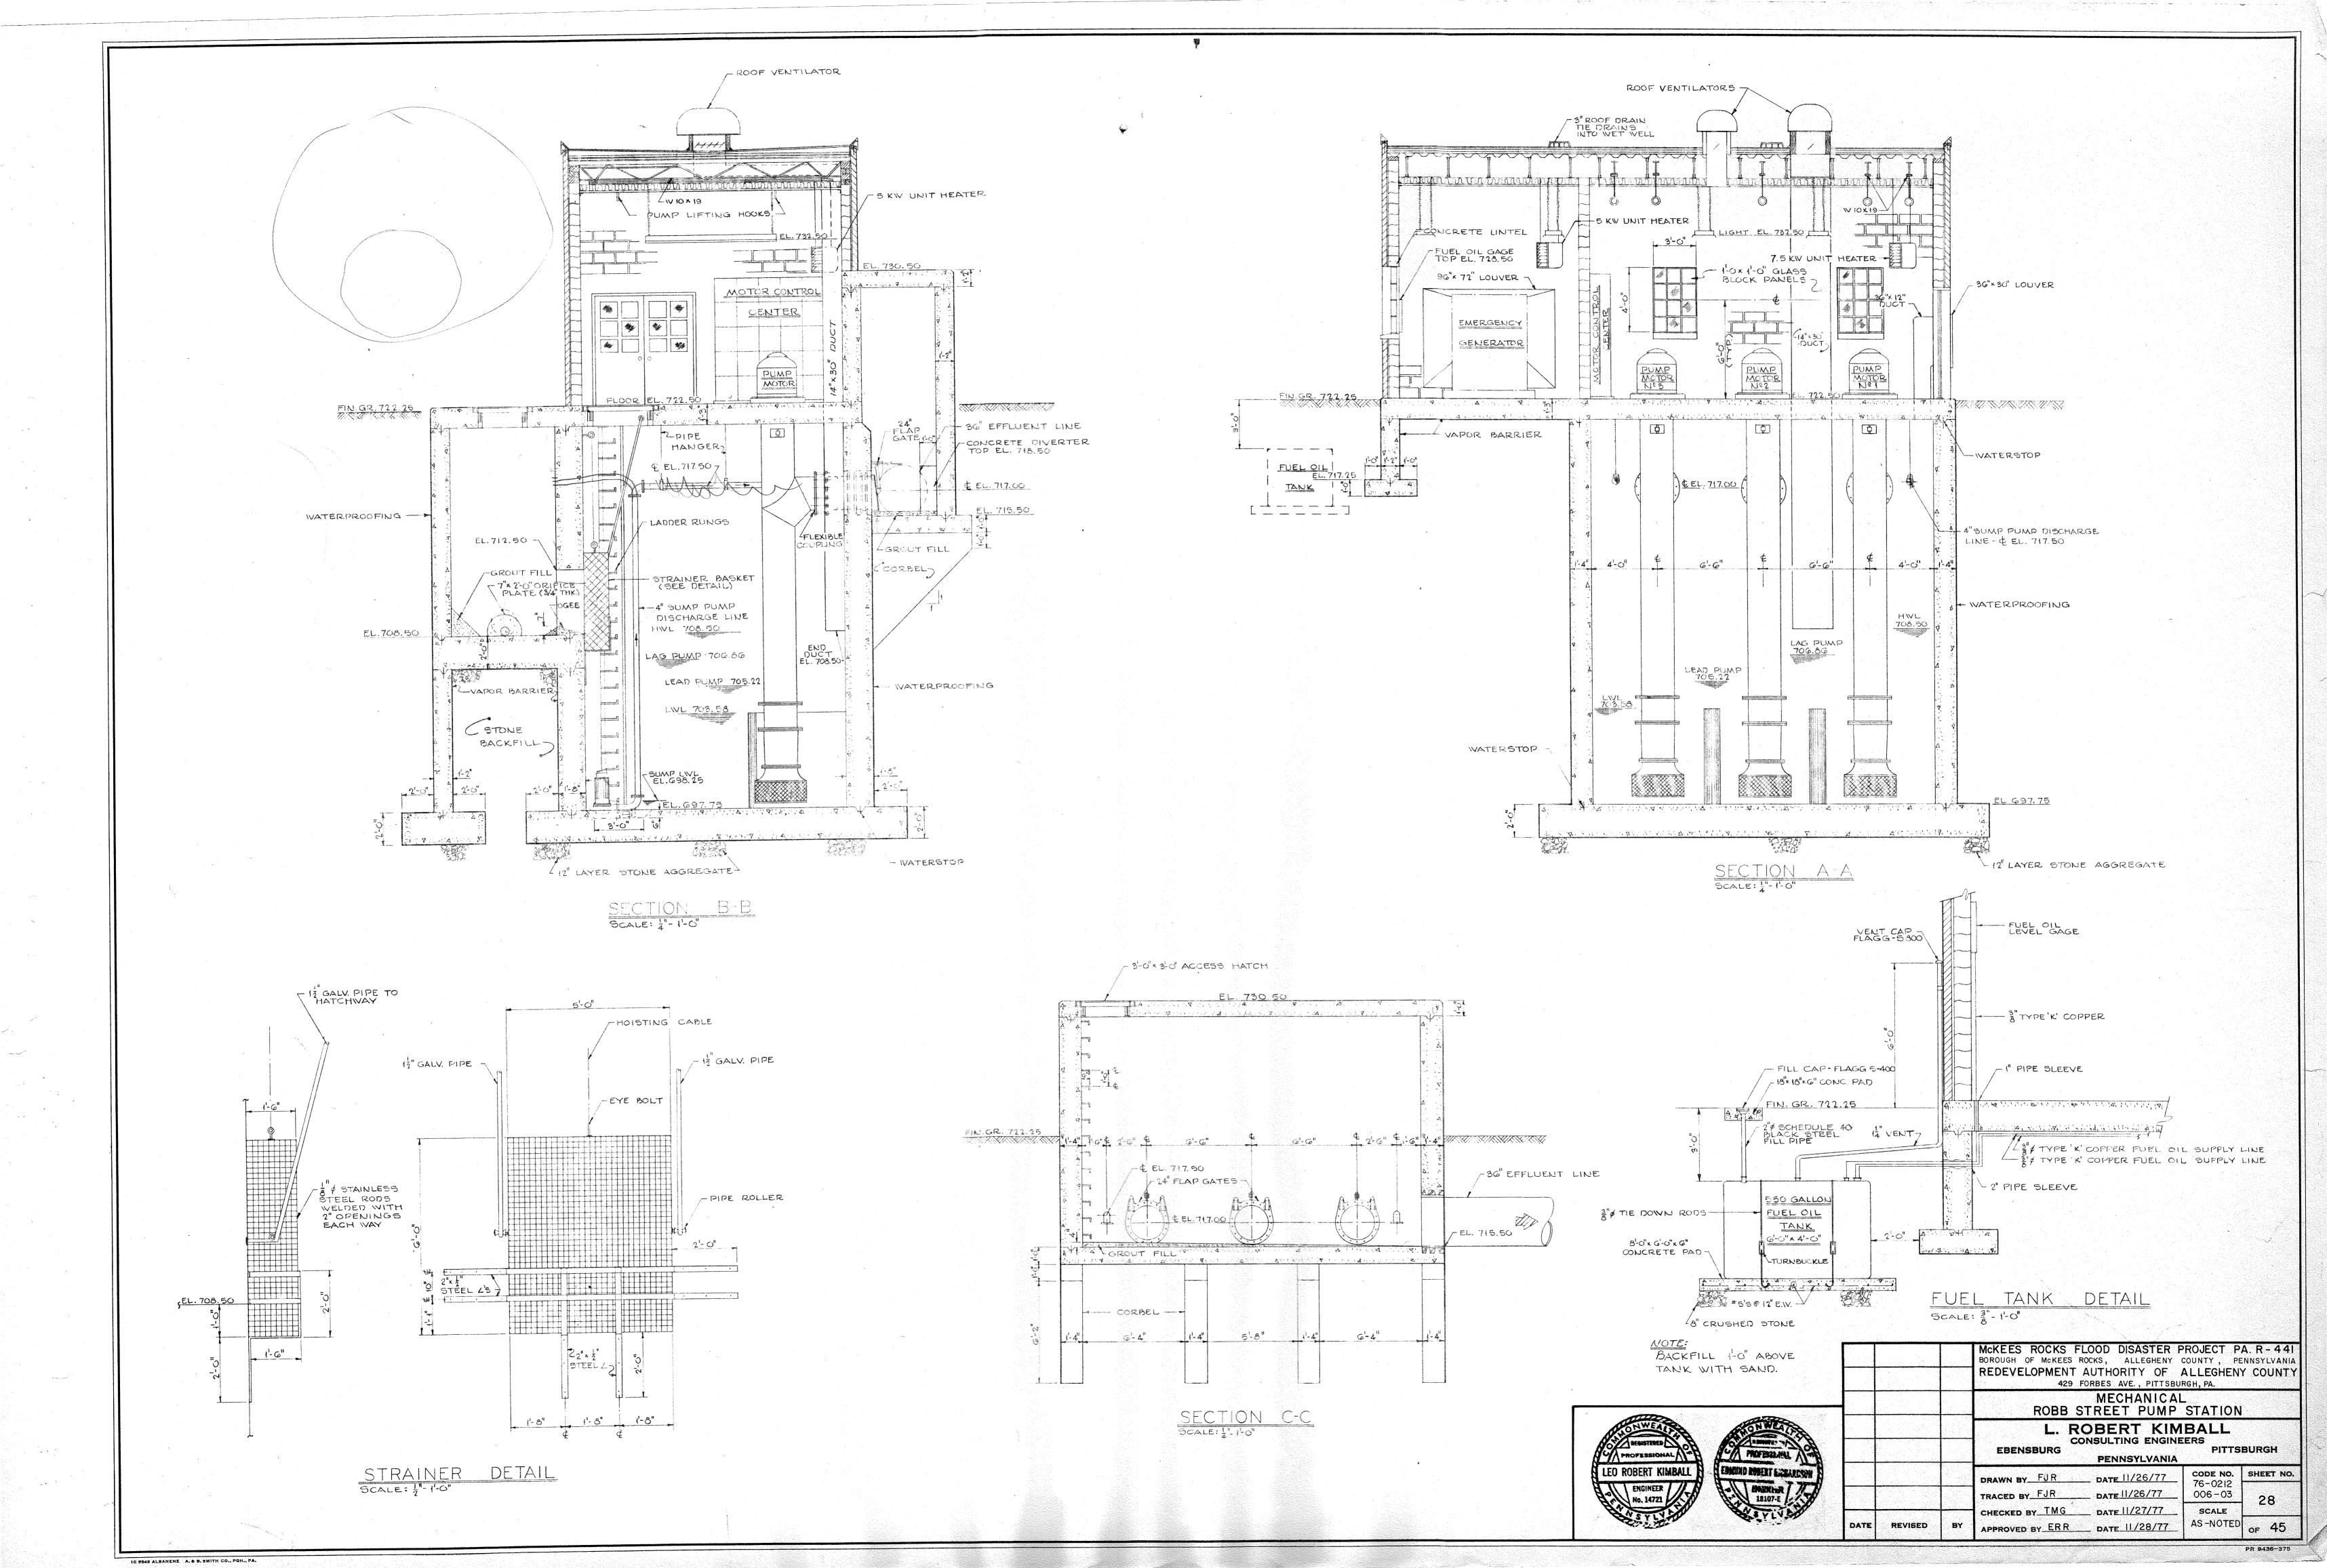

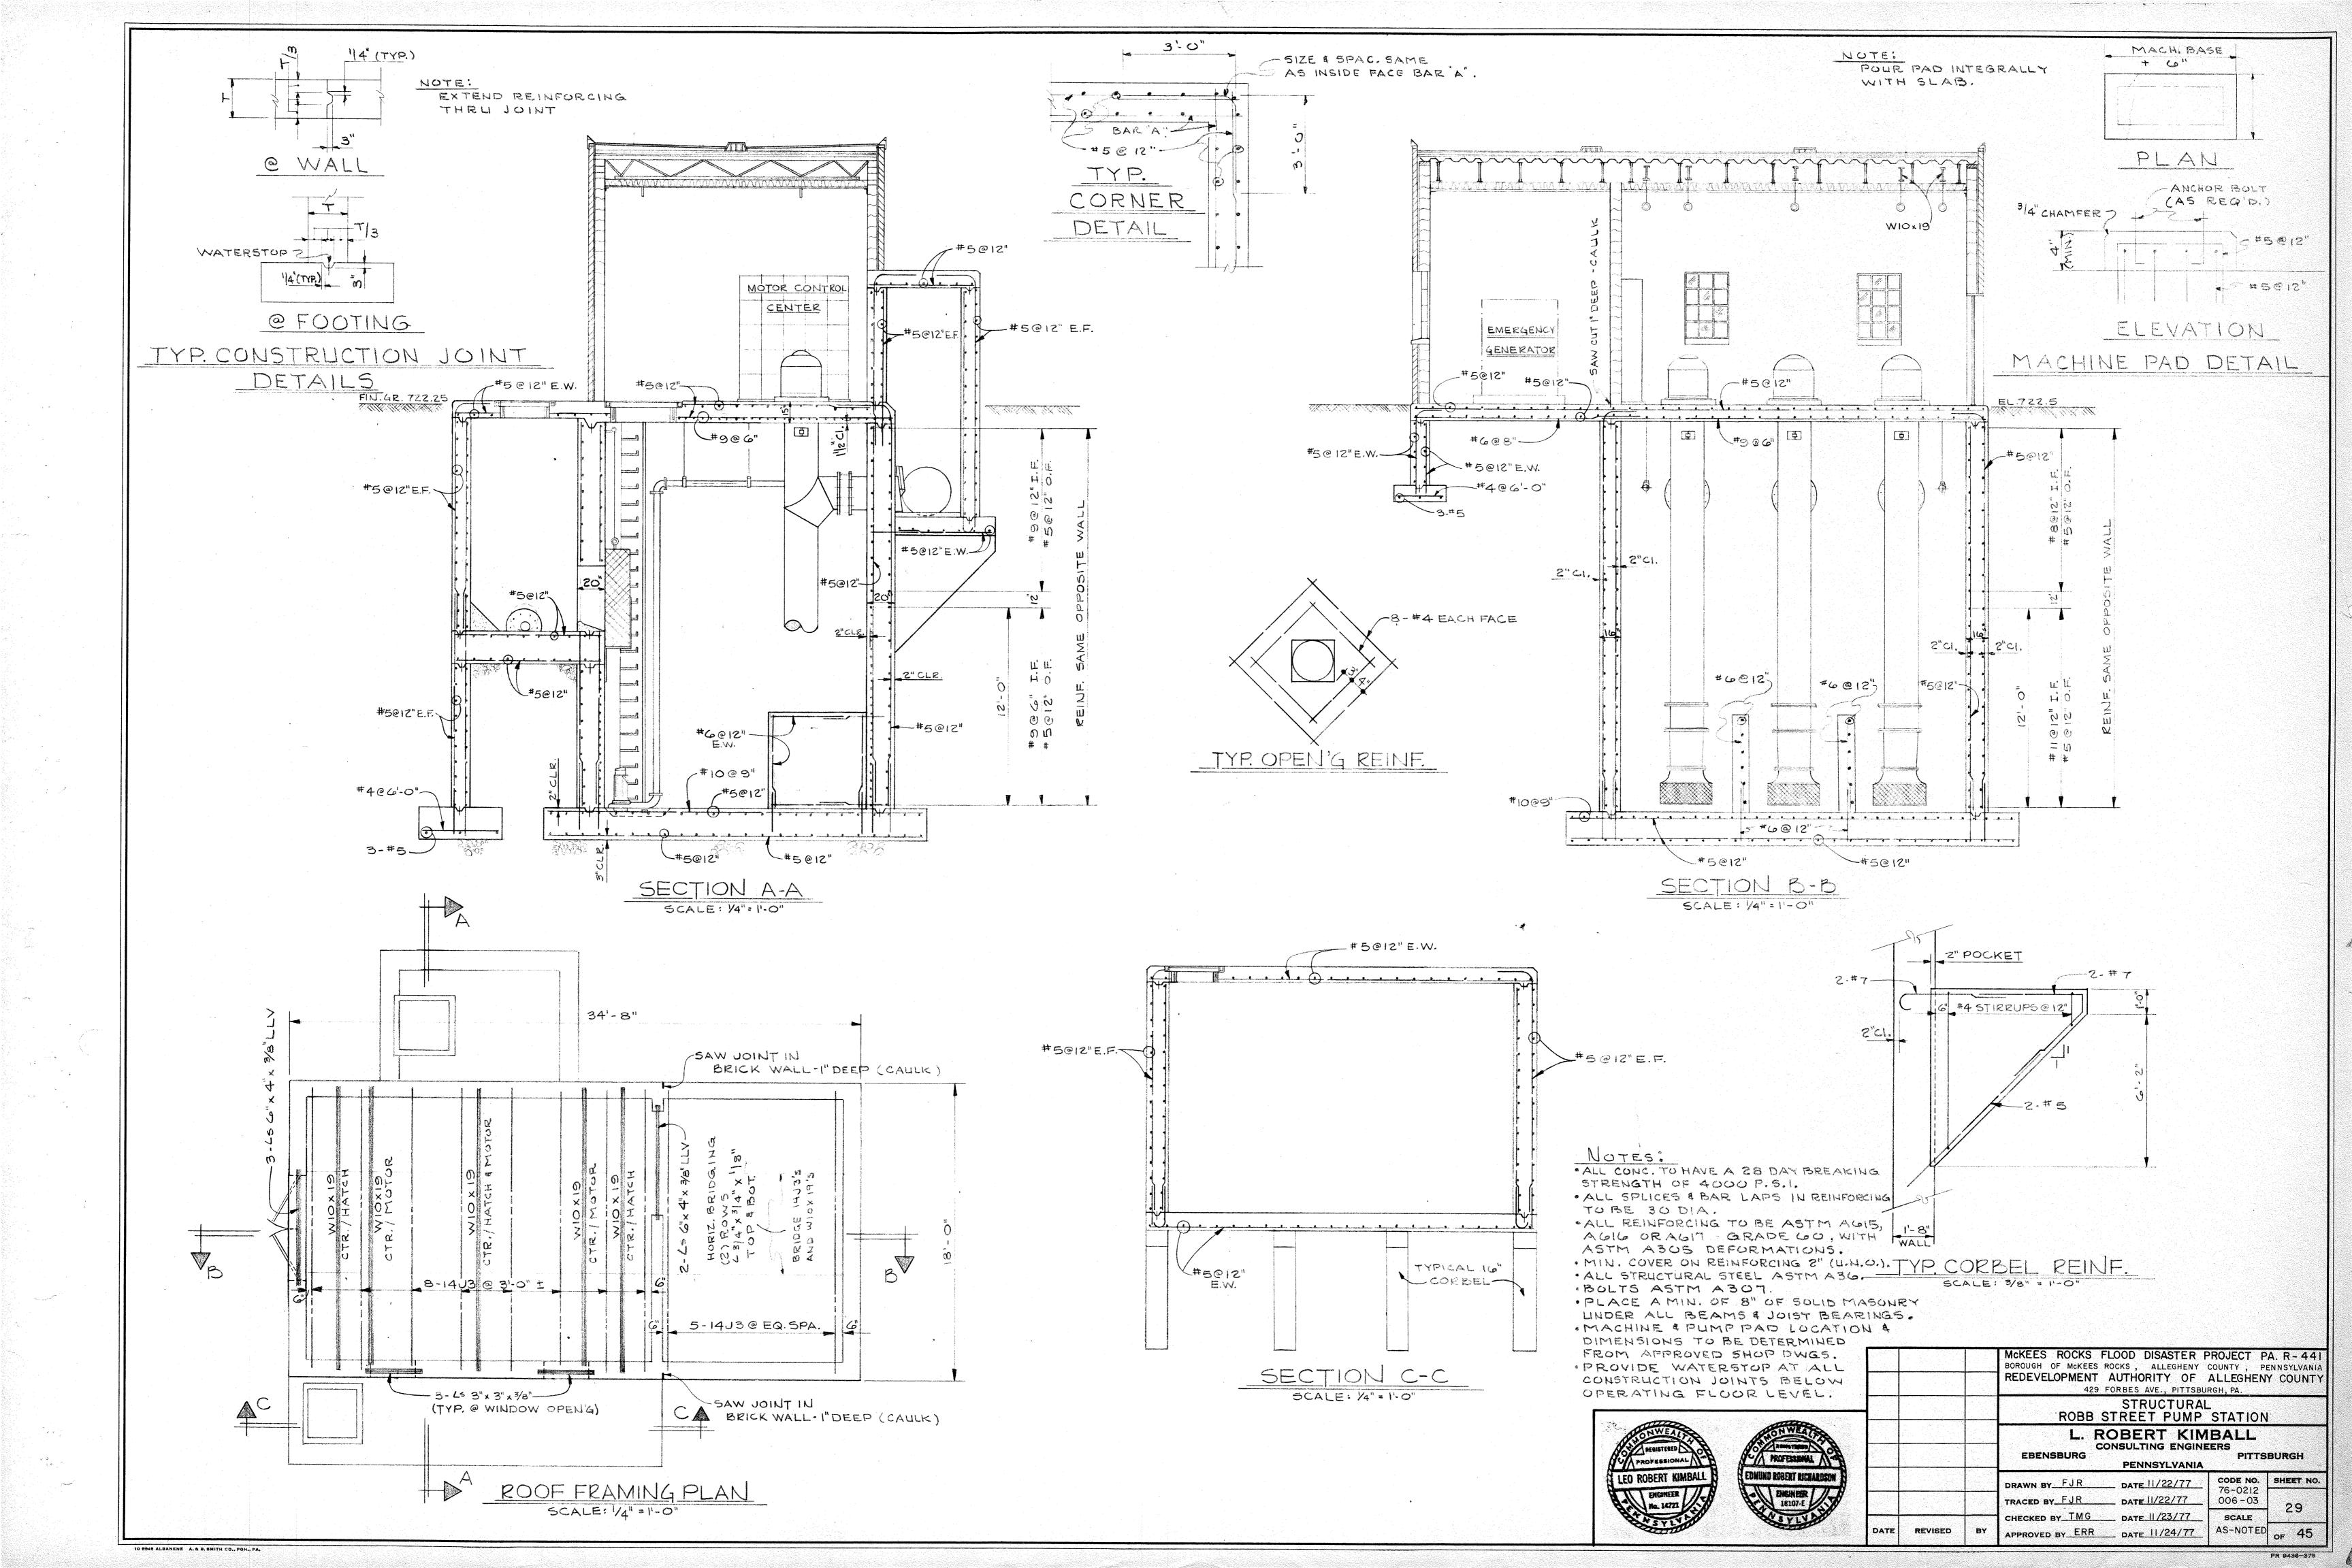


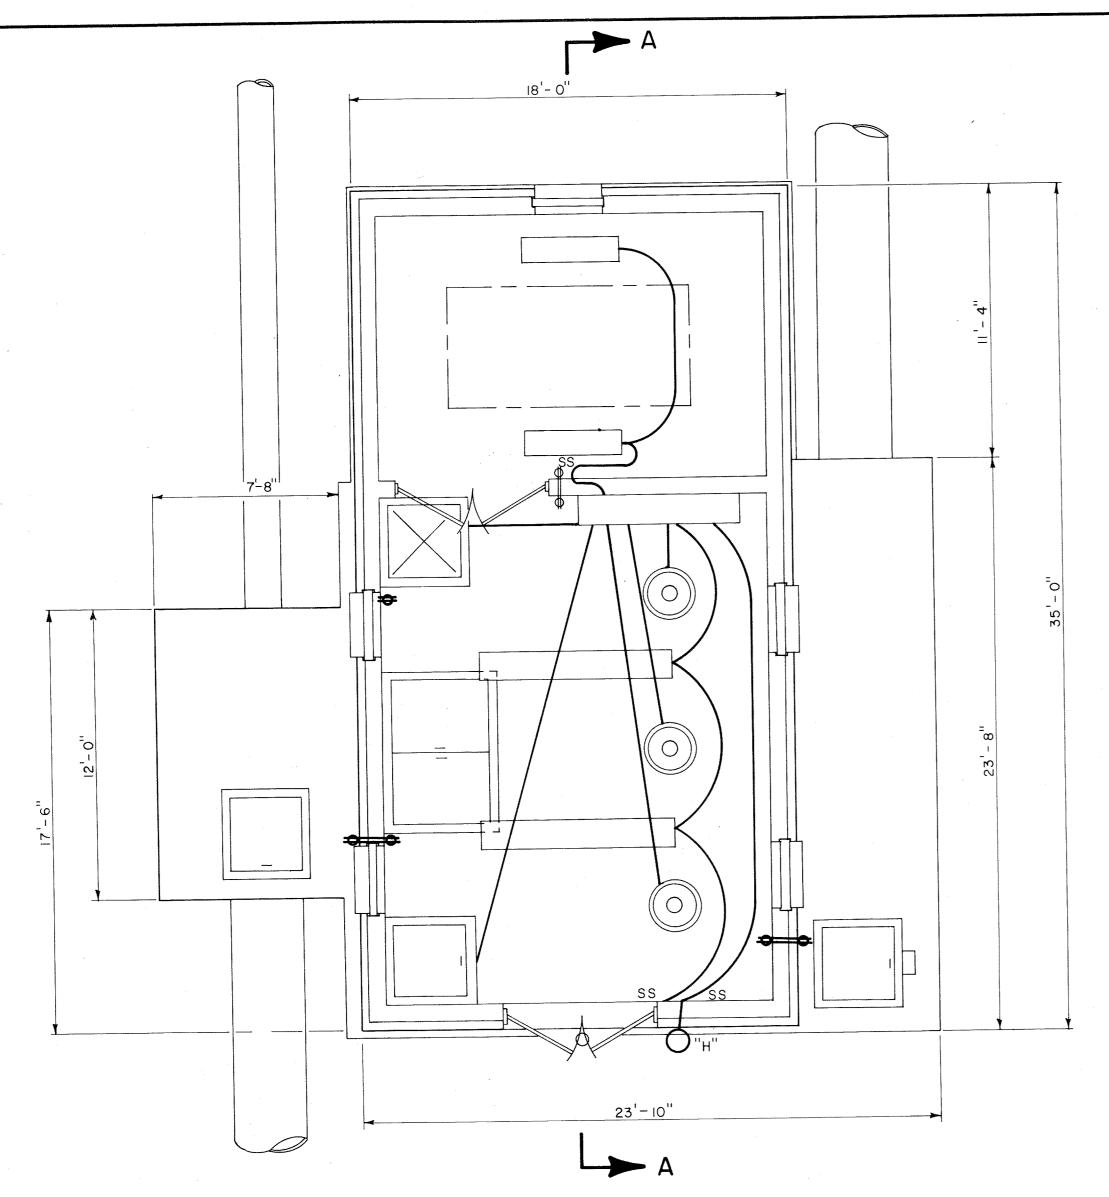

OPERATING ROOM FLOOR PLAN


SCALE: 1/4" = 1'-0"


	FOURMENT	11.5		COMBIN	ATION STA	RTER	MOTOR BRANCH CIRCUIT					
	EQUIPMENT DESCRIPTION	H.P. K.W.	NEMA	DOLES	ACCESSORIES	FUSIBLE SW.	DISC.	SW.	NO.	COND. SIZE	COND.	REMARKS
	DESCRIPTION	11. 11.	SIZE	PULES	ACCESSORIES	SIZE AMPS	SIZE	NEMA	COND.	AWG	IN.	
1	MAIN DISCONNECT			3		800			And the same of th		- And Andrews -	FUSED AT 700 AMPS
2	TRANSFER SWITCH			-						-	-	700 AMPS
3	TRANSFORMER SWITCH		-	2		50						FUSED AT 40 AMPS
4	UNIT HEATER	7 1/2					-					
5	UNIT HEATER	5				,						
6	TRIPLEX ALTERNATOR AND ALARM					•						
7	DUPLEX ALTERNATOR	A CONTRACTOR OF THE CONTRACTOR										
8	SUMP PUMP #1	7 1/2	ı	3	12345	30	30 NF	4	3	# 10	111	FULL VOLTAGE NON REVERS
9	SUMP PUMP #2	7 1/2	1	3	12345	30	30 NF	4	3	# 10	111	FULL VOLTAGE NON REVERS
10	FLOOD PUMP #1	125	5	3	12345	400	400 NF	4	3	300 MCM	3''	REDUCED VOLTAGE STARTE
11	FLOOD PUMP #2	125	5	3	12345	400	400 NF	4	3	300 MCM	3"	REDUCED VOLTAGE STARTE
12	FLOOD PUMP #3	125	5	3	12345	400	400 NF	4	3	300 MCM	3"	REDUCED VOLTAGE STARTE
	TRANSFORMER AND PANEL "A"											15 KVA; 480V-1Ø 60~ 120/240V, 1Ø AND 100 AMP-28-20A IP BKRS MAIN BREAKER

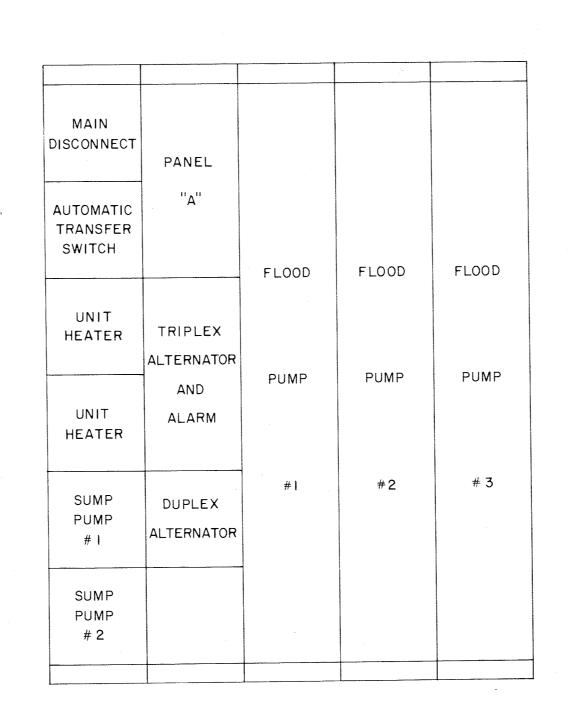

DESCRIPTION

MOTOR CONTROL CENTER

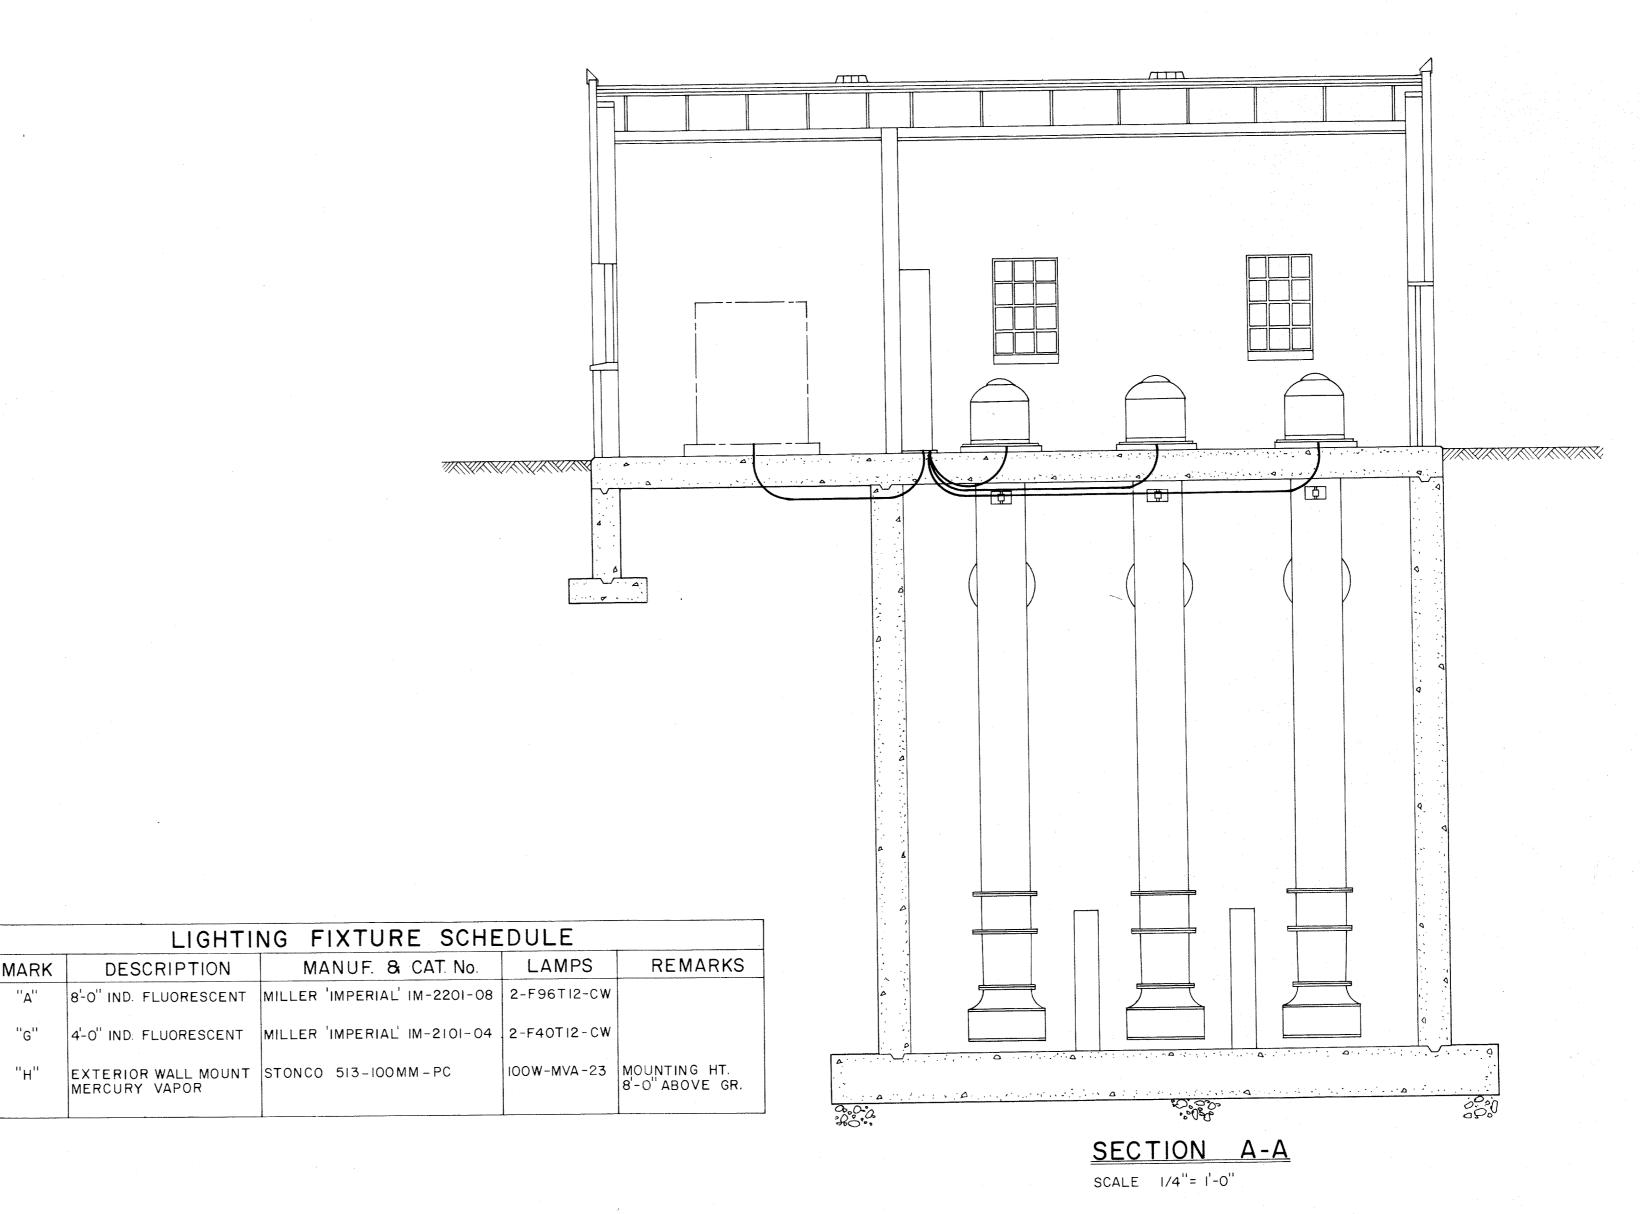


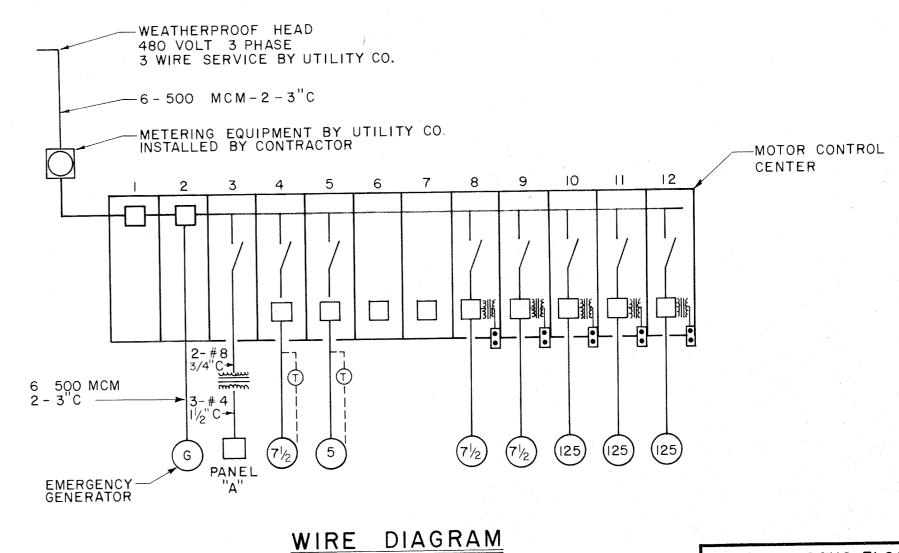

NOT TO SCALE


McKEES ROCKS FLOOD DISASTER PROJECT PA.R-441 BOROUGH OF McKEES ROCKS, ALLEGHENY COUNTY, PENNSYLVANIA REDEVELOPMENT AUTHORITY OF ALLEGHENY COUNTY
429 FORBES AVE, PITTSBURGH, PA.

> ELECTRICAL ROBB STREET PUMP STATION L. ROBERT KIMBALL

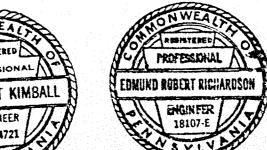

S.	ONWEAU
	PROFESSIONAL PROFESSIONAL
DMUK	D ROBERT RICHARDSON
	ENGINFER 18107-E
4	V3 YLY

CON EBENSBURG	SULTING E	NGINEERS PITTS NIA	BURGH
IWN BY TWL	DATE 11/22/77	PROJECT N	IUMBER
ECKED BY TMG	DATE 11/23/77	76 0212 00	06 03
	DATE 11/24/77	SCALE	SHEET
REFER		AS-NOTED	30 4

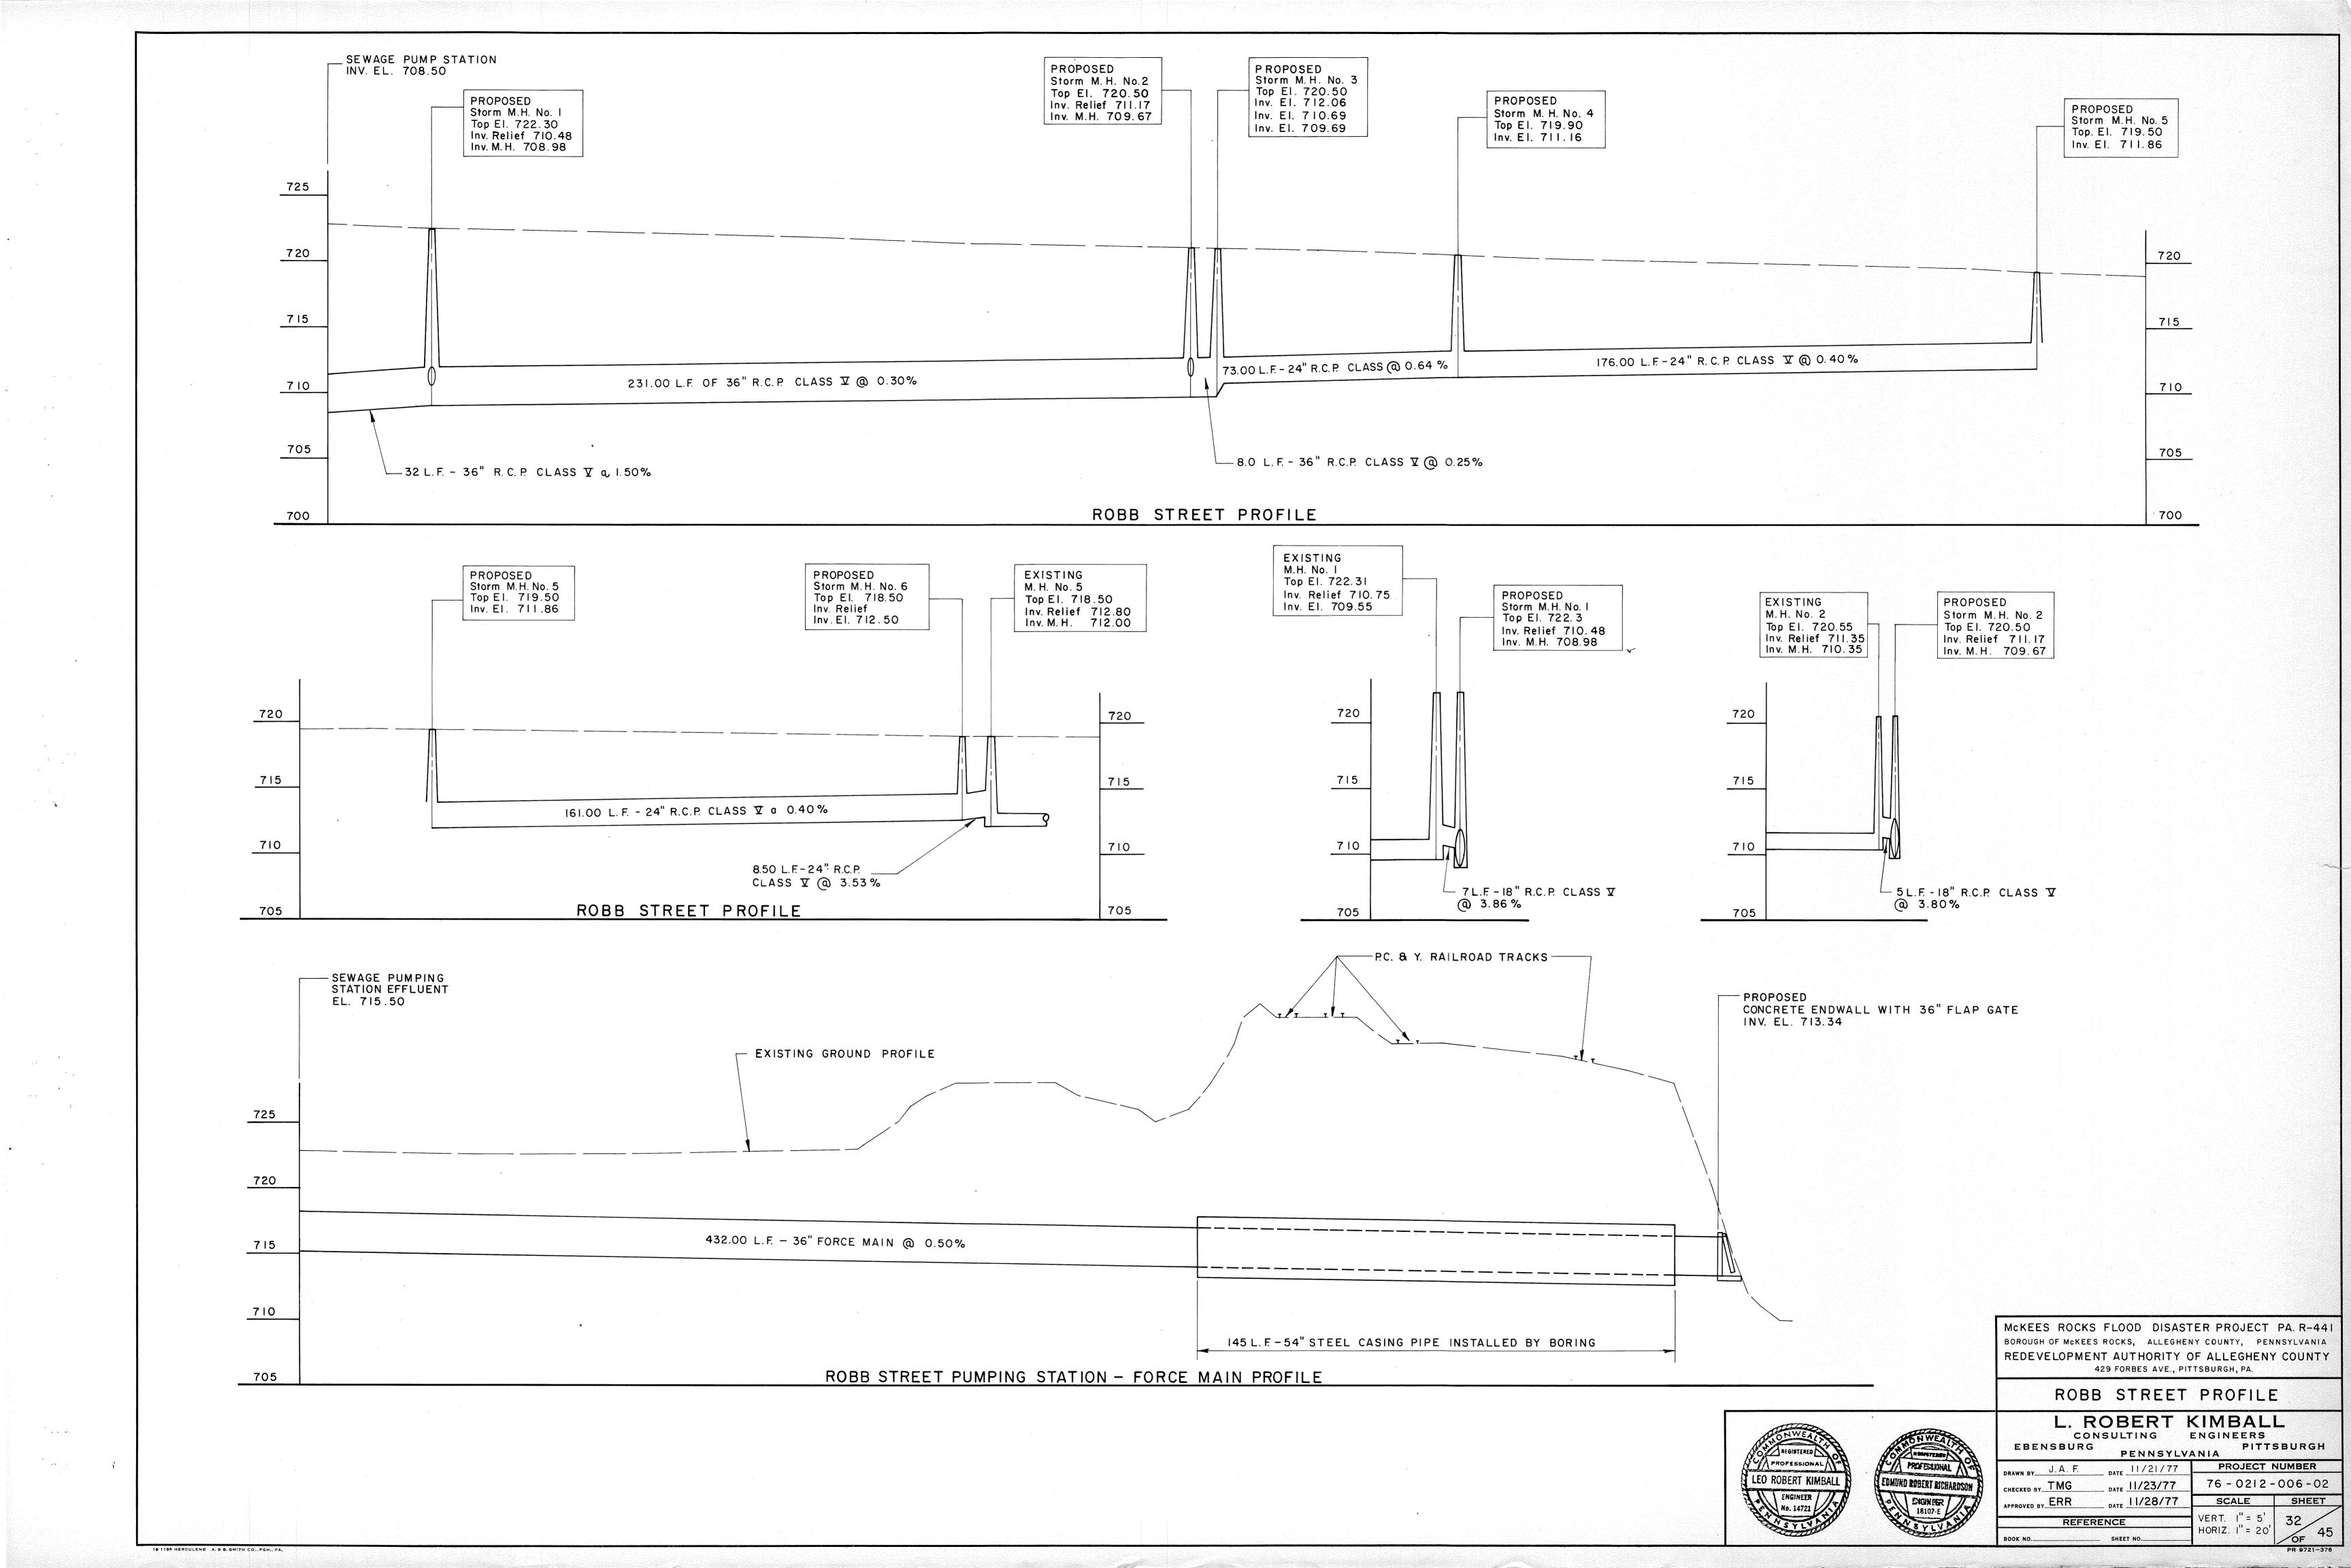

Attachment F - CONTRACT DRAWINGS

- Revised A58-ST-406 (Sheet 407 of 770)
- Revised AS1-CI-503 (Sheet 502 of 770)
- Revised AS1-CI-505 (Sheet 504 of 770)

A58-ST-407 PARTIAL-DEPTH PILES (ABOVE EX. SEWER) (ABOVE §) (8) (BELOW **§**) (12) $\sqrt{4(14)}$ PARTIAL-DEPTH PILES (ABOVE EX. SEWER) ZONE 1 ZONE 3 ZONE 2 PLAN @ EL. 708.0 (SEWER §) SUGGESTED CONSTRUCTION SEQUENCE STEP (SEE THIS SHEET AND

SUGGESTED CONSTRUCTION SEQUENCE

- I. THE CONSTRUCTION SEQUENCE DESCRIBED BELOW FOR THE SUPPORT OF EXCAVATION (SOE) SYSTEMS OF ORT-A58-RG1 IS SUGGESTED. THE CONTRACTOR MAY MODIFY THE SEQUENCES AS DEEMED NECESSARY, EXCEPT WHERE NOTED, TO ACCOMMODATE ACTUAL FIELD CONDITIONS AND ADOPTED MEANS AND METHODS. THE NOTED REQUIREMENTS HEREIN AND THOSE PERTAINING TO SOE INSTALLATIONS AND NEAR-SURFACE FACILITY CONSTRUCTION PROVIDED IN SPECIFICATION SECTIONS 31 41 16 AND 31 41 00, RESPECTIVELY. MUST BE COMPLIED WITH.
- II. PRIOR TO SOE INSTALLATIONS, THE CONTRACTOR SHALL HAVE COMPLETED THE FOLLOWING FIELD WORK:
- A. FIELD VERIFICATION OF EXISTING CONDITIONS AS SHOWN ON SHEET A58-CI-400.
- B. SITE PREPARATION AS REQUIRED FOR SOE INSTALLATION, INCLUDING PRE-DRILLING / BREAKUP OR REMOVAL OF THE EXISTING ABANDONED 36-INCH BRICK SEWER, AT THE CONTRACTOR'S CHOICE, AND REMOVAL OR RELOCATION OF THE EXISTING LATERAL TO THE EAST SIDE OF THE EXCAVATION.
- C. PREPARATION OF PUMPING EQUIPMENT TO MAINTAIN SUITABLE WORKING CONDITIONS WITHIN THE LIMITS OF EXCAVATION.
- D. INSPECT FLAP GATE AT A58 OUTFALL. THE CONTRACTOR SHALL PROVIDE AN INSPECTION PLAN AND REPAIR PLAN FOR THE OWNERS APPROVAL PRIOR TO INITIATING WORK.
- E. UNWATER THE A58 SEWER AFTER ANY REQUIRED REPAIR OF THE FLAP GATE AT THE A58 OUTFALL.
- III. OTHER REQUIREMENTS THAT MUST BE COMPLIED WITH DURING EXCAVATION ARE AS NOTED IN THE GENERAL SEQUENCE STEPS BELOW.


SEQUENCE STEPS:

- 1. COMPLETE INSPECTION OF EXISTING SEWER AND INSTALLATION OF SEWER INTERIOR LINING SUPPORT TO THE SPECIFIED EXTENT. SEE NOTE 4 ON SHEET A58-ST-400 FOR DETAILED REQUIREMENTS, INCLUDING MAINTENANCE OF
- 2. PREPARE AND CONSTRUCT THE SHEET PILES. NOTE THAT THE PARTIAL DEPTH SHEET PILES ABOVE THE EXISTING SEWER MUST BE INSTALLED ONLY AFTER THE FULL DEPTH PILES IMMEDIATELY NEXT TO THE SEWER ARE COMPLETED.
- 3. PERFORM GROUTING TO TREAT THE SPECIFIED SOIL ZONES TO THE MINIMUM LIMITS SHOWN.

NOTE THAT THE CONTRACTOR IS TO DETERMINE WHICH OF THE ABOVE TWO STEPS SHALL BE IMPLEMENTED FIRST, OR IF THEY NEED TO BE CONDUCTED IN AN ALTERNATING MANNER, DEPENDING ON THE ADOPTED GROUTING METHODOLOGY AND EQUIPMENT ACCESS CONDITIONS.

- 4. AFTER ALL SHEET PILES ARE COMPLETED AND THE GROUT CURED, EXCAVATE TO 2 FEET BELOW CENTERLINE OF BRACING LEVEL 1 AND INSTALL BRACING LEVEL 1.
- CONTINUE EXCAVATION TO 2 FEET BELOW THE SEWER SPRINGLINE ELEVATION. NOTE THAT TO PREVENT EXCESSIVE UNBALANCED LOADING ON THE EXISTING SEWER. EXCAVATE IN A STAGGERED MANNER ON EACH SIDE OF THE SEWER AND KEEP THE EXCAVATED ELEVATION DIFFERENTIAL NO MORE THAN 3 FEET BETWEEN THE TWO SIDES. INSTALL LAGGING TO BRACE THE UNSUPPORTED CLEARANCE ZONES BETWEEN THE SEWER AND THE ADJACENT SHEET PILES.
- PERFORM EXTERIOR REPAIR AROUND THE EXPOSED SEWER TO SECURE ANY LOOSE BRICKS AND MATERIALS, FILL VOIDS AND GAPS TO PREVENT UNRAVELLING OF THE BRICKS WITHIN A MINIMUM OF 4 FEET FROM THE INSIDE FACE OF SOE END WALL. THE METHOD OF REPAIR SHALL BE THE RESPONSIBILITY OF THE CONTRACTOR AND MAY INCLUDE BRICK REPOINTING, PATCHING, STRAPPING, OR EQUIVALENT.
- POWER WASH THE SOE END WALL AND CONSTRUCT TOP PORTION OF THE RC COLLAR ABOVE THE EXCAVATED ELEVATION AS SHOWN. NOTE THAT VERTICAL REBARS MUST BE EXTENDED WITH THE REQUIRED LAPPING LENGTH, AND THE RC COLLAR MUST BE ANCHORED TO THE FULL DEPTH PILES ON EITHER SIDE OF SEWER USING THE MINIMUM NUMBER OF EQUALLY SPACED NELSON STUDS OR EQUIVALENT, AS SHOWN ON SHEET A58-ST-402.

(CONSTRUCTION SEQUENCE CONTINUES ON SHEET A58-ST-407)

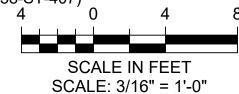

REVISION Designed by: APPV REV No. DATE DESCRIPTION Dial 8-1-1 or 1-800-242-1776 not less ZC 12/23/25 **REVISION FOR ADDENDUM 11** than 3 business days nor more than Two Allegheny Center Nova Tower 2, Suite 1301 Pittsburgh, PA 15212 Drawn by: 10 business days prior to the start of alcosan allogheny county sanitary authority BJD \ \ ENGINEER , (412) 497 - 2900 MOTT nsylvania One Call System Serial Number Checked by: FINAL DESIGN TICKET # 20250040204

MACDONALD

LEGEND

GROUTED ZONE

SUGGESTED SPLICE LOCATION - ALL LEVELS (SEE SHEET ORT-MD-013 FOR

A58-ST-407)

DETAILS)



ARLETTA SCOTT WILLIAMS EXECUTIVE DIRECTOR, ALCOSAN

www.alcosan.org


3300 PREBLE AVE. PITTSBURGH, PA 15233 (412) 766 - 4810


A58-ST-406 **ORT-A58-RG1 CONSTRUCTION SEQUENCING** SHEET 1 OF 3

OHIO RIVER TUNNEL (ORT)

Contract: ALLEGHENY COUNTY SANITARY AUTHORITY (ALCOSAN) A58-ST-406.dwg 07/30/2025


407 OF 770

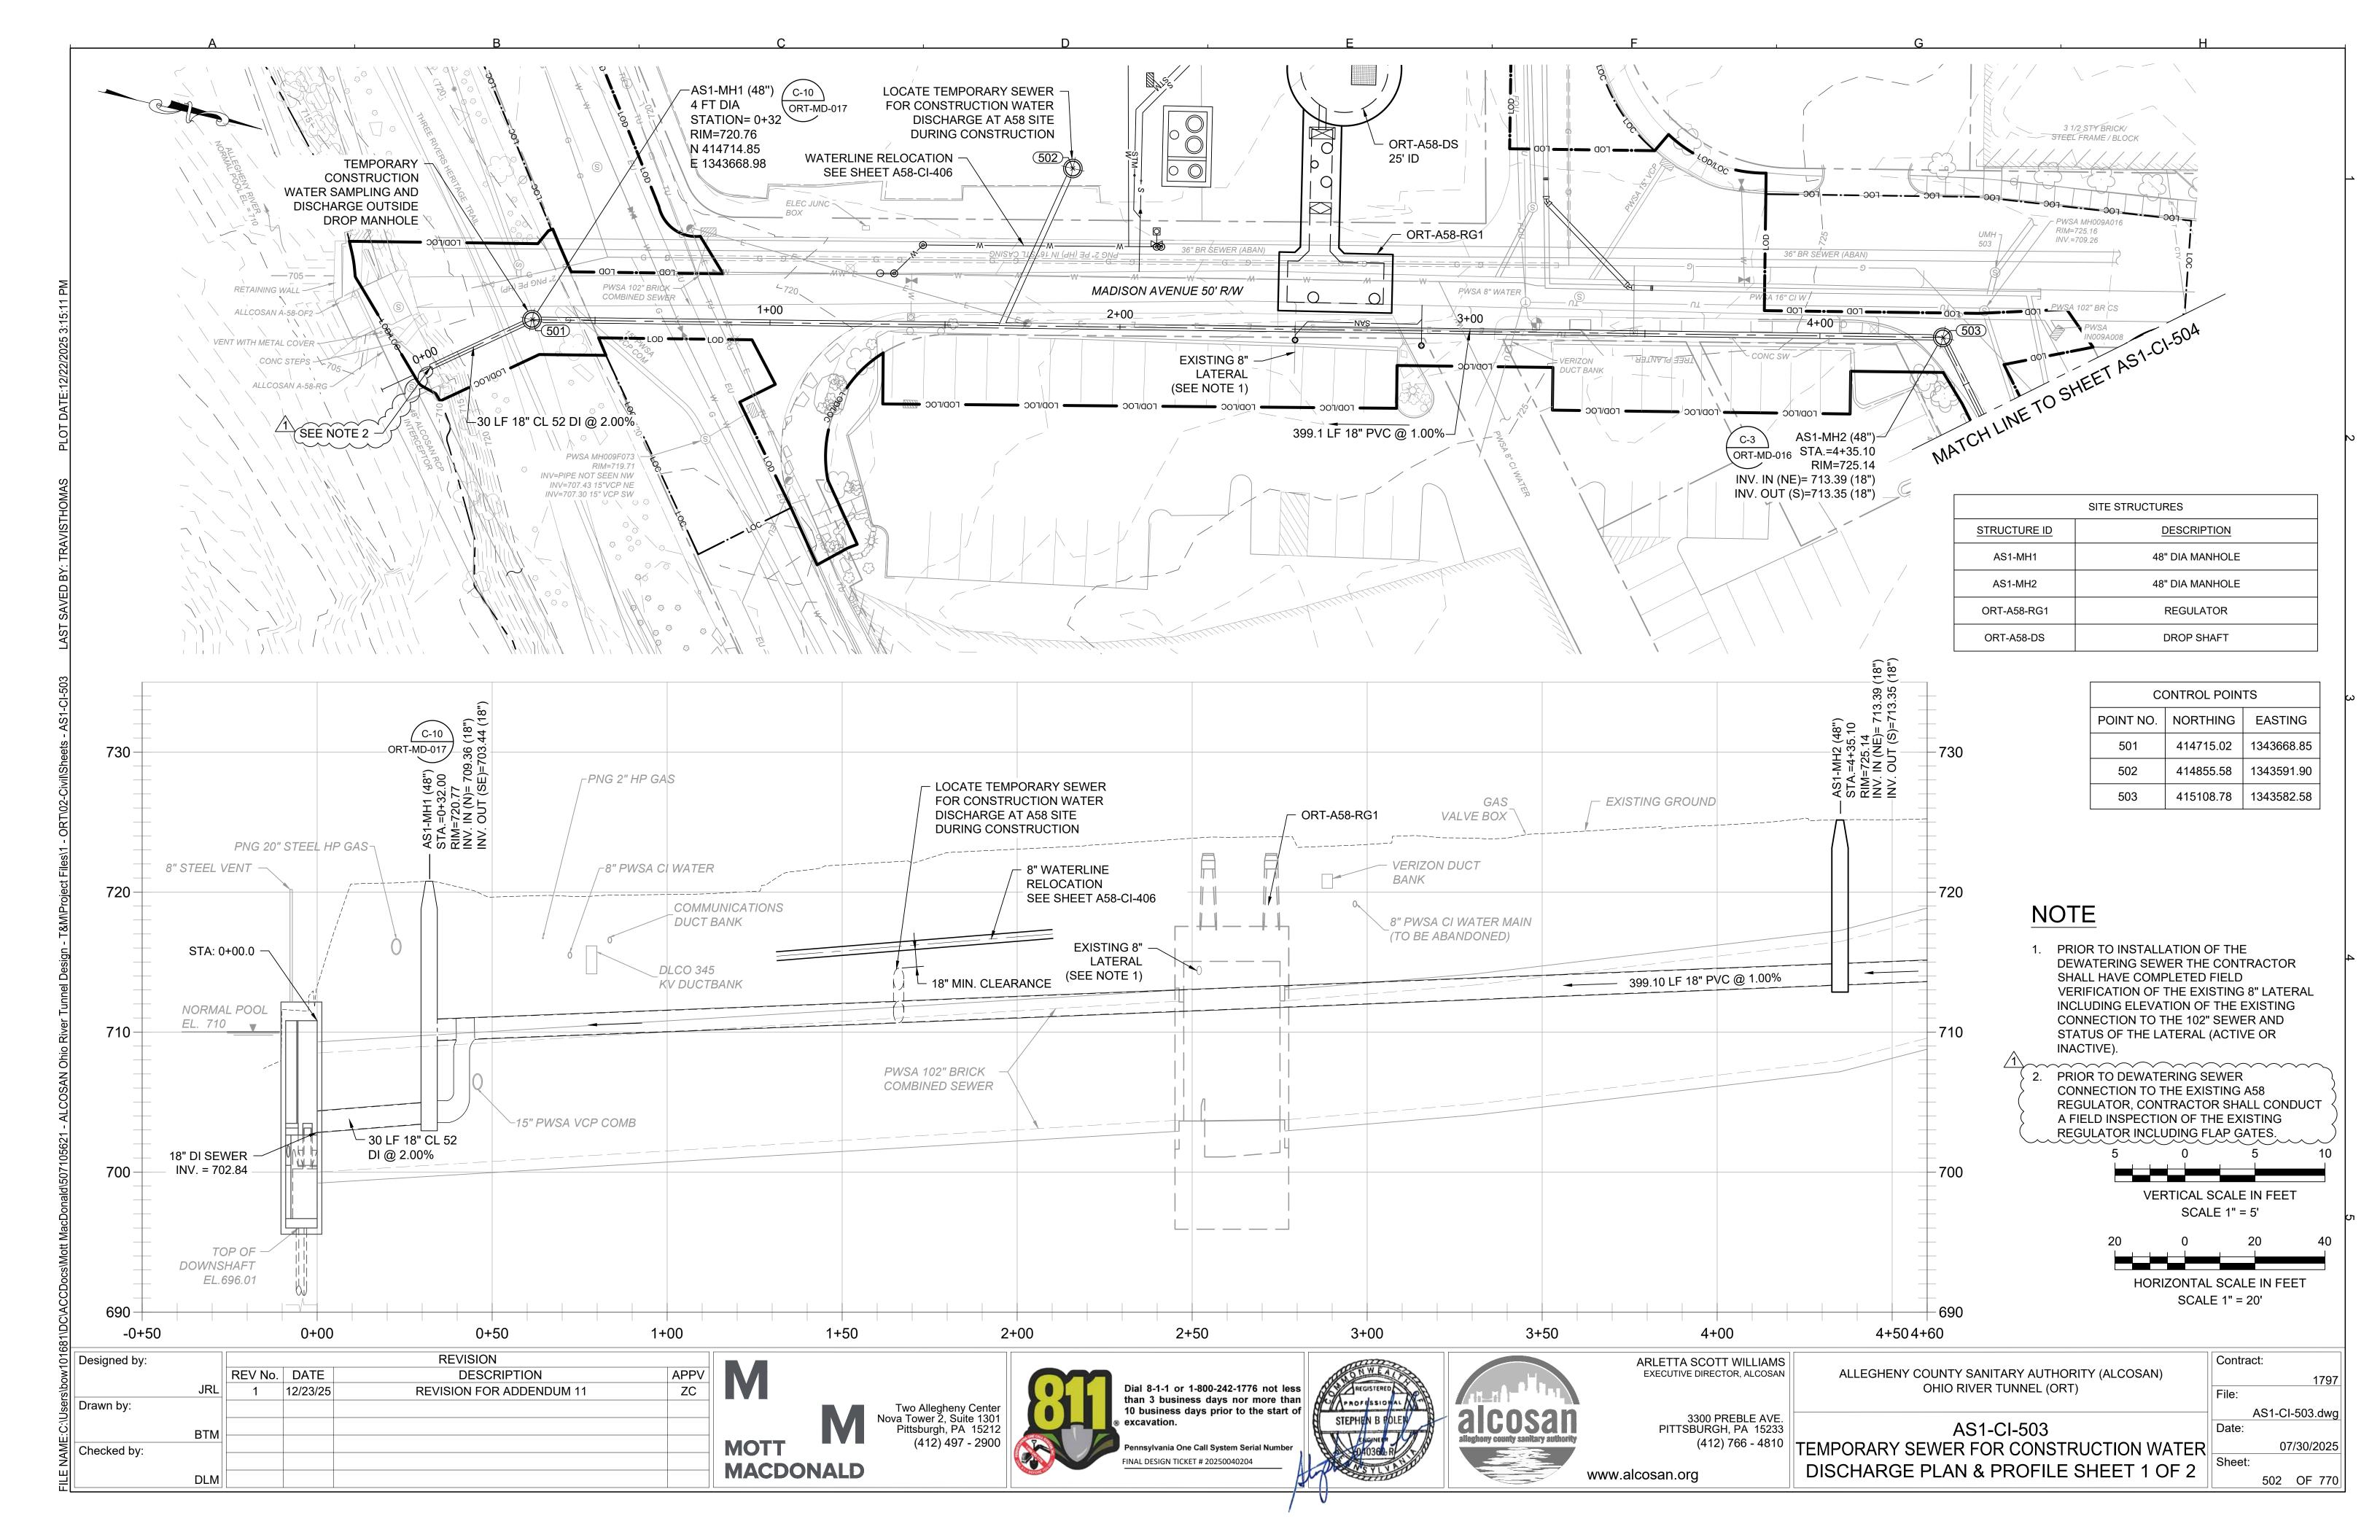

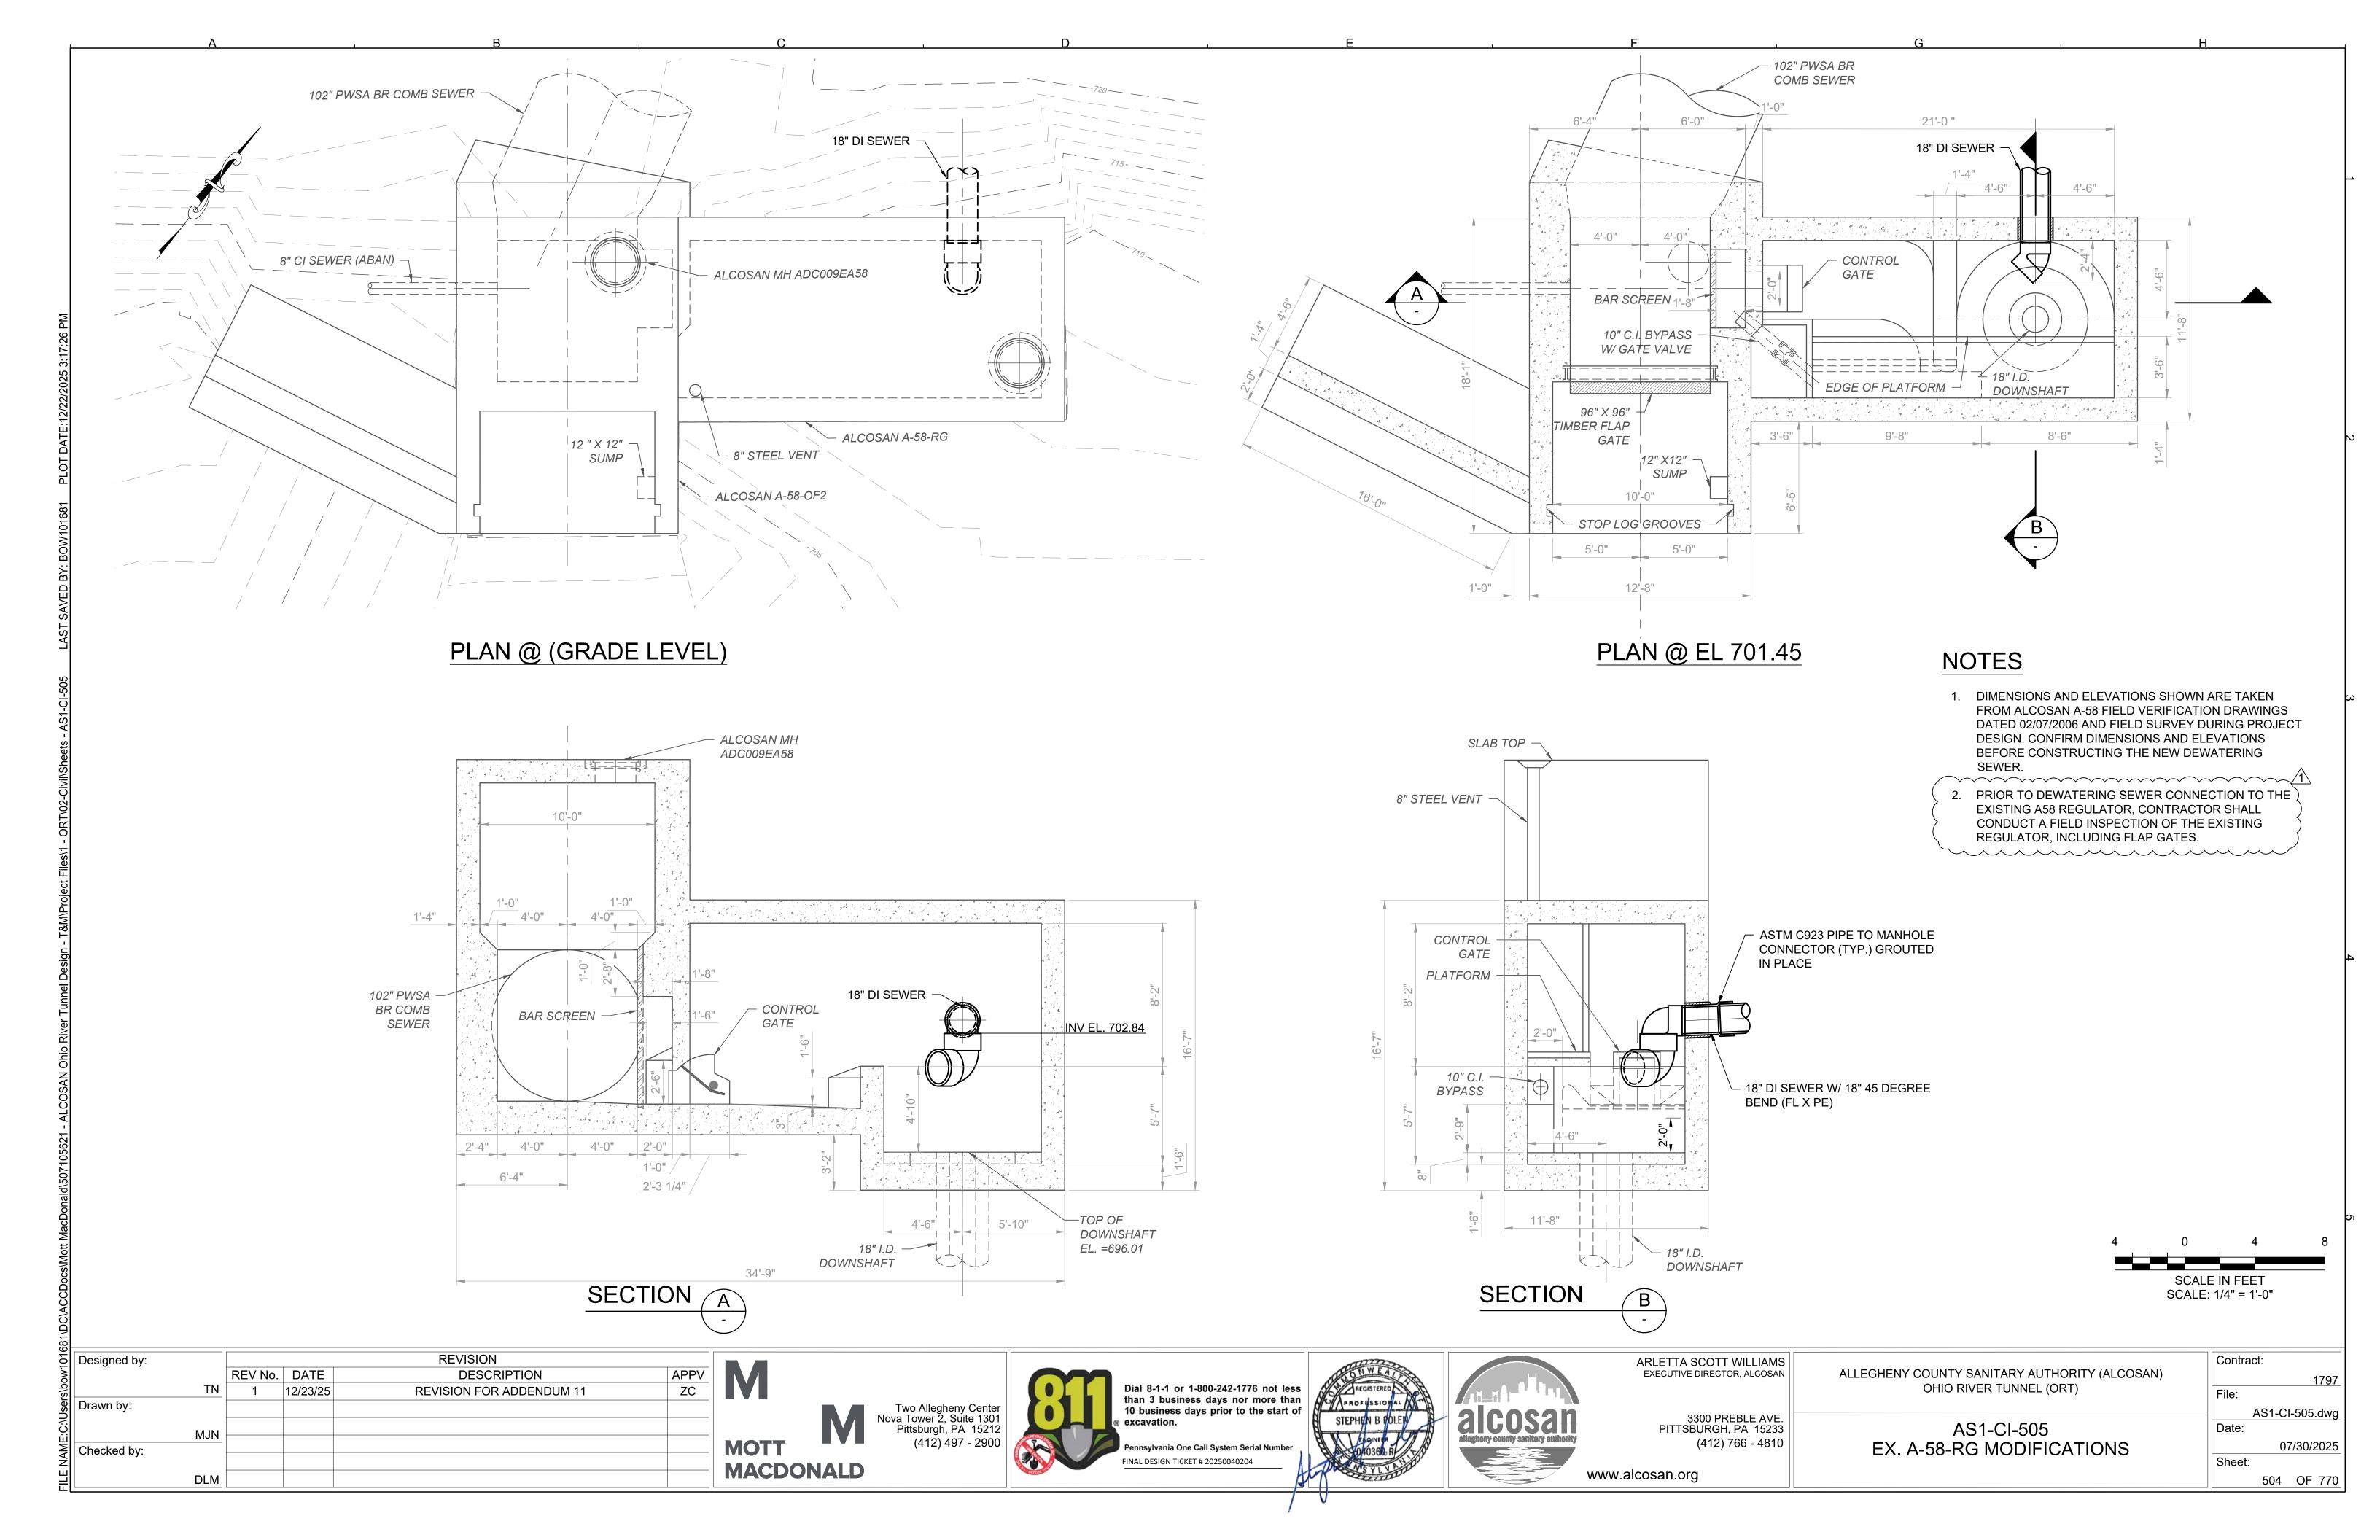


Attachment G – CONTRACT DRAWINGS


• Revised O07-ST-701 (Sheet 590 of 770)

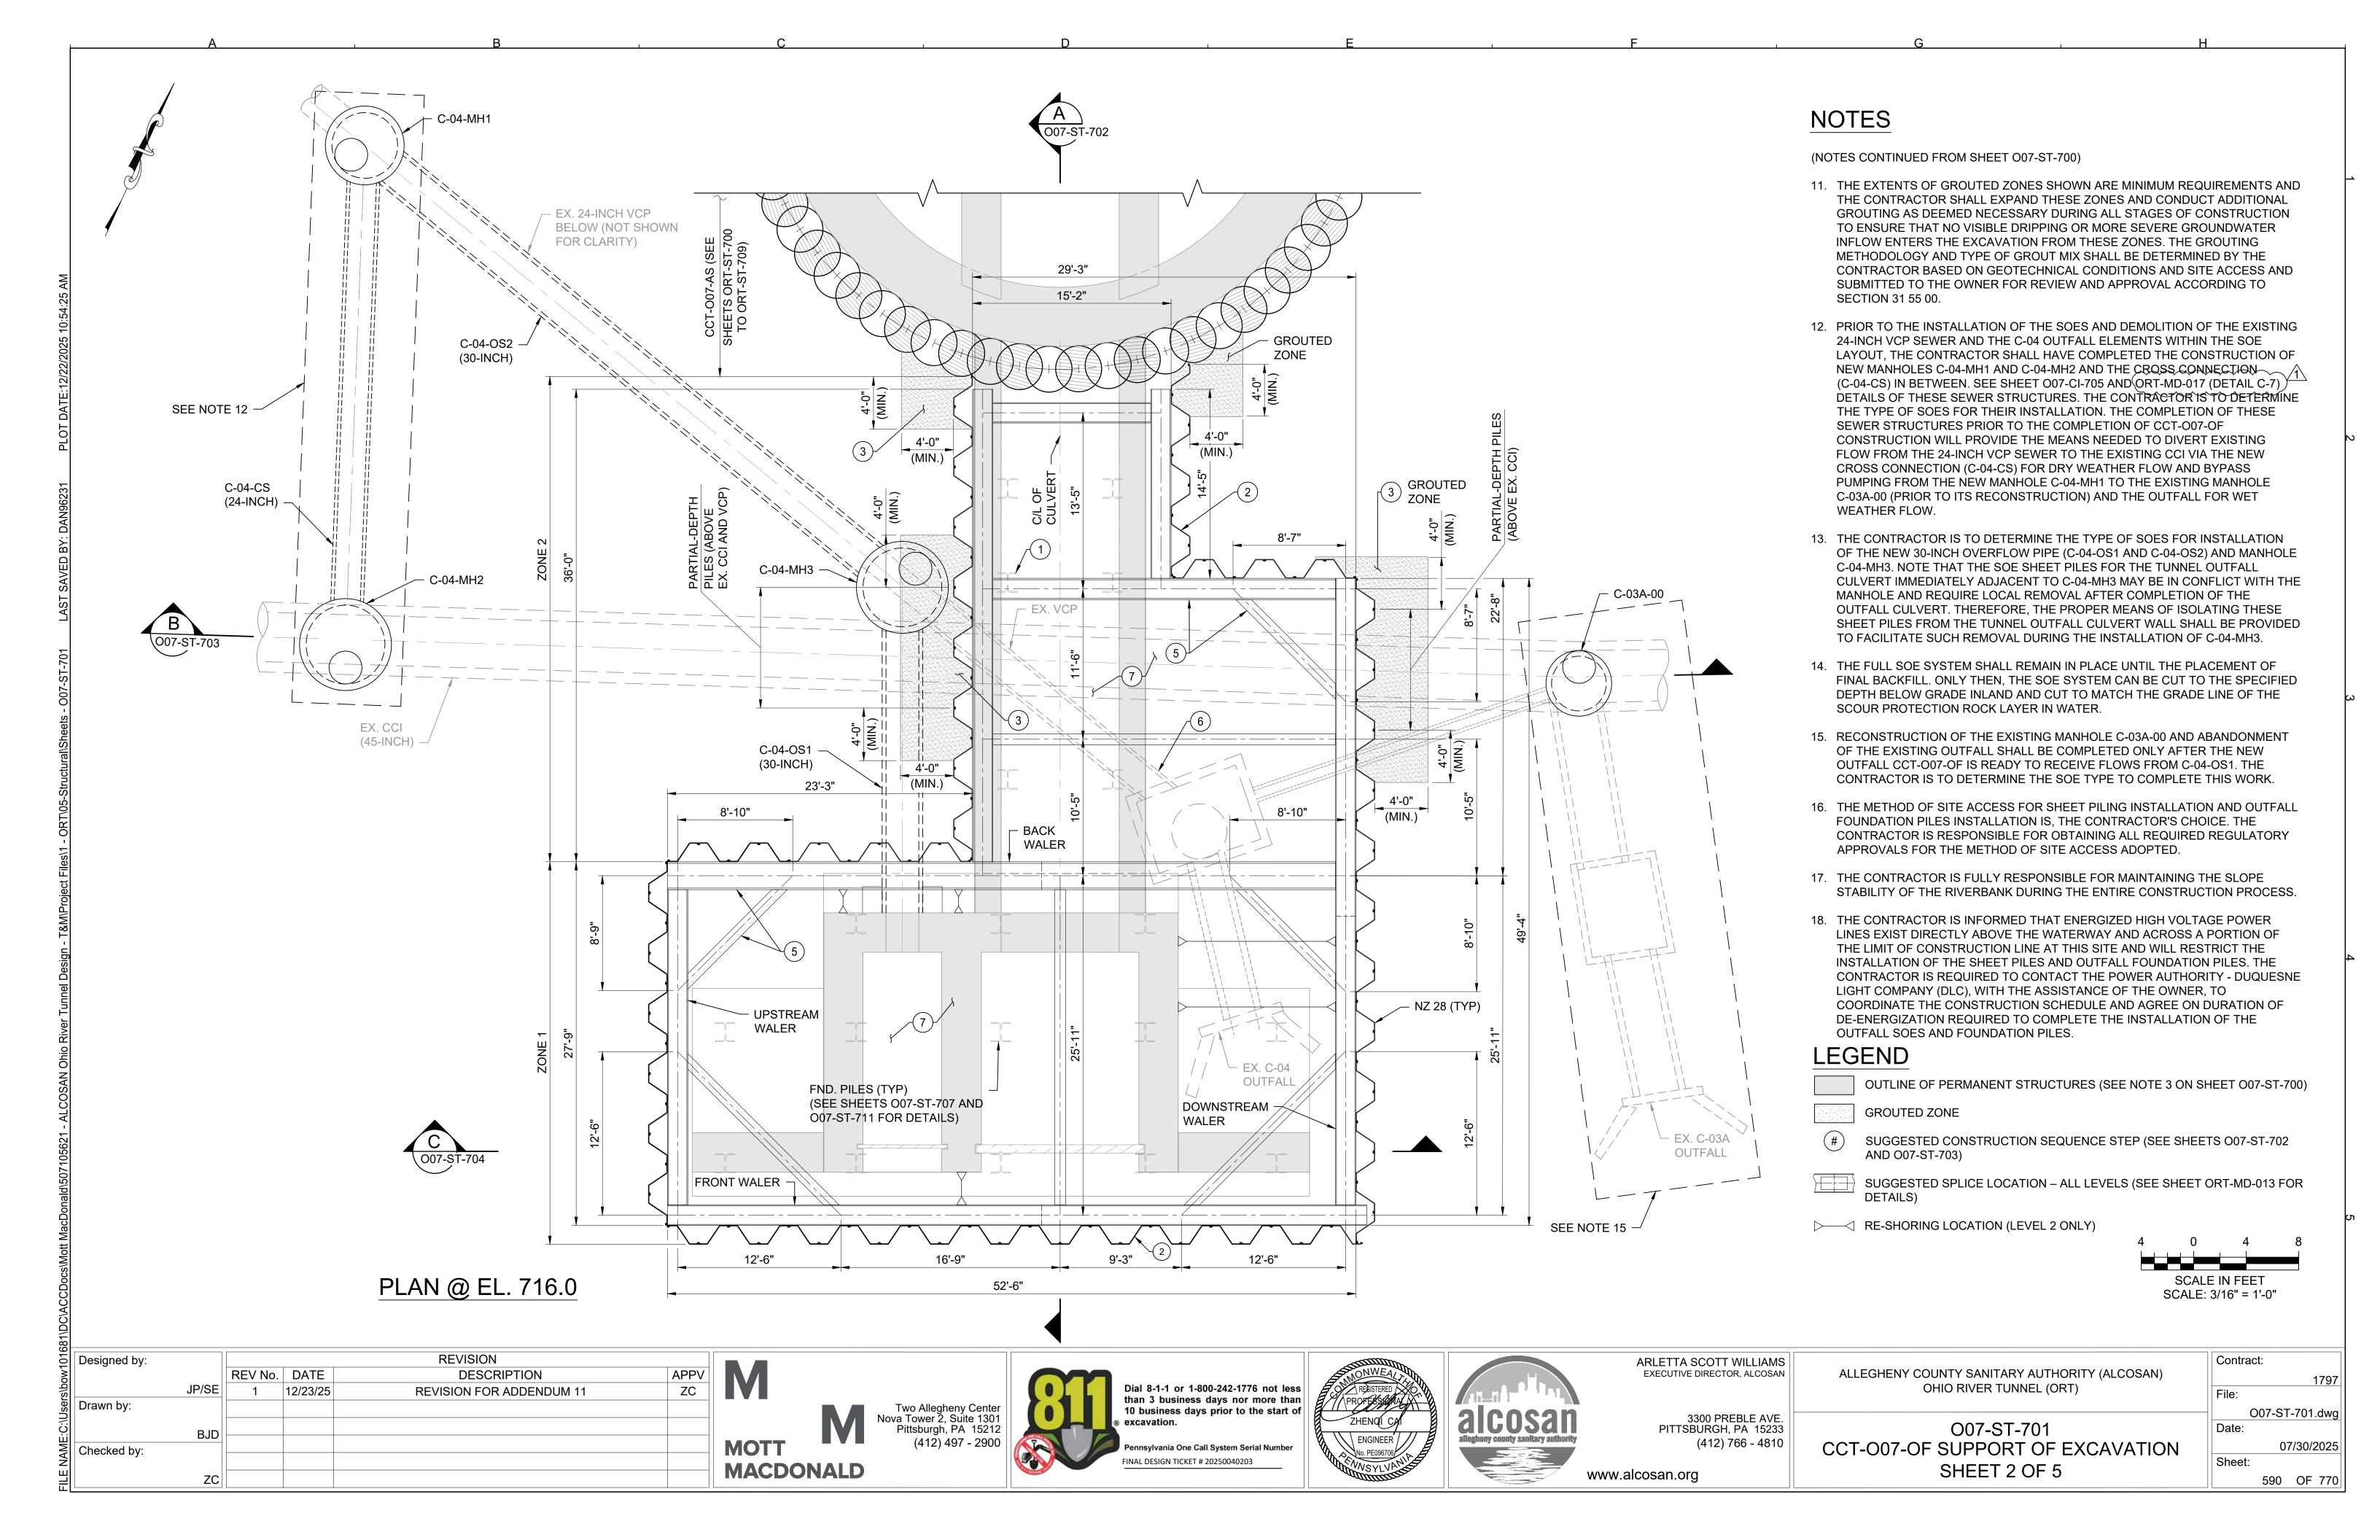

Attachment H – CONTRACT DRAWINGS

- Revised ORT-ST-103 (Sheet 103 of 770)
- Revised ORT-ST-500 (Sheet 152 of 770)

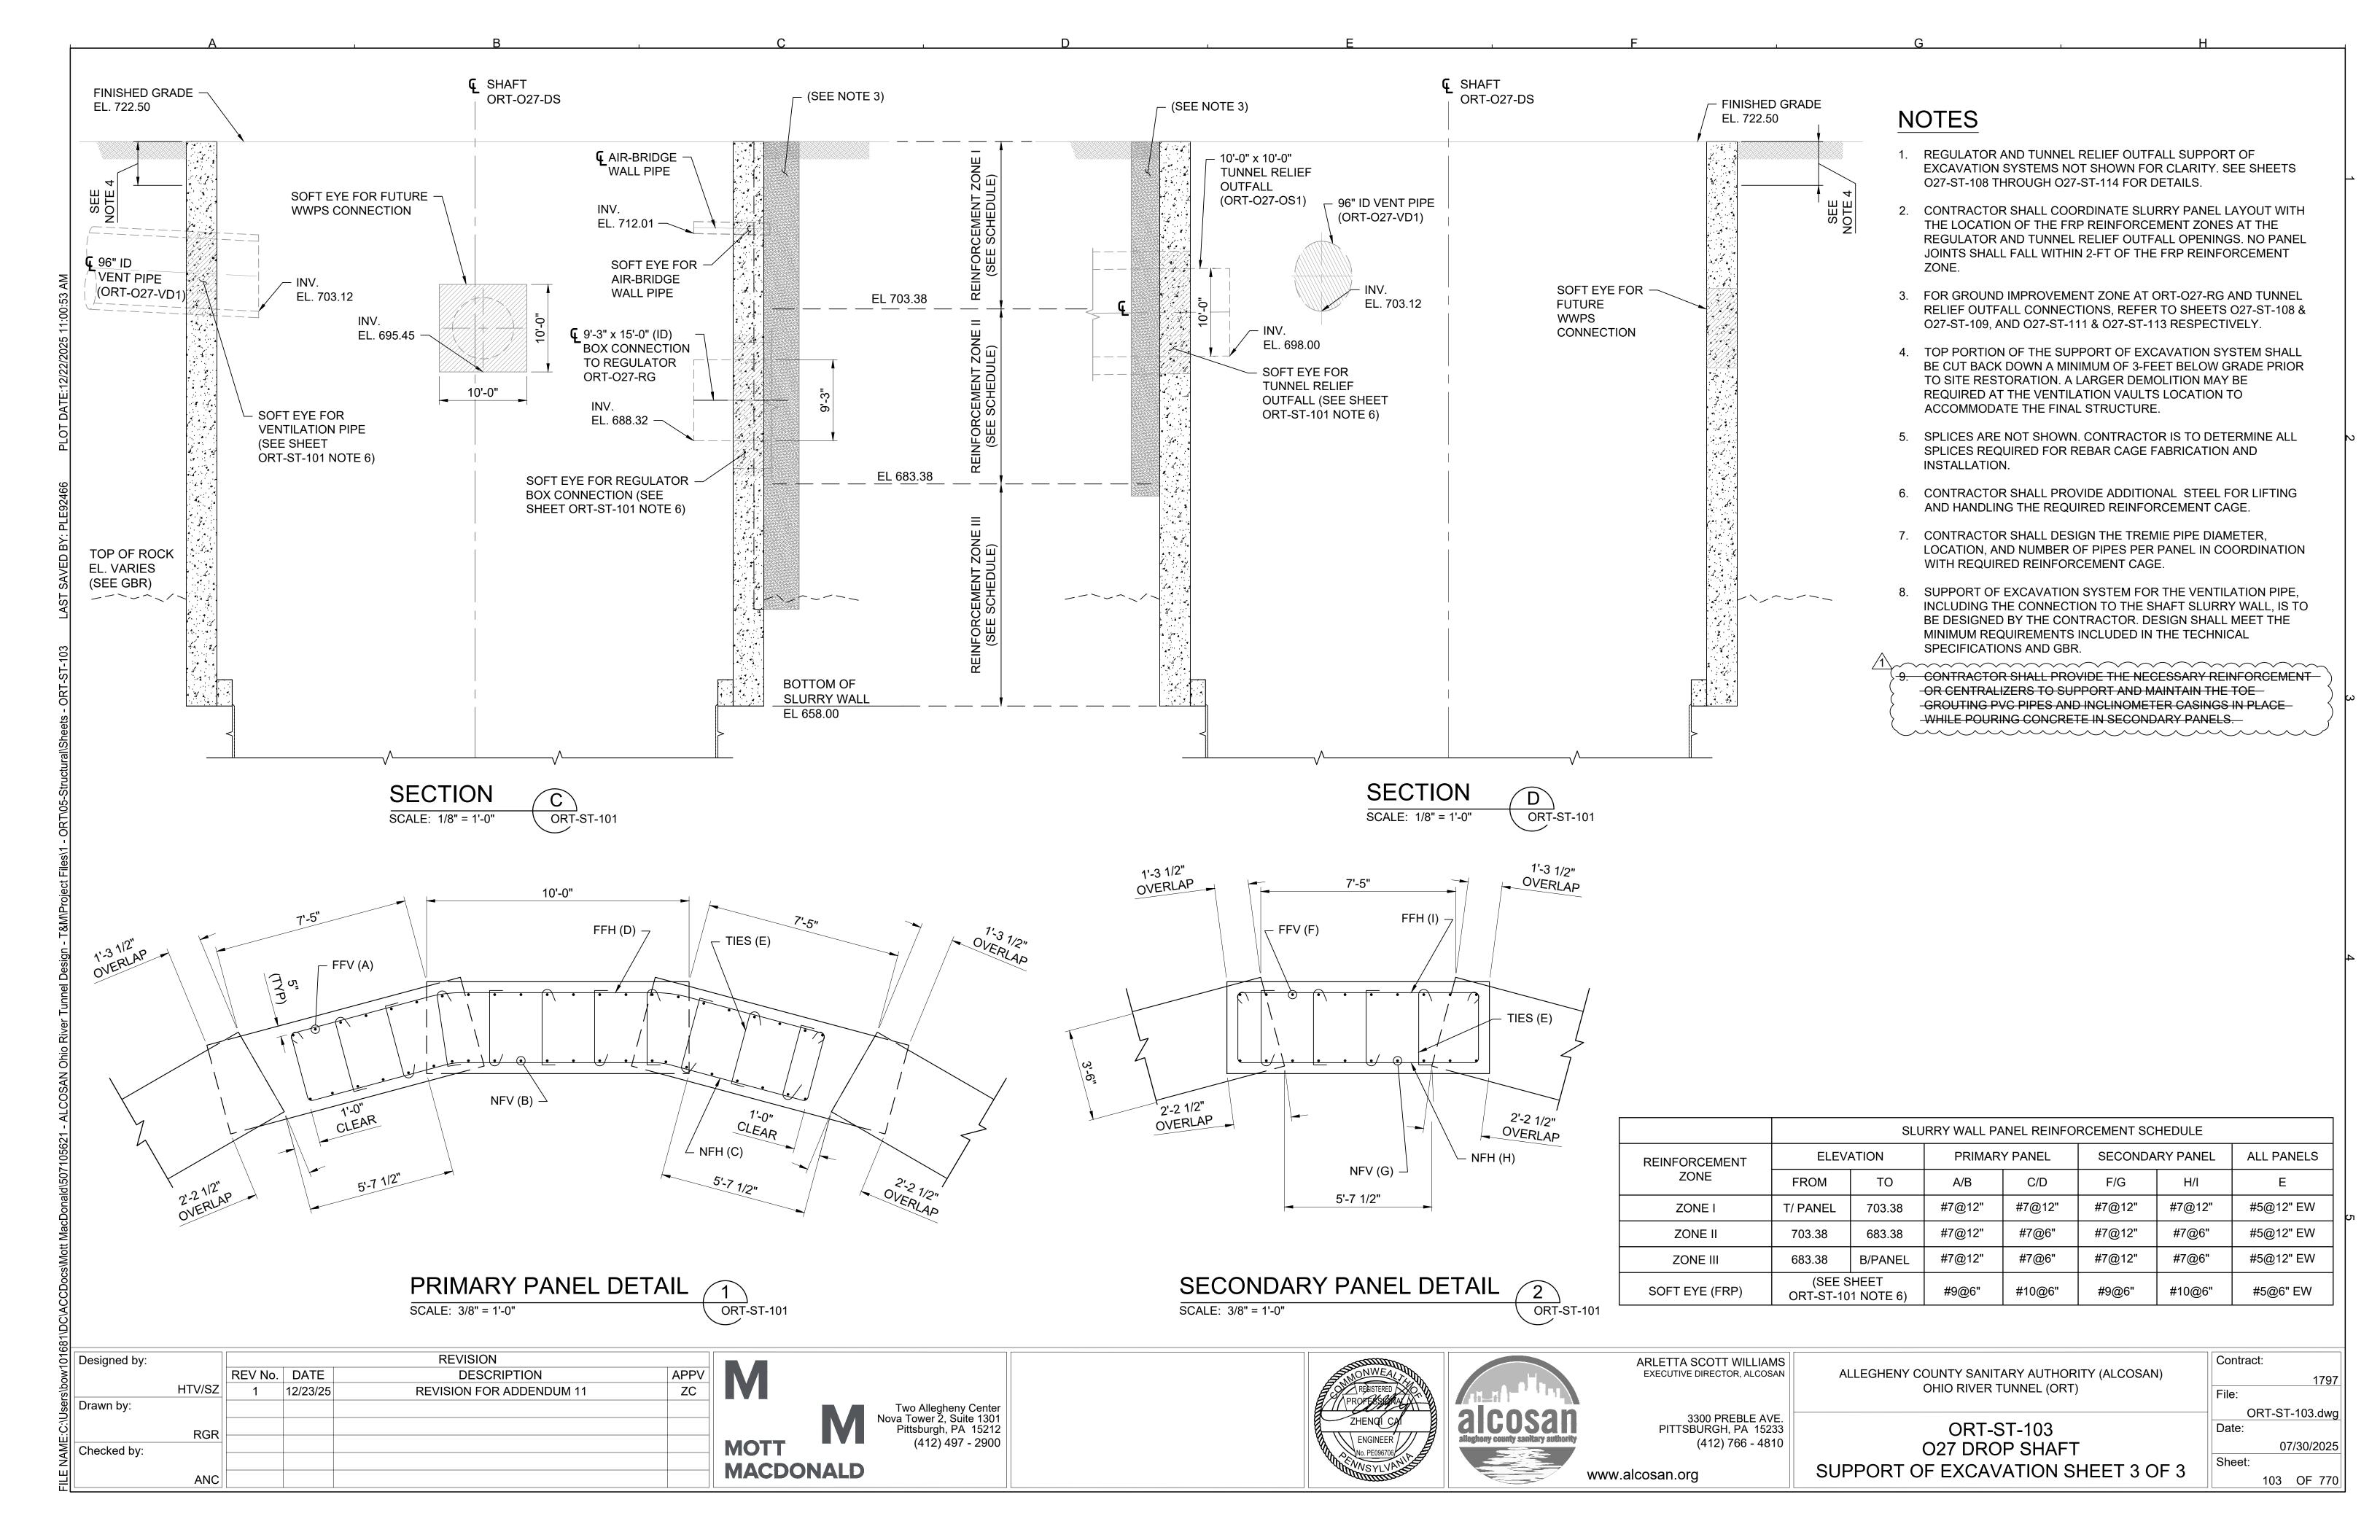

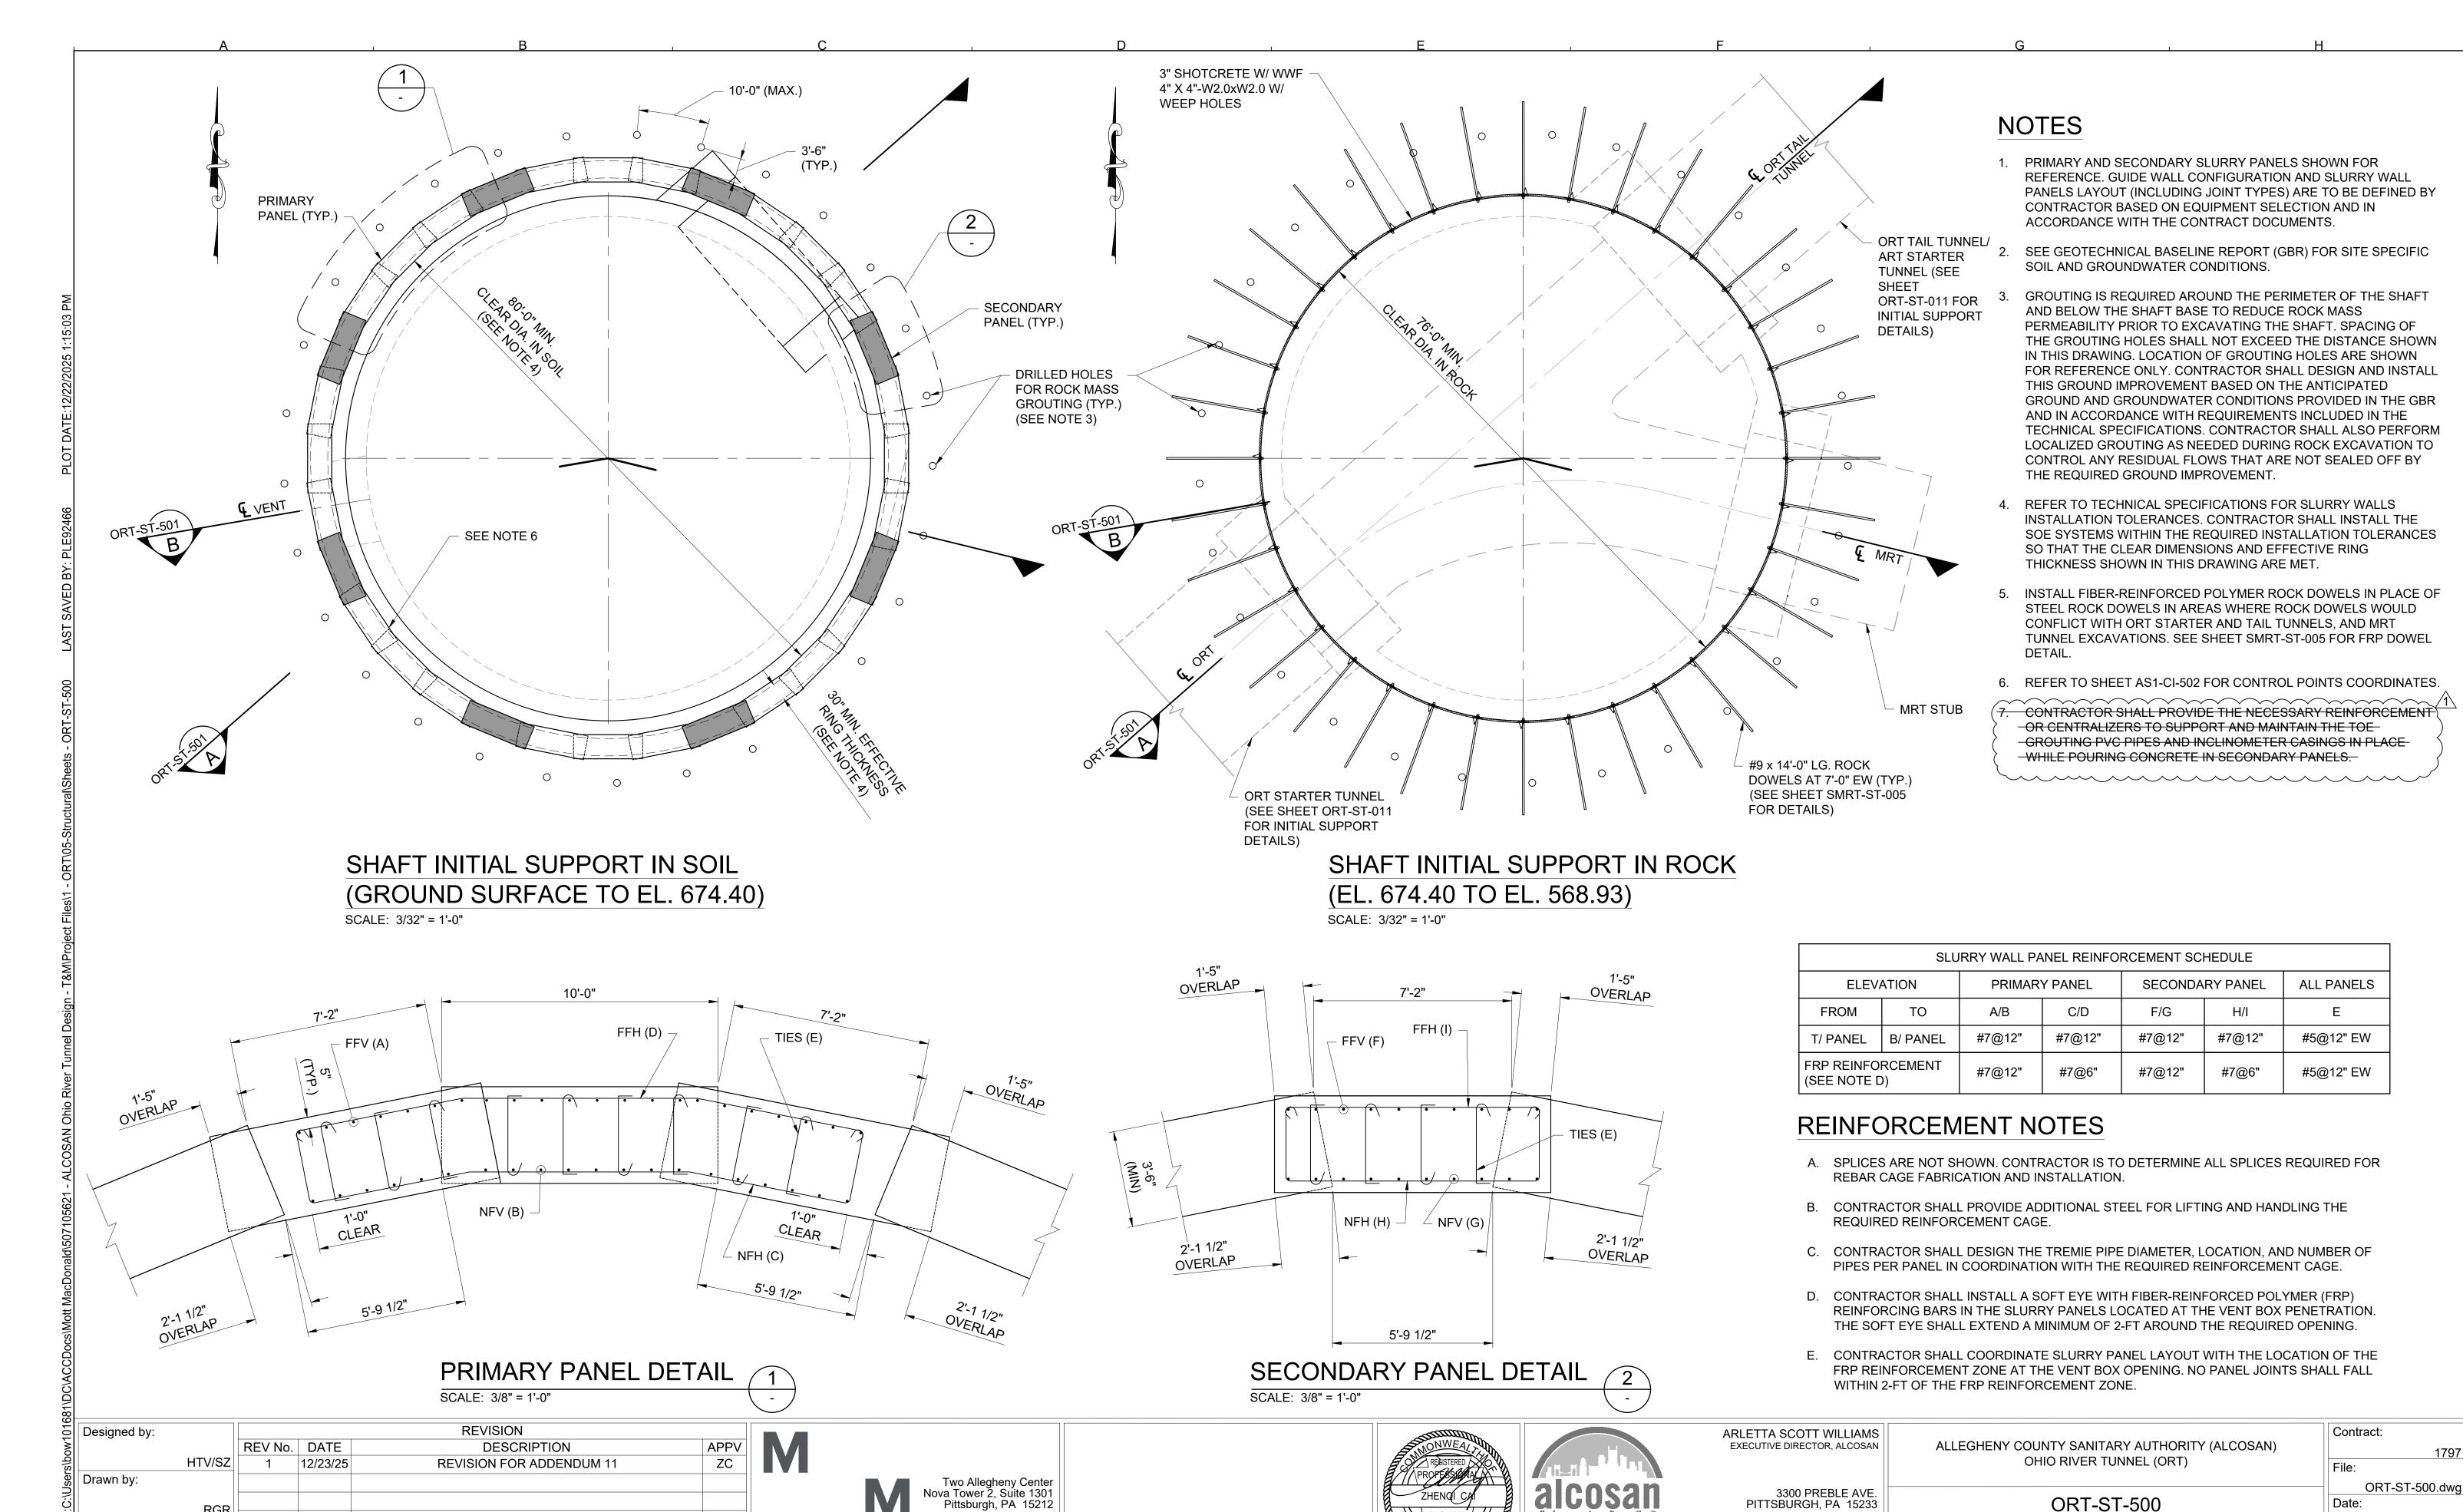

(412) 497 - 2900

MOTT

MACDONALD

RGR

ANC

Checked by:

ORT-ST-500

AS1 ACCESS SHAFT

SUPPORT OF EXCAVATION - SHEET 1 OF 2

07/30/2025

152 OF 770


Sheet:


(412) 766 - 4810

www.alcosan.org

Attachment I – CONTRACT DRAWINGS

- Revised ORT-ST-200 (Sheet 117 of 770)
- Revised ORT-ST-300 (Sheet 130 of 770)
- Revised ORT-ST-400 (Sheet 141 of 770)
- Revised ORT-ST-600 (Sheet 159 of 770)
- Revised ORT-ST-700 (Sheet 169 of 770)
- Revised ORT-ST-800 (Sheet 179 of 770)

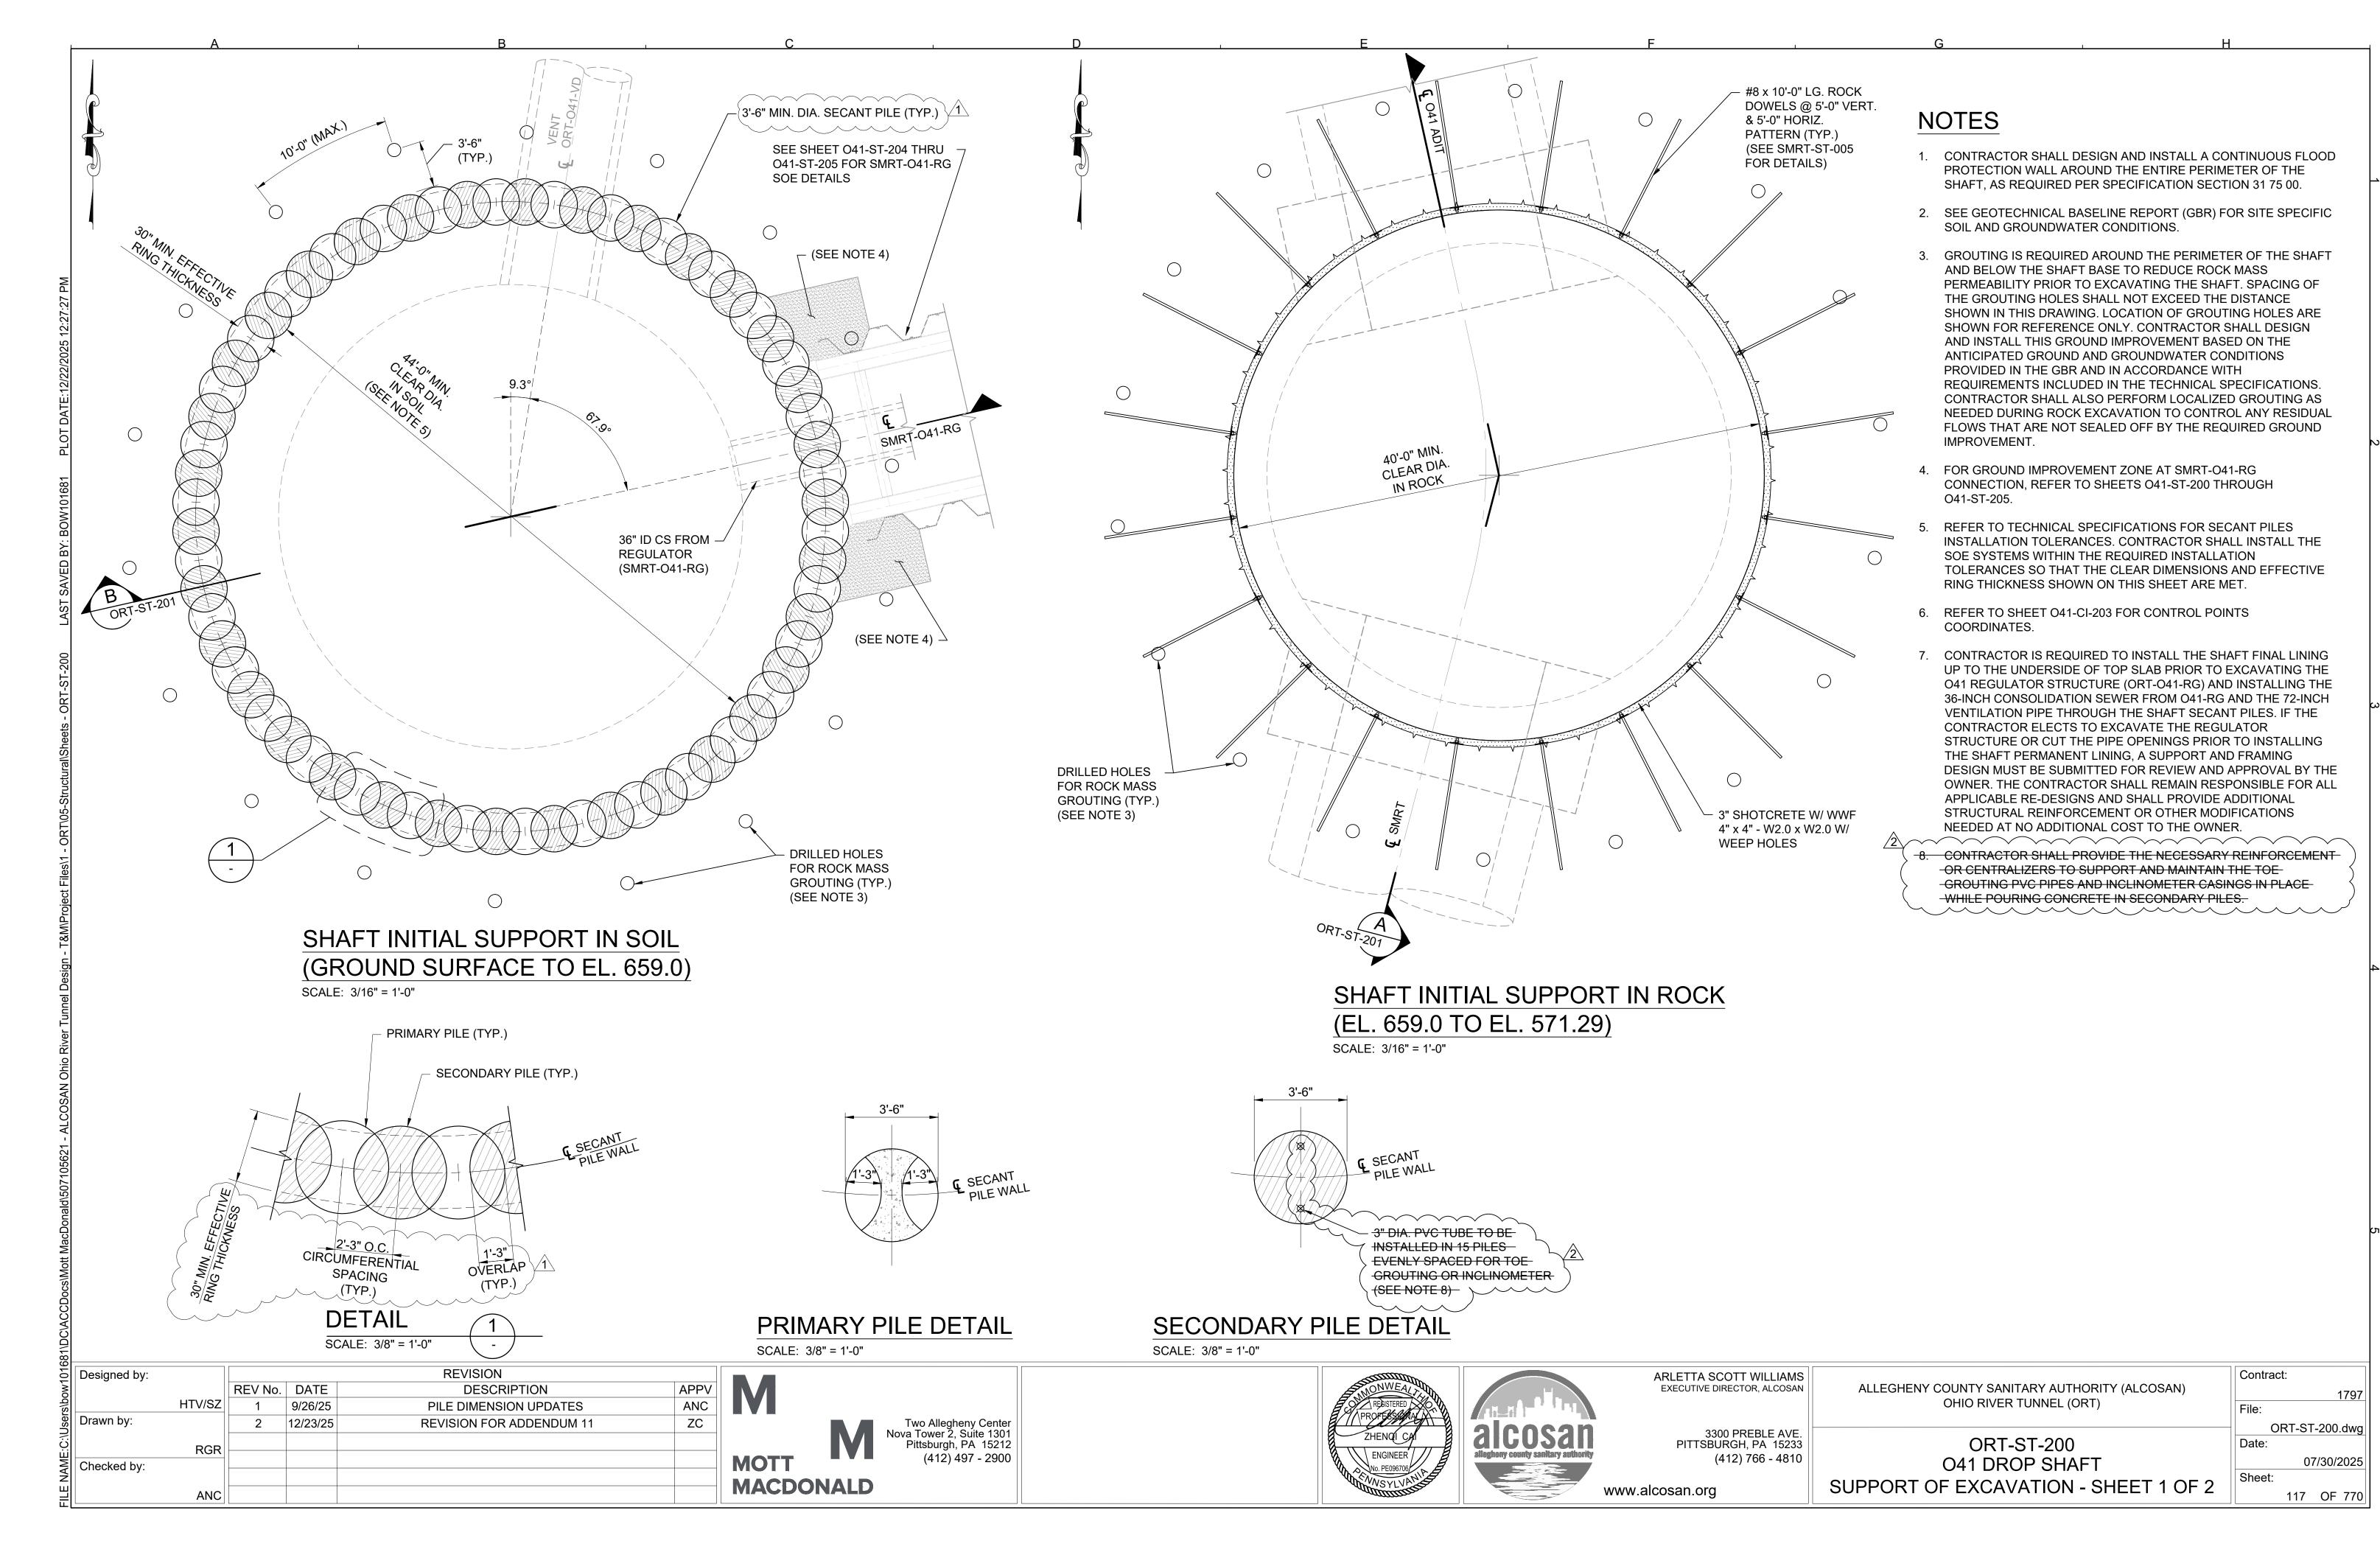

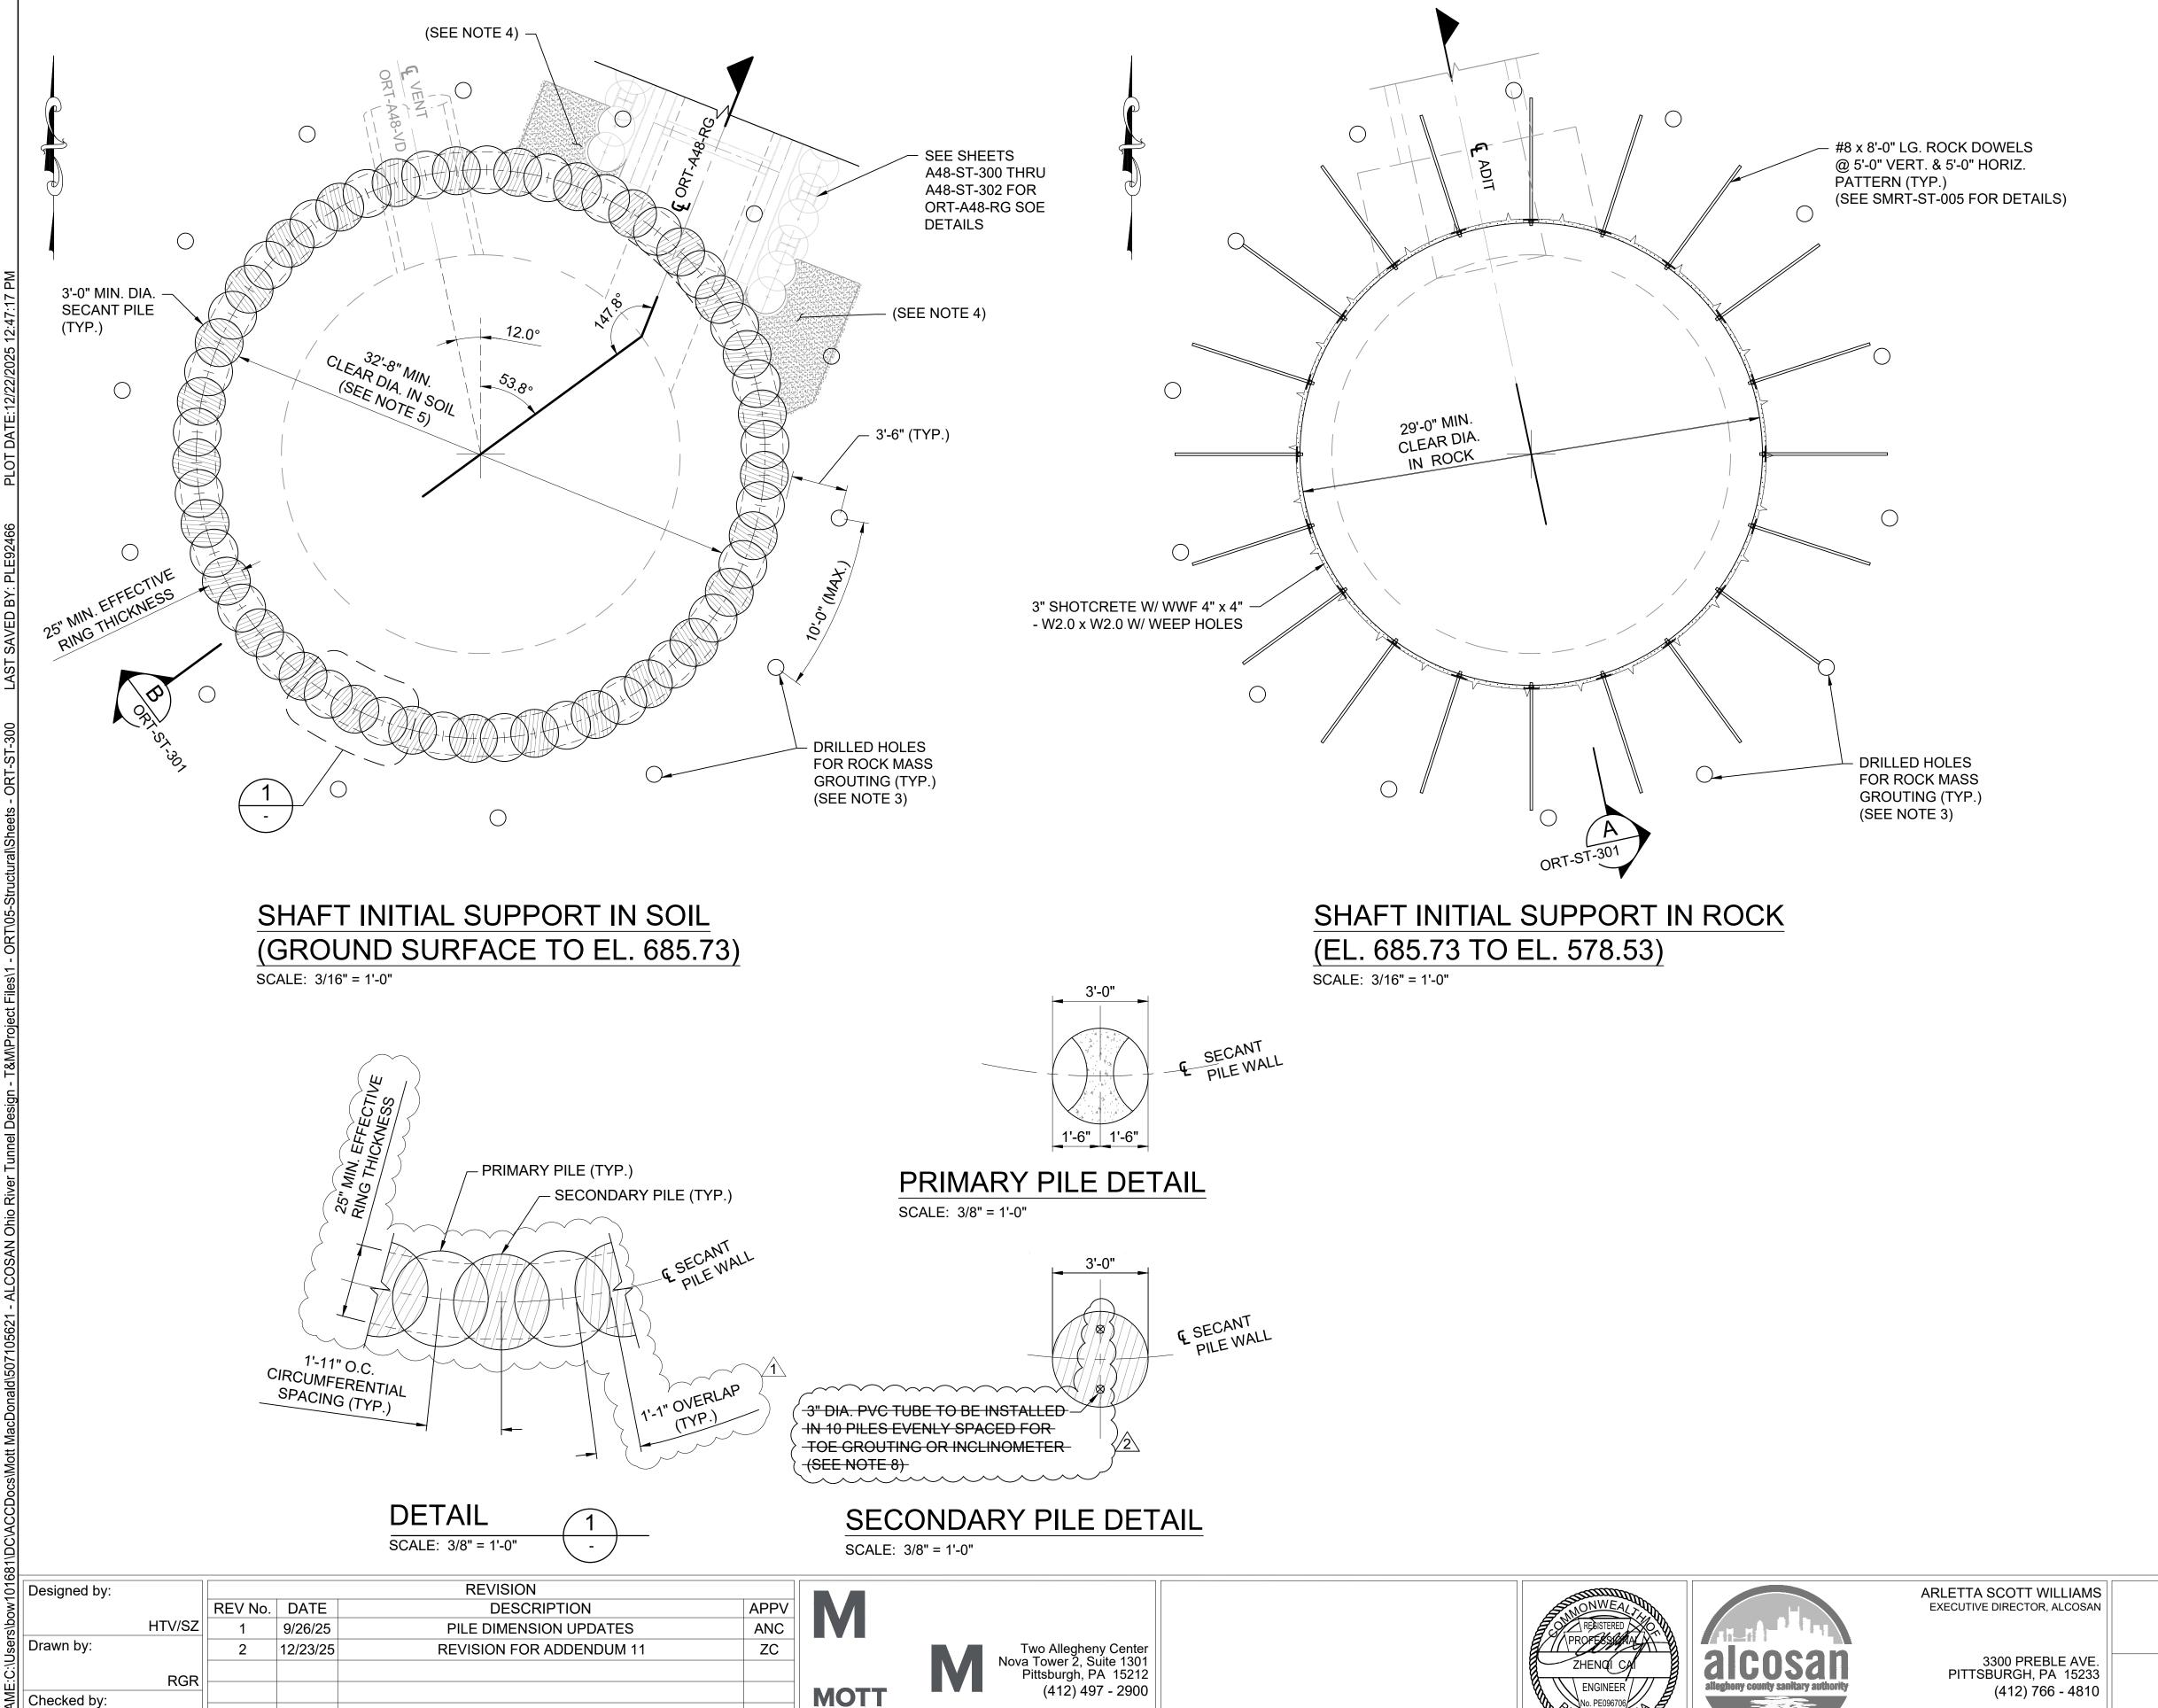

MACDONALD

ANC

NOTES

- 1. CONTRACTOR SHALL DESIGN AND INSTALL A CONTINUOUS FLOOD PROTECTION WALL AROUND THE ENTIRE PERIMETER OF THE SHAFT, AS REQUIRED PER SPECIFICATION SECTION 31 75
- 2. SEE GEOTECHNICAL BASELINE REPORT (GBR) FOR SITE SPECIFIC SOIL AND GROUNDWATER CONDITIONS.
- S. GROUTING IS REQUIRED AROUND THE PERIMETER OF THE SHAFT AND BELOW THE SHAFT BASE TO REDUCE ROCK MASS PERMEABILITY PRIOR TO EXCAVATING THE SHAFT. SPACING OF THE GROUTING HOLES SHALL NOT EXCEED THE DISTANCE SHOWN IN THIS DRAWING. LOCATION OF GROUTING HOLES ARE SHOWN FOR REFERENCE ONLY. CONTRACTOR SHALL DESIGN AND INSTALL THIS GROUND IMPROVEMENT BASED ON THE ANTICIPATED GROUND AND GROUNDWATER CONDITIONS PROVIDED IN THE GBR AND IN ACCORDANCE WITH REQUIREMENTS INCLUDED IN THE TECHNICAL SPECIFICATIONS. CONTRACTOR SHALL ALSO PERFORM LOCALIZED GROUTING AS NEEDED DURING ROCK EXCAVATION TO CONTROL ANY RESIDUAL FLOWS THAT ARE NOT SEALED OFF BY THE REQUIRED GROUND IMPROVEMENT.
- 4. FOR GROUND IMPROVEMENT ZONE AT ORT-A48-RG CONNECTION, REFER TO SHEETS A48-ST-300 THROUGH A48-ST-305.
- 5. REFER TO TECHNICAL SPECIFICATIONS FOR SECANT PILES WALLS INSTALLATION TOLERANCES. CONTRACTOR SHALL INSTALL THE SOE SYSTEMS WITHIN THE REQUIRED INSTALLATION TOLERANCES SO THAT THE CLEAR DIMENSIONS AND EFFECTIVE RING THICKNESS SHOWN IN THIS DRAWING ARE MET.
- 6. REFER TO SHEET A48-CI-303 FOR CONTROL POINTS COORDINATES.
- 7. CONTRACTOR IS REQUIRED TO INSTALL THE SHAFT FINAL LINING UP TO THE UNDERSIDE OF TOP SLAB PRIOR TO EXCAVATING THE A48 REGULATOR STRUCTURE (ORT-A48-RG) AND INSTALLING THE 72-INCH CONSOLIDATION SEWER AND THE 42-INCH VENT PIPE THROUGH THE SHAFT SECANT PILES. IF THE CONTRACTOR ELECTS TO EXCAVATE THE REGULATOR STRUCTURE OR CUT THE PIPE OPENINGS PRIOR TO INSTALLING THE SHAFT PERMANENT LINING, A SUPPORT AND FRAMING DESIGN MUST BE SUBMITTED FOR REVIEW AND APPROVAL BY THE OWNER. THE CONTRACTOR SHALL REMAIN RESPONSIBLE FOR ALL APPLICABLE RE-DESIGNS AND SHALL PROVIDE ADDITIONAL STRUCTURAL REINFORCEMENT OR OTHER MODIFICATIONS NEEDED AT NO ADDITIONAL COST TO THE OWNER.
- 8. CONTRACTOR SHALL PROVIDE THE NECESSARY

 REINFORCEMENT OR CENTRALIZERS TO SUPPORT AND
- MAINTAIN THE TOE GROUTING PVC PIPES AND INCLINOMETER CASINGS IN PLACE WHILE POURING CONCRETE IN SECONDARY

ALLEGHENY COUNTY SANITARY AUTHORITY (ALCOSAN)
OHIO RIVER TUNNEL (ORT)

www.alcosan.org

ORT-ST-300 A48 DROP SHAFT SUPPORT OF EXCAVATION SHEET 1 OF 2

Tile:

ORT-ST-300.dwg


Date:

07/30/2025

Sheet:

130 OF 770

Contract:

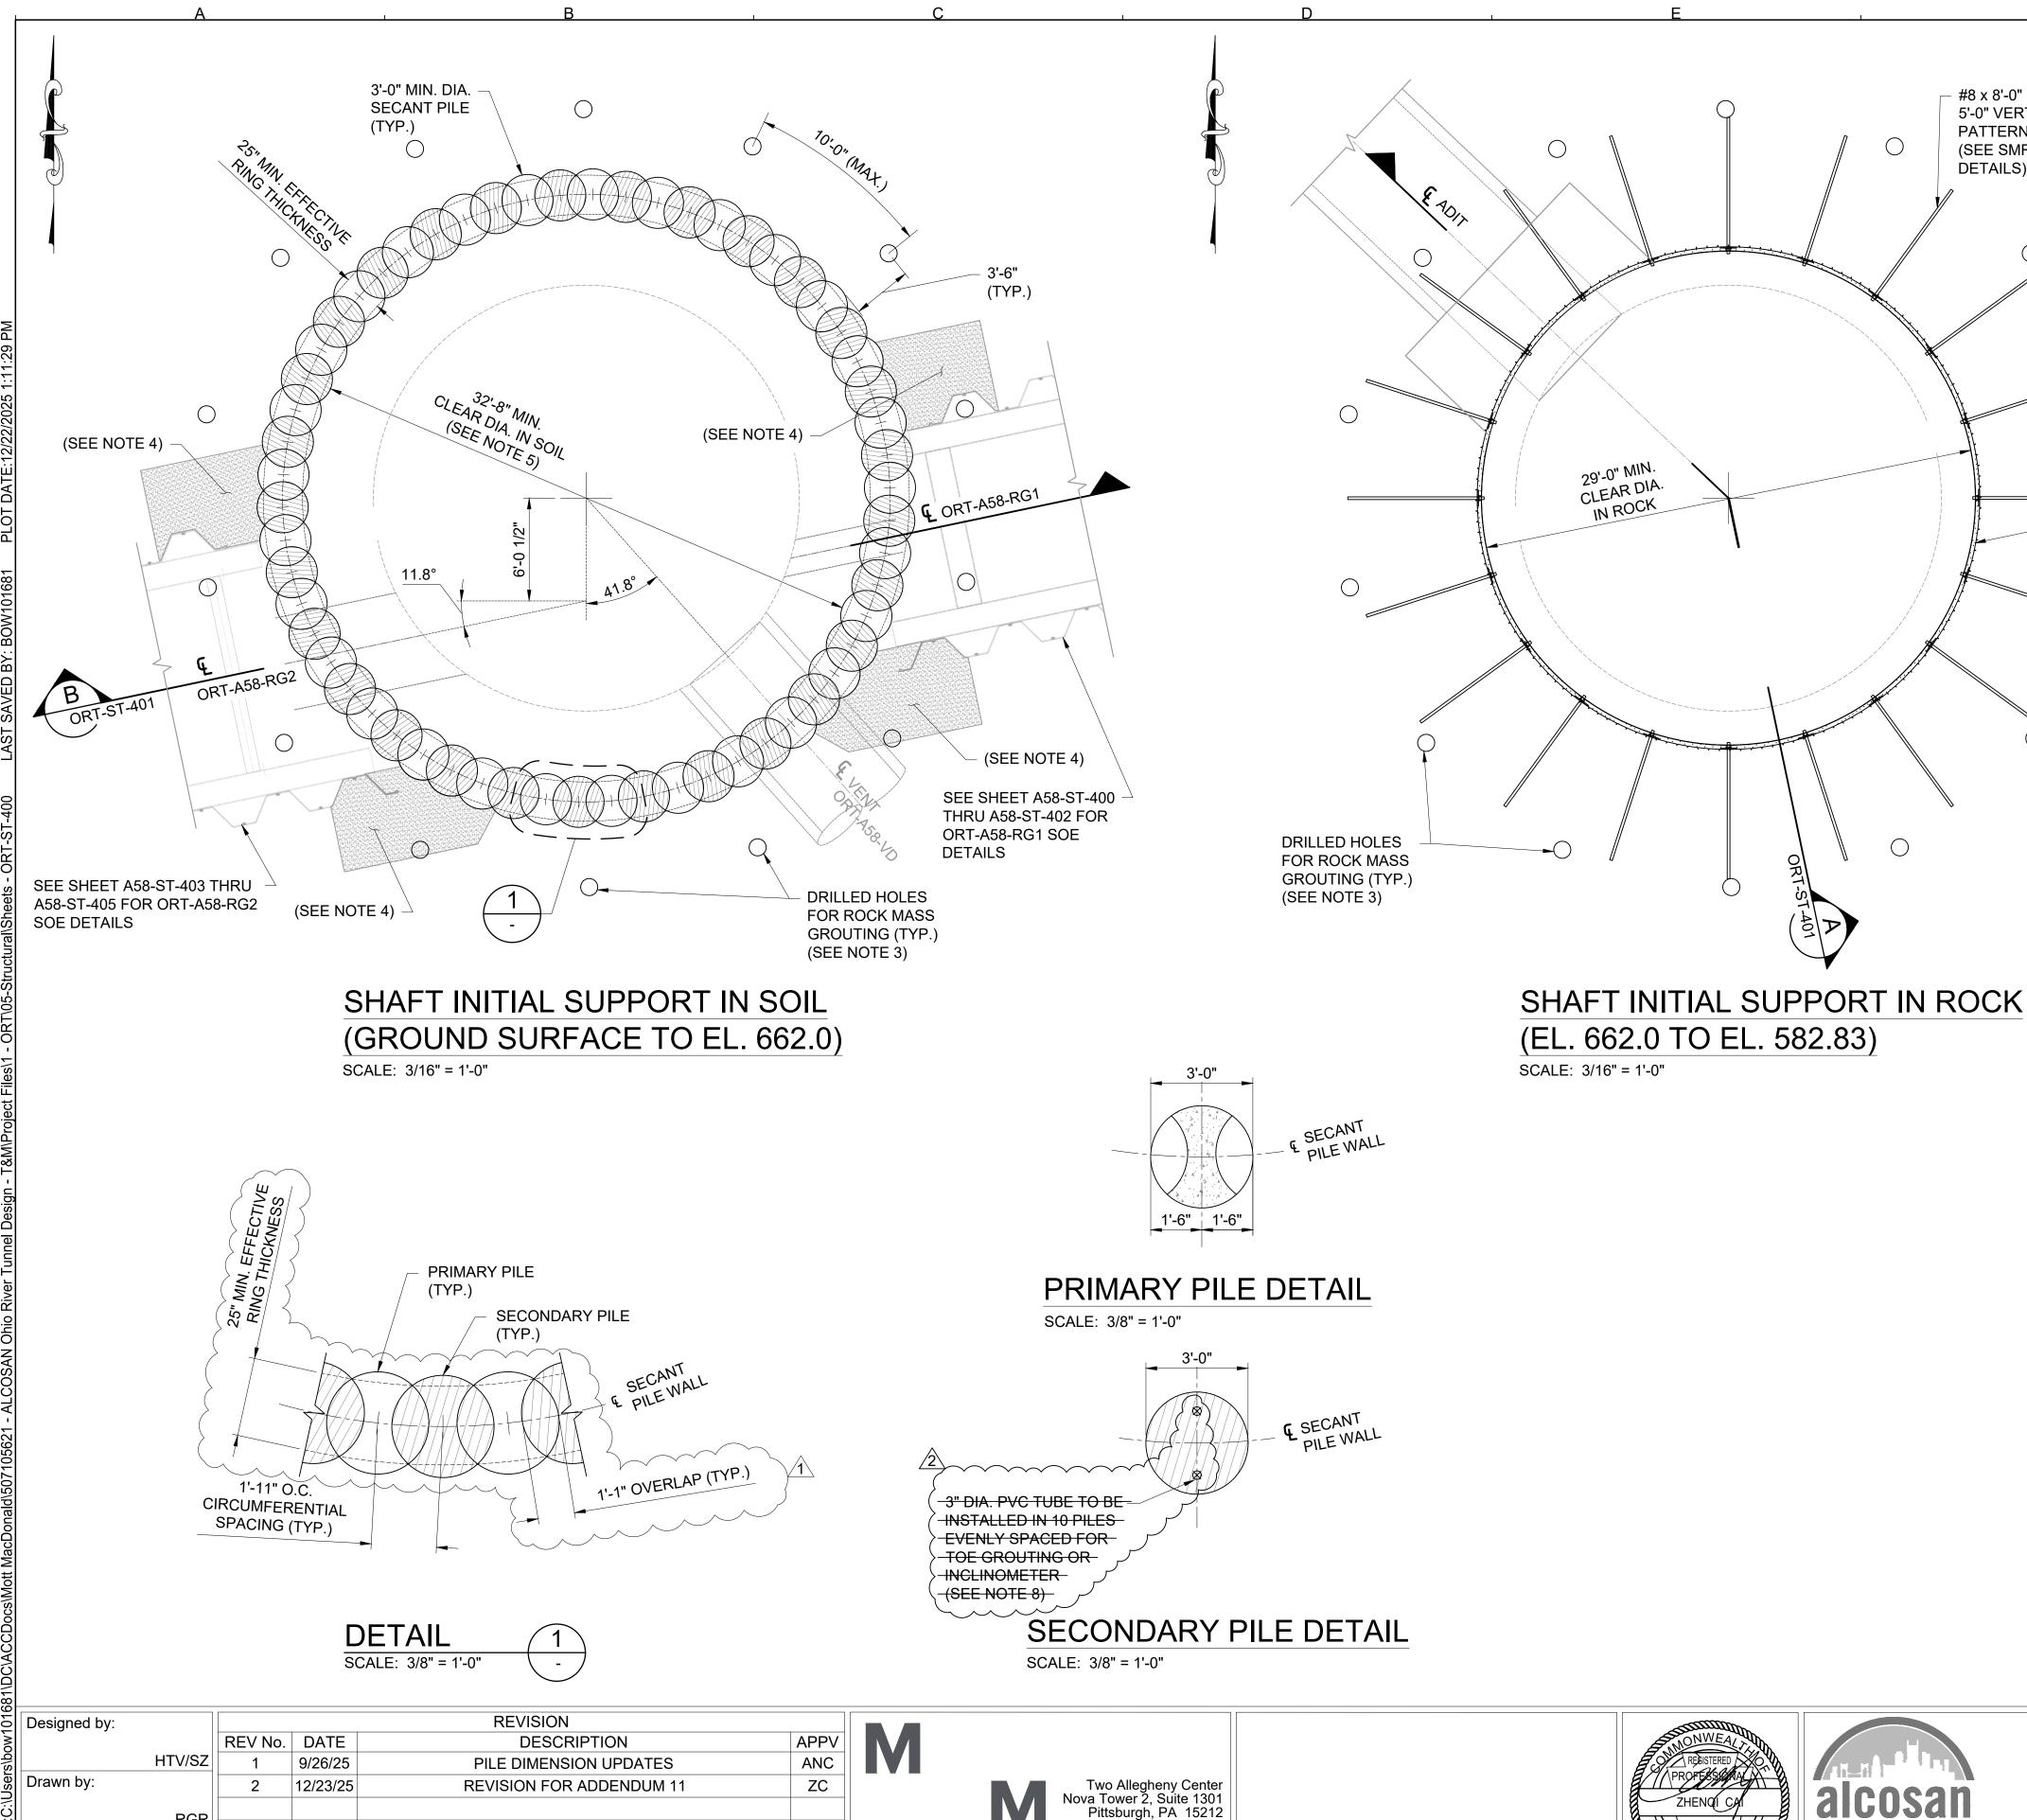

NOTES

#8 x 8'-0" LG. ROCK DOWELS @

3" SHOTCRETE W/ WWF 4" x 4"

- W2.0 x W2.0 W/ WEEP HOLES

5'-0" VERT. & 5'-0" HORIZ.

(SEE SMRT-ST-005 FOR


PATTERN (TYP.)

DETAILS)

- 1. CONTRACTOR SHALL DESIGN AND INSTALL A CONTINUOUS FLOOD PROTECTION WALL AROUND THE ENTIRE PERIMETER OF THE SHAFT, AS REQUIRED PER SPECIFICATION SECTION 31
- 2. SEE GEOTECHNICAL BASELINE REPORT (GBR) FOR SITE SPECIFIC SOIL AND GROUNDWATER CONDITIONS.
- GROUTING IS REQUIRED AROUND THE PERIMETER OF THE SHAFT AND BELOW THE SHAFT BASE TO REDUCE ROCK MASS PERMEABILITY PRIOR TO EXCAVATING THE SHAFT. SPACING OF THE GROUTING HOLES SHALL NOT EXCEED THE DISTANCE SHOWN IN THIS DRAWING. LOCATION OF GROUTING HOLES ARE SHOWN FOR REFERENCE ONLY. CONTRACTOR SHALL DESIGN AND INSTALL THIS GROUND IMPROVEMENT BASED ON THE ANTICIPATED GROUND AND GROUNDWATER CONDITIONS PROVIDED IN THE GBR AND IN ACCORDANCE WITH REQUIREMENTS INCLUDED IN THE TECHNICAL SPECIFICATIONS CONTRACTOR SHALL ALSO PERFORM LOCALIZED GROUTING AS NEEDED DURING ROCK EXCAVATION TO CONTROL ANY RESIDUAL FLOWS THAT ARE NOT SEALED OFF BY THE REQUIRED GROUND IMPROVEMENT.
- 4. FOR GROUND IMPROVEMENT ZONE AT ORT-A58-RG1 AND ORT-A58-RG2 CONNECTIONS, REFER TO SHEETS A58-ST-400 THROUGH A58-ST-411.
- REFER TO TECHNICAL SPECIFICATIONS FOR SECANT PILES INSTALLATION TOLERANCES. CONTRACTOR SHALL INSTALL THE SOE SYSTEMS WITHIN THE REQUIRED INSTALLATION TOLERANCES SO THAT THE CLEAR DIMENSIONS AND EFFECTIVE RING THICKNESS SHOWN IN THIS DRAWING ARE
- REFER TO SHEET A58-CI-403 FOR CONTROL POINTS COORDINATES.
- CONTRACTOR IS REQUIRED TO INSTALL THE SHAFT FINAL LINING UP TO THE UNDERSIDE OF TOP SLAB PRIOR TO EXCAVATING THE A58 REGULATOR STRUCTURES (ORT-A58-RG1 AND A58-RG2) AND INSTALLING THE 3'-0" AND 5'-6" CONNECTIONS, AND THE 60" ID VENT PIPE THROUGH THE SHAFT SECANT PILES. IF THE CONTRACTOR ELECTS TO EXCAVATE THE REGULATOR STRUCTURE OR CUT THE PIPE OPENINGS PRIOR TO INSTALLING THE SHAFT PERMANENT LINING, A SUPPORT AND FRAMING DESIGN MUST BE SUBMITTED FOR REVIEW AND APPROVAL BY THE OWNER. THE CONTRACTOR SHALL REMAIN RESPONSIBLE FOR ALL APPLICABLE RE-DESIGNS AND SHALL PROVIDE ADDITIONAL STRUCTURAL REINFORCEMENT OR OTHER MODIFICATIONS NEEDED AT NO ADDITIONAL COST TO THE OWNER.
- 8. CONTRACTOR SHALL PROVIDE THE NECESSARY REINFORCEMENT OR CENTRALIZERS TO SUPPORT AND MAINTAIN THE TOE GROUTING PVC PIPES AND INCLINOMETER **CASINGS IN PLACE WHILE POURING CONCRETE IN SECONDARY**


RGR Checked by: ANC

Two Allegheny Center Nova Tower 2, Suite 1301 Pittsburgh, PA 15212 (412) 497 - 2900 MOTT **MACDONALD**

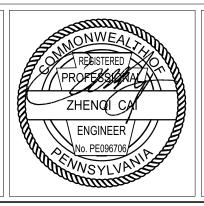

29'-0" MIN.

CLEAR DIA.

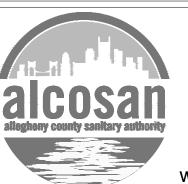

ARLETTA SCOTT WILLIAMS EXECUTIVE DIRECTOR, ALCOSAN

> 3300 PREBLE AVE. PITTSBURGH, PA 15233 (412) 766 - 4810

www.alcosan.org


ALLEGHENY COUNTY SANITARY AUTHORITY (ALCOSAN) OHIO RIVER TUNNEL (ORT)

ORT-ST-400 A58 DROP SHAFT SUPPORT OF EXCAVATION - SHEET 1 OF 2

Contract: ORT-ST-400.dwg 07/30/2025

141 OF 770

Sheet:

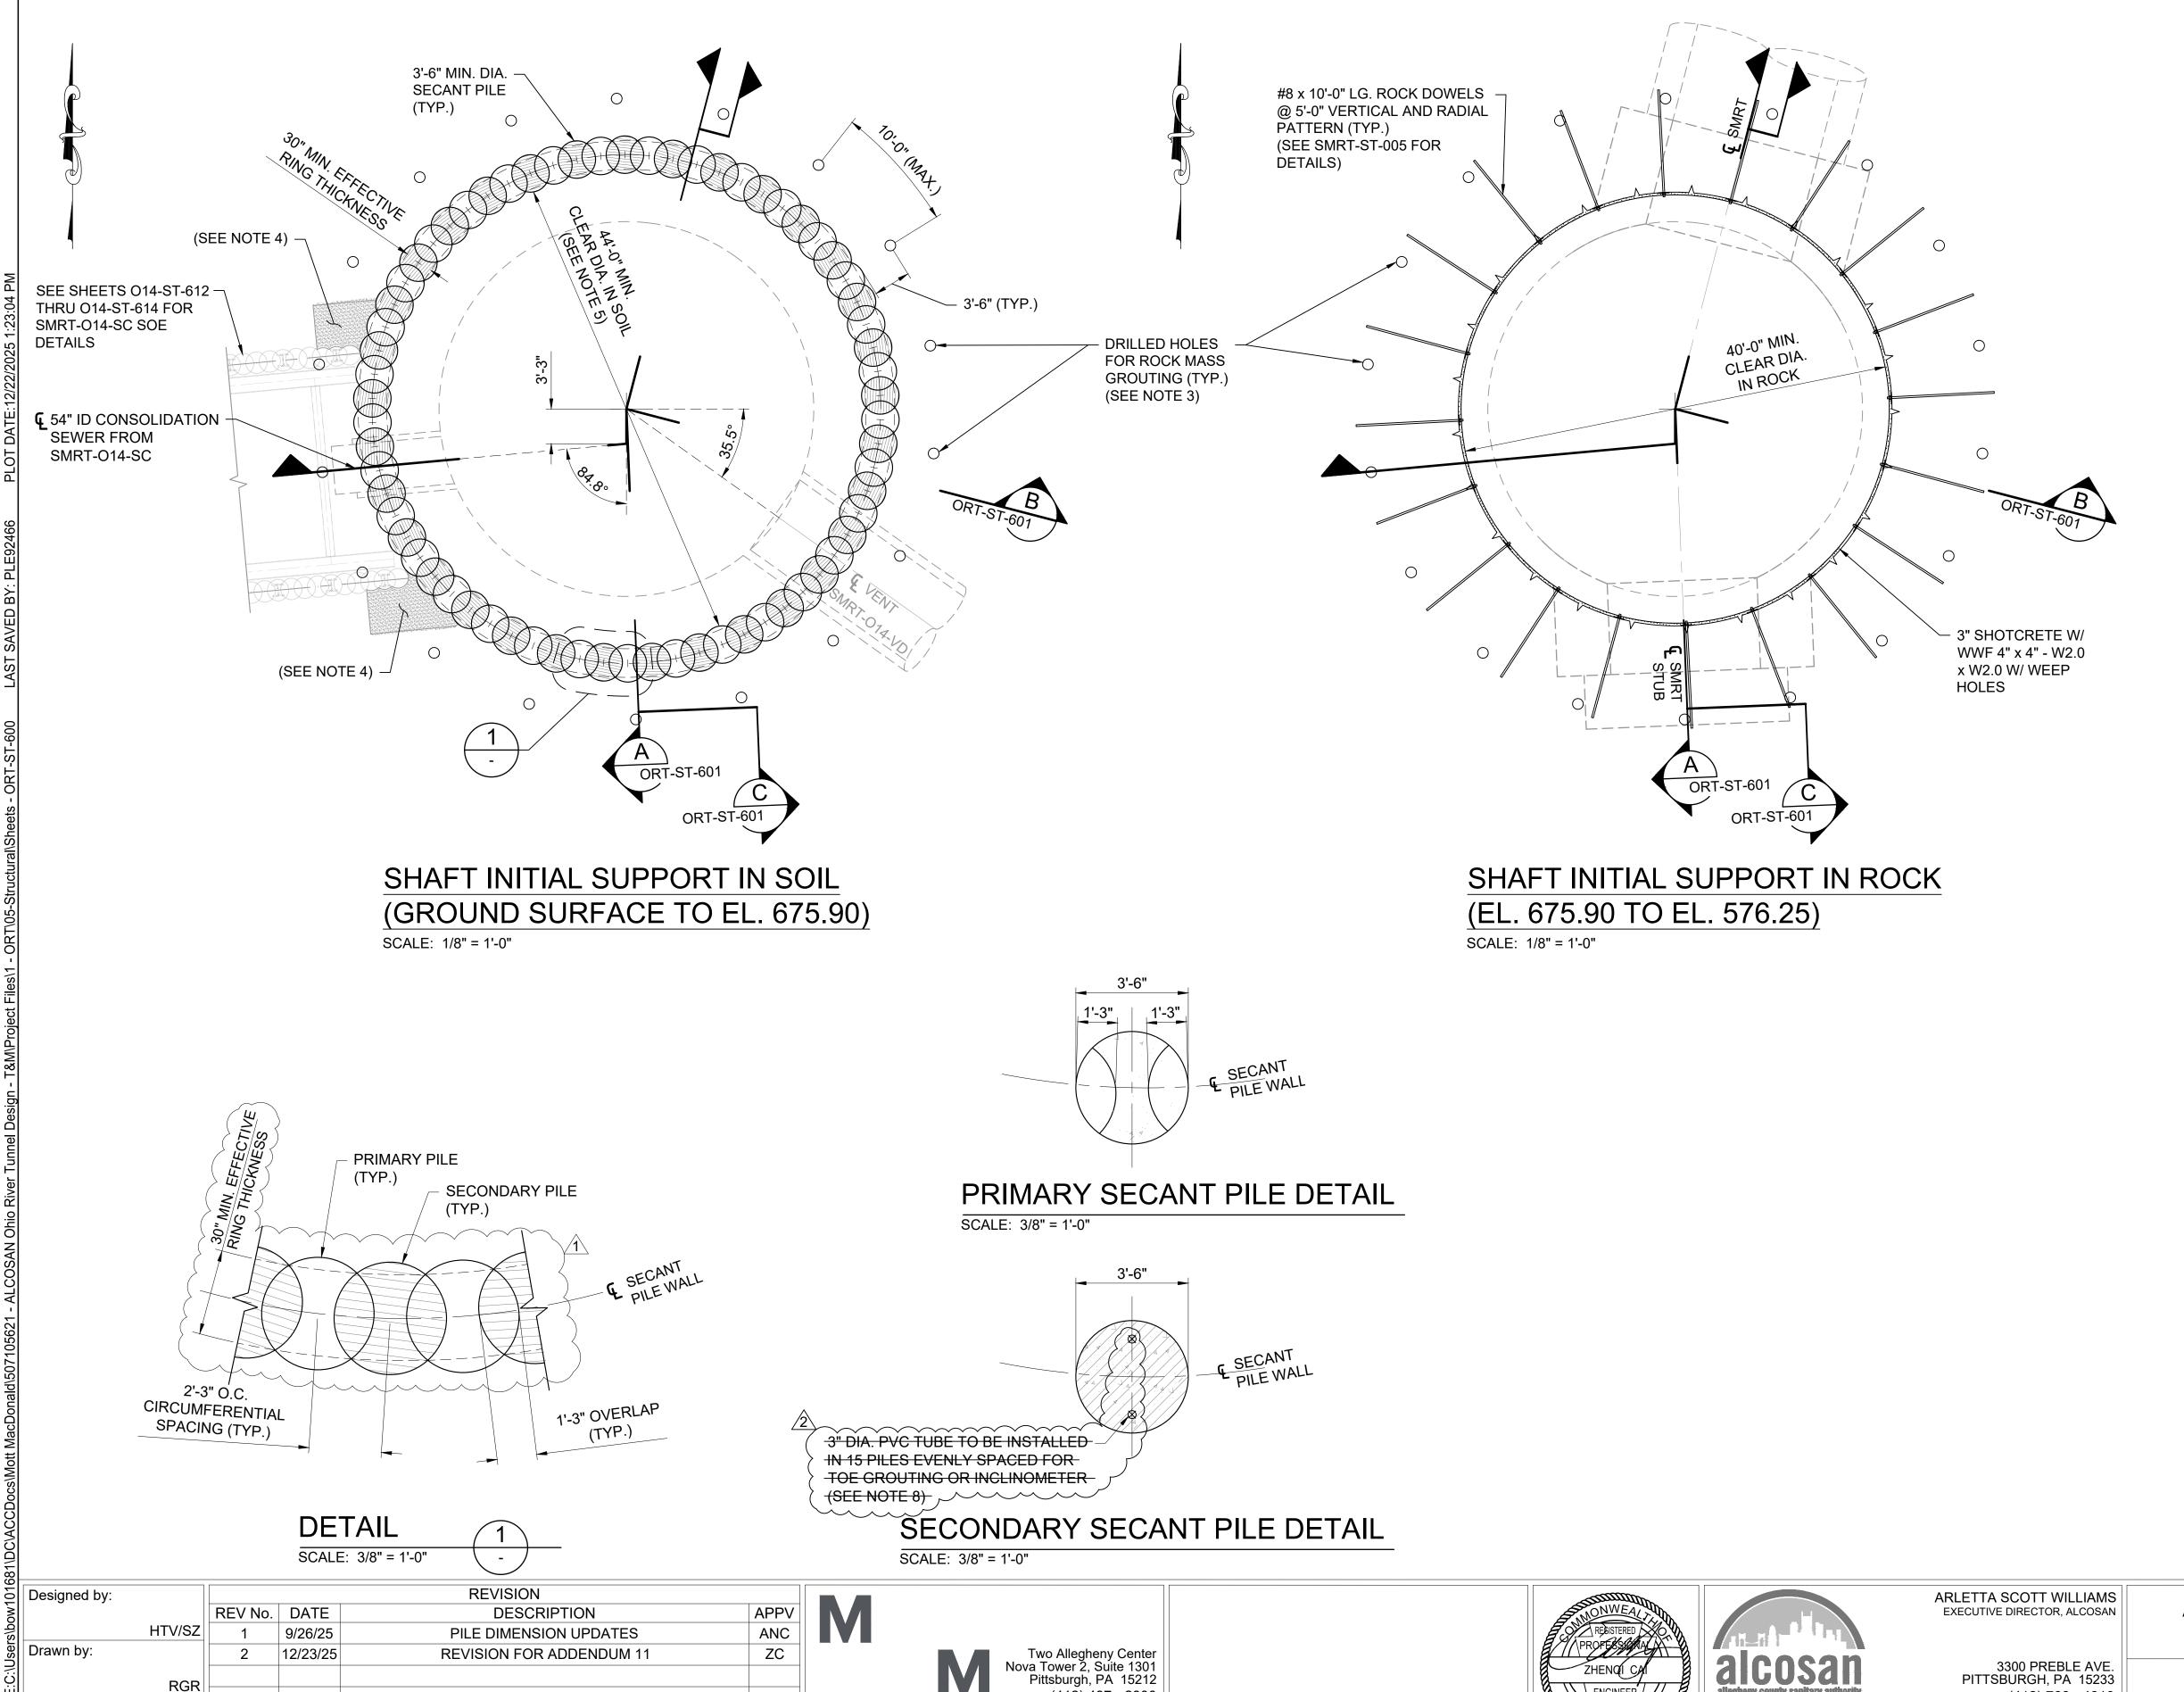

(412) 497 - 2900

MOTT

MACDONALD

Checked by:

ANC

\ \ ENGINEER ,

NOTES

- 1. CONTRACTOR SHALL DESIGN AND INSTALL A CONTINUOUS FLOOD PROTECTION WALL AROUND THE ENTIRE PERIMETER OF THE SHAFT AS REQUIRED PER SPECIFICATION SECTION 31 75 00.
- 2. SEE GEOTECHNICAL BASELINE REPORT (GBR) FOR SITE SPECIFIC SOIL AND GROUNDWATER CONDITIONS.
- 3. GROUTING IS REQUIRED AROUND THE PERIMETER OF THE SHAFT AND BELOW THE SHAFT BASE TO REDUCE ROCK MASS PERMEABILITY PRIOR TO EXCAVATING THE SHAFT. SPACING OF THE GROUTING HOLES SHALL NOT EXCEED THE DISTANCE SHOWN IN THIS DRAWING. LOCATION OF GROUTING HOLES ARE SHOWN FOR REFERENCE ONLY. CONTRACTOR SHALL DESIGN AND INSTALL THIS GROUND IMPROVEMENT BASED ON THE ANTICIPATED GROUND AND GROUNDWATER CONDITIONS PROVIDED IN THE GBR AND IN ACCORDANCE WITH REQUIREMENTS INCLUDED IN THE TECHNICAL SPECIFICATIONS. CONTRACTOR SHALL ALSO PERFORM LOCALIZED GROUTING AS NEEDED DURING ROCK EXCAVATION TO CONTROL ANY RESIDUAL FLOWS THAT ARE NOT SEALED OFF BY THE REQUIRED GROUND IMPROVEMENT.
- 4. FOR GROUND IMPROVEMENT ZONE AT SMRT-O14-SC CONNECTION. REFER TO SHEETS O14-ST-612 & O14-ST-614.
- 5. REFER TO TECHNICAL SPECIFICATIONS FOR SECANT PILES INSTALLATION TOLERANCES. CONTRACTOR SHALL INSTALL THE SOE SYSTEMS WITHIN THE REQUIRED INSTALLATION TOLERANCES SO THAT THE CLEAR DIMENSIONS AND EFFECTIVE RING THICKNESS SHOWN IN THIS DRAWING ARE MET.
- 6. REFER TO SHEET 014-CI-604 FOR CONTROL POINTS COORDINATES.
- 7. CONTRACTOR IS REQUIRED TO INSTALL THE SHAFT FINAL LINING UP TO THE UNDERSIDE OF TOP SLAB PRIOR TO EXCAVATING THE O14-SC STRUCTURE AND INSTALLING THE 54" ID CONSOLIDATION SEWER, AND THE 96" ID VENT PIPE THROUGH THE SHAFT SECANT PILES. IF THE CONTRACTOR ELECTS TO EXCAVATE THE REGULATOR STRUCTURE OR CUT THE PIPE OPENING PRIOR TO INSTALLING THE SHAFT PERMANENT LINING, A SUPPORT AND FRAMING DESIGN MUST BE SUBMITTED FOR REVIEW AND APPROVAL BY THE OWNER. THE CONTRACTOR SHALL REMAIN RESPONSIBLE FOR ALL APPLICABLE RE-DESIGNS AND SHALL PROVIDE ADDITIONAL STRUCTURAL REINFORCEMENT OR OTHER MODIFICATIONS NEEDED AT NO ADDITIONAL COST TO THE

8. CONTRACTOR SHALL PROVIDE THE NECESSARY

REINFORCEMENT OR CENTRALIZERS TO SUPPORT AND MAINTAIN

THE TOE GROUTING PVC PIPES AND INCLINOMETER CASINGS IN

PLACE WHILE POURING CONCRETE IN SECONDARY PILES.

ALLEGHENY COUNTY SANITARY AUTHORITY (ALCOSAN)
OHIO RIVER TUNNEL (ORT)


(412) 766 - 4810

www.alcosan.org

ORT-ST-600 O14 DROP SHAFT SUPPORT OF EXCAVATION - SHEET 1 OF 2

Contract:

159 OF 770

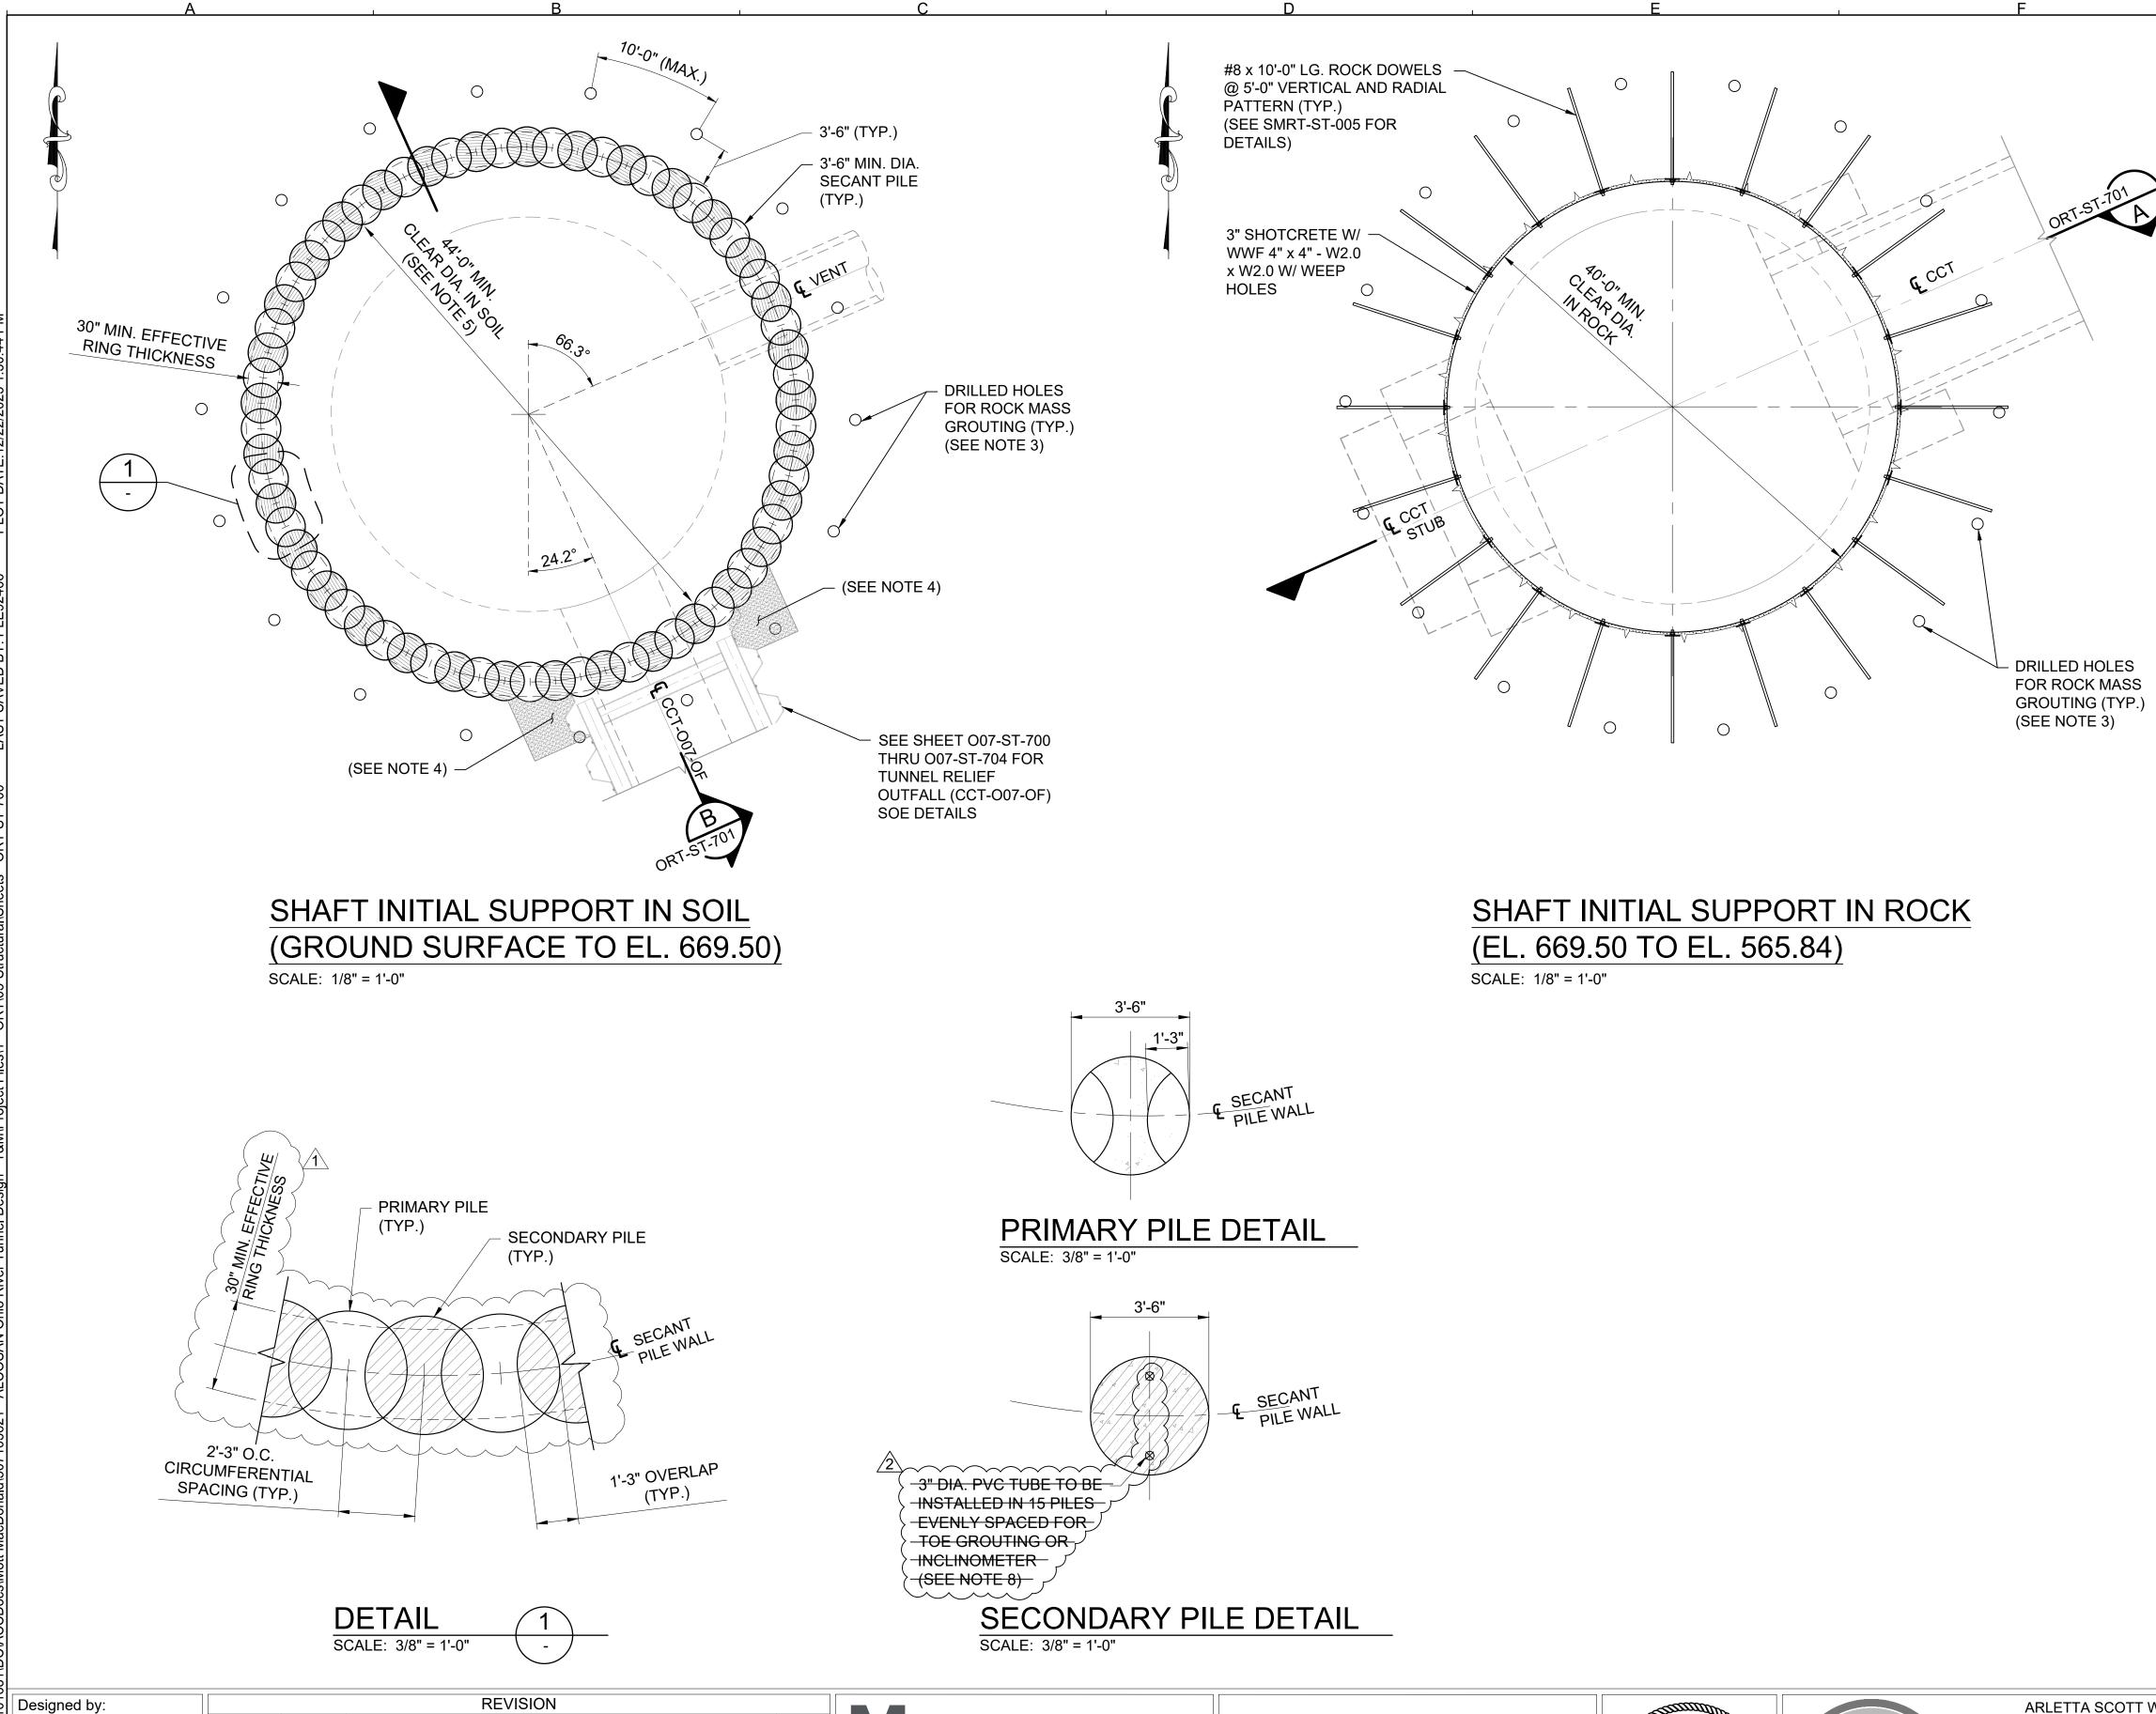

Two Allegheny Center Nova Tower 2, Suite 1301 Pittsburgh, PA 15212

(412) 497 - 2900

APPV

ANC

ZC

MOTT

MACDONALD

DESCRIPTION

PILE DIMENSION UPDATES

REVISION FOR ADDENDUM 11

REV No. DATE

ANC

Drawn by:

Checked by:


9/26/25

12/23/25

NOTES

- 1. CONTRACTOR SHALL DESIGN AND INSTALL A CONTINUOUS FLOOD PROTECTION WALL AROUND THE ENTIRE PERIMETER OF THE SHAFT AS REQUIRED PER SPECIFICATION SECTION 31 75 00.
- 2. SEE GEOTECHNICAL BASELINE REPORT (GBR) FOR SITE SPECIFIC SOIL AND GROUNDWATER CONDITIONS.
- 3. GROUTING IS REQUIRED AROUND THE PERIMETER OF THE SHAFT AND BELOW THE SHAFT BASE TO REDUCE ROCK MASS PERMEABILITY PRIOR TO EXCAVATING THE SHAFT. SPACING OF THE GROUTING HOLES SHALL NOT EXCEED THE DISTANCE SHOWN IN THIS DRAWING. LOCATION OF GROUTING HOLES ARE SHOWN FOR REFERENCE ONLY. CONTRACTOR SHALL DESIGN AND INSTALL THIS GROUND IMPROVEMENT BASED ON THE ANTICIPATED GROUND AND GROUNDWATER CONDITIONS PROVIDED IN THE GBR AND IN ACCORDANCE WITH REQUIREMENTS INCLUDED IN THE TECHNICAL SPECIFICATIONS. CONTRACTOR SHALL ALSO PERFORM LOCALIZED GROUTING AS NEEDED DURING ROCK EXCAVATION TO CONTROL ANY RESIDUAL FLOWS THAT ARE NOT SEALED OFF BY THE REQUIRED GROUND IMPROVEMENT.
- 4. FOR GROUND IMPROVEMENT ZONE AT TUNNEL RELIEF OUTFALL CONNECTION, REFER TO SHEETS 007-ST-700 THROUGH 007-ST-704.
- 5. REFER TO TECHNICAL SPECIFICATIONS FOR SECANT PILES INSTALLATION TOLERANCES. CONTRACTOR SHALL INSTALL THE SOE SYSTEMS WITHIN THE REQUIRED INSTALLATION TOLERANCES SO THAT THE CLEAR DIMENSIONS AND EFFECTIVE RING THICKNESS SHOWN IN THIS DRAWING ARE MET.
- 6. REFER TO SHEET 007-CI-703 FOR CONTROL POINTS COORDINATES.
- 7. CONTRACTOR IS REQUIRED TO INSTALL THE SHAFT FINAL LINING UP TO THE UNDERSIDE OF TOP SLAB PRIOR TO EXCAVATING THE O07 OUTFALL (CCT-O07-OF) AND INSTALLING THE 9'-0" x 9'-0" TUNNEL RELIEF OUTFALL, AND THE 66" ID VENT PIPE THROUGH THE SHAFT SECANT PILES. IF THE CONTRACTOR ELECTS TO EXCAVATE THE 007-OF OR CUT THE PIPE OPENINGS PRIOR TO INSTALLING THE SHAFT PERMANENT LINING, A SUPPORT AND FRAMING DESIGN MUST BE SUBMITTED FOR REVIEW AND APPROVAL BY THE OWNER. THE CONTRACTOR SHALL REMAIN RESPONSIBLE FOR ALL APPLICABLE RE-DESIGNS AND SHALL PROVIDE ADDITIONAL STRUCTURAL REINFORCEMENT OR OTHER MODIFICATIONS NEEDED AT NO ADDITIONAL COST TO THE



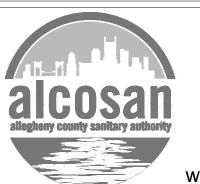

ARLETTA SCOTT WILLIAMS EXECUTIVE DIRECTOR, ALCOSAN

3300 PREBLE AVE. PITTSBURGH, PA 15233 (412) 766 - 4810

(412) 766 - 4810 O07 ACCESS SHAFT

www.alcosan.org SUPPORT OF EXCAVATION - SHEET 1 OF 2

ALLEGHENY COUNTY SANITARY AUTHORITY (ALCOSAN)
OHIO RIVER TUNNEL (ORT)

ORT-ST-700.dwg

ORT-ST-700.dwg

ACCESS SHAFT


EXCAVATION - SHEET 1 OF 2

ORT-ST-700.dwg

Date:

07/30/2025

Sheet:
169 OF 770

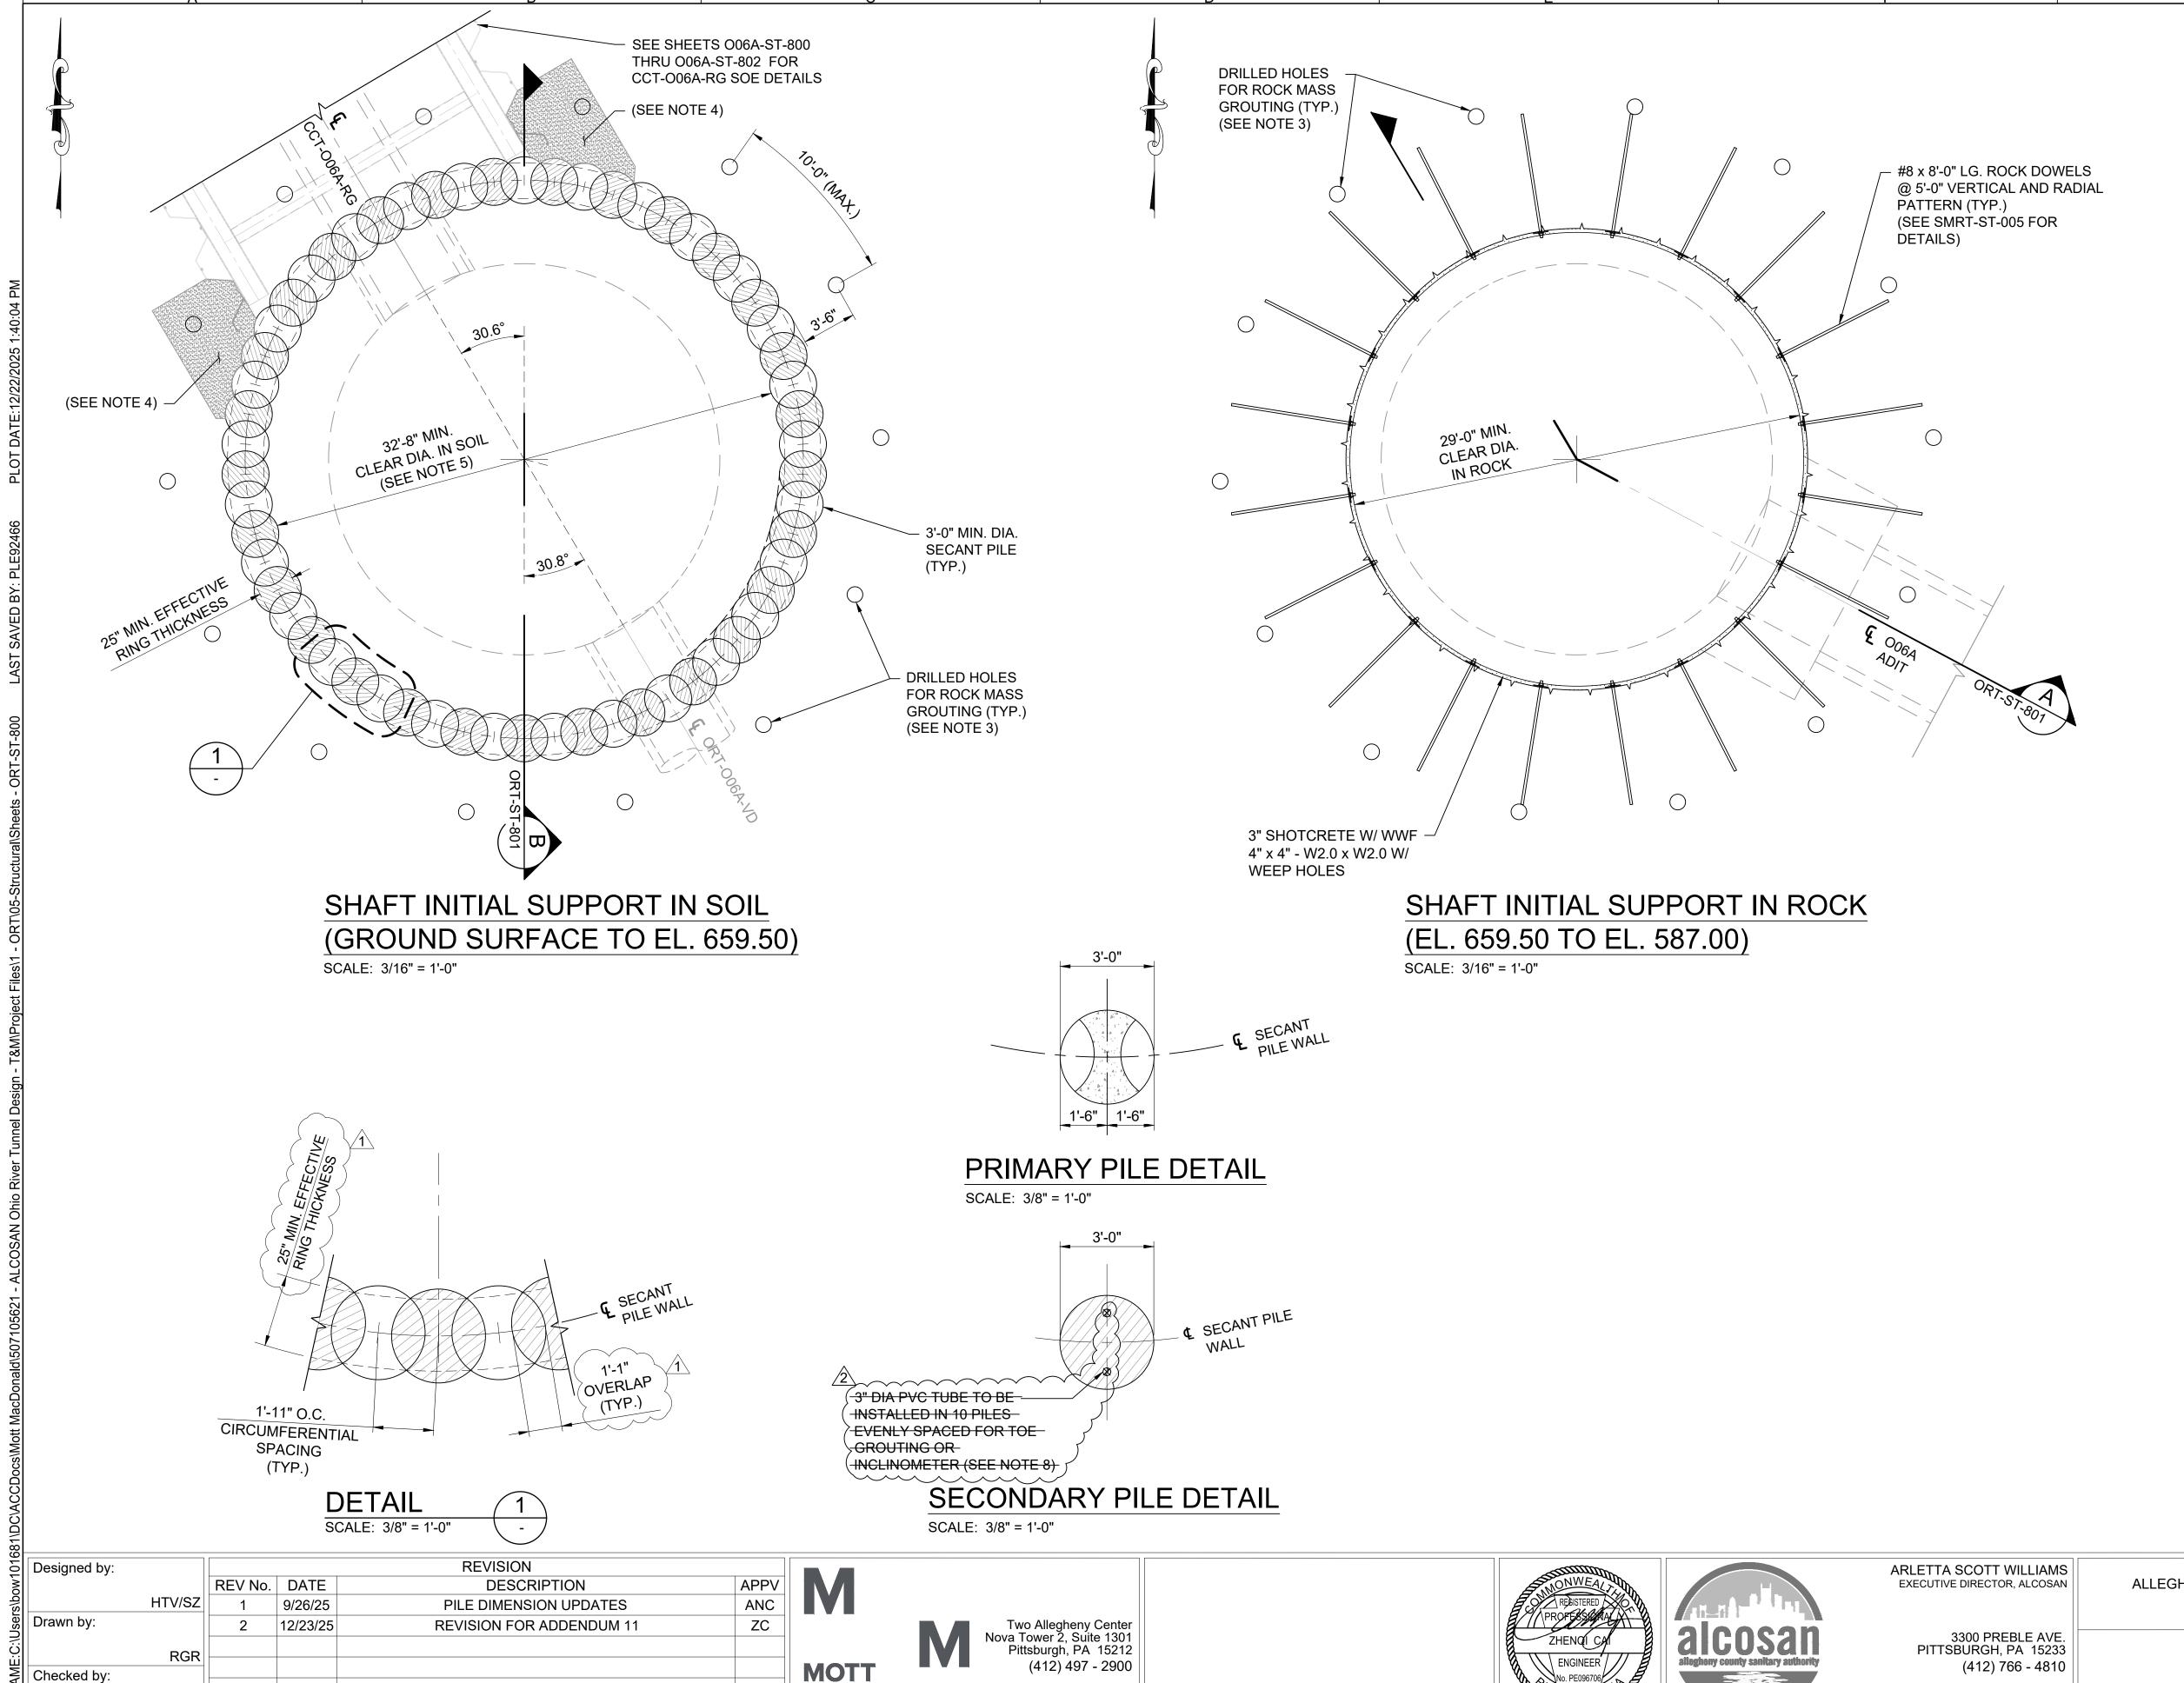

MACDONALD

ANC

NOTES

- 1. CONTRACTOR SHALL DESIGN AND INSTALL A CONTINUOUS FLOOD PROTECTION WALL AROUND THE ENTIRE PERIMETER OF THE SHAFT AS REQUIRED PER SPECIFICATIONS SECTION 31 75 00.
- 2. SEE GEOTECHNICAL BASELINE REPORT (GBR) FOR SITE SPECIFIC SOIL AND GROUNDWATER CONDITIONS.
- 3. GROUTING IS REQUIRED AROUND THE PERIMETER OF THE SHAFT AND BELOW THE SHAFT BASE TO REDUCE ROCK MASS PERMEABILITY PRIOR TO EXCAVATING THE SHAFT. SPACING OF THE GROUTING HOLES SHALL NOT EXCEED THE DISTANCE SHOWN IN THIS DRAWING. LOCATION OF GROUTING HOLES ARE SHOWN FOR REFERENCE ONLY. CONTRACTOR SHALL DESIGN AND INSTALL THIS GROUND IMPROVEMENT BASED ON THE ANTICIPATED GROUND AND GROUNDWATER CONDITIONS PROVIDED IN THE GBR AND IN ACCORDANCE WITH REQUIREMENTS INCLUDED IN THE TECHNICAL SPECIFICATIONS CONTRACTOR SHALL ALSO PERFORM LOCALIZED GROUTING AS NEEDED DURING ROCK EXCAVATION TO CONTROL ANY RESIDUAL FLOWS THAT ARE NOT SEALED OFF BY THE REQUIRED GROUND IMPROVEMENT.
- 4. FOR GROUND IMPROVEMENT ZONE AT CCT-006A-RG CONNECTION, REFER TO SHEETS O06A-ST-800 THROUGH O06A-ST-805.
- REFER TO TECHNICAL SPECIFICATIONS FOR SECANT PILES INSTALLATION TOLERANCES. CONTRACTOR SHALL INSTALL THE SOE SYSTEMS WITHIN THE REQUIRED INSTALLATION TOLERANCES SO THAT THE CLEAR DIMENSIONS AND EFFECTIVE RING THICKNESS SHOWN ON THIS SHEET ARE MET.
- REFER TO SHEET O06A-CI-803 FOR CONTROL POINTS COORDINATES.
- CONTRACTOR IS REQUIRED TO INSTALL THE SHAFT FINAL LINING UP TO THE UNDERSIDE OF THE SLAB PRIOR TO EXCAVATING THE O06A REGULATOR STRUCTURE (CCT-O06A-RG) AND INSTALLING THE 60" ID CONSOLIDATION SEWER, AND THE 54" ID VENT PIPE THROUGH THE SHAFT SECANT PILES. IF THE CONTRACTOR ELECTS TO EXCAVATE THE REGULATOR STRUCTURE OR CUT THE PIPE OPENING PRIOR TO INSTALLING THE SHAFT PERMANENT LINING, A SUPPORT AND FRAMING DESIGN MUST BE SUBMITTED FOR REVIEW AND APPROVAL BY THE OWNER. THE CONTRACTOR SHALL REMAIN RESPONSIBLE FOR ALL APPLICABLE RE-DESIGNS AND SHALL PROVIDE ADDITIONAL STRUCTURAL REINFORCEMENT

OR CENTRALIZERS TO SUPPORT AND MAINTAIN THE TOE GROUTING PVC PIPES AND INCLINOMETER CASINGS IN PLACE - WHILE POURING CONCRETE IN SECONDARY PILES.

ALLEGHENY COUNTY SANITARY AUTHORITY (ALCOSAN) OHIO RIVER TUNNEL (ORT)

www.alcosan.org

O06A DROP SHAFT SUPPORT OF EXCAVATION - SHEET 1 OF 2

ORT-ST-800 Sheet:

Contract:

ORT-ST-800.dwg

07/30/2025

179 OF 770

File: